

OOS

Qwest

BSW SKETCH FORM

RG41 - 0087

Revised 6/1/09

NPA / NNX (Wire Center): 320-632

Area Code 320
FAX TO : 1-877-410-2631


MO1100297

NECTAS # _____

TIM

Date Submitted: 3-8-11

Install (Repair) Preprovisioning (Please Circle One of the Above)	Customer Name: <u>James Houdek</u>
Job ID _____	Address: <u>10451 140th St</u> City: <u>Little Falls</u>
TN <u>320-632-3140</u>	911 Address: _____
1. Held For BSW <input type="checkbox"/>	Phone: <u>320-632-3140</u> CBR: <u>320-632-7140</u>
2. Held - cannot locate ENCAP <input type="checkbox"/>	Hudson / King (circle one) _____ Year _____
3. OOS - Can not lay temp <input checked="" type="checkbox"/>	County <u>Morrison</u> Section <u>27</u> Range <u>30w</u> Township <u>T128 N</u>
4. Held for F1-F2, also need BSW <input type="checkbox"/>	Quarter Section (Circle one) <u>NW</u> NE - SW - SE
5. Temp Placed - (See Sketch Below) <input type="checkbox"/>	Submitted By _____
6. Found Temp - Same Job <input type="checkbox"/>	Name: <u>N. Jensen</u> EC: <u>310</u> Pgr/Cell: <u>320-333-3496</u>
- Other Location <input type="checkbox"/>	Supervisor: <u>Howard</u>
7. Add Line <input type="checkbox"/>	Office #: <u>320-255-8575</u> Pager: <u>320255-8575</u>
	Customer was contacted: <input checked="" type="checkbox"/> N <input checked="" type="checkbox"/> Verbal <input type="checkbox"/> Card
Terminal Address: <u>1064</u> CA <u>9437-27</u> PR <u>122</u> BP <u>7</u>	
Cross Street: <u>100th Ave</u> Total BSW Footage: <u>1500ft</u> Type of Wire: <u>3pr</u> (3pr/6pr)	
L-INFO: <u>L</u> <u>F</u> <u>S</u> <u>7</u> <u>C</u> <u>A</u> <u>3</u> <u>5</u> <u>P</u> <u>c</u>	
<small>L,E F,R,S N,E,S,W 1-2,3-4-5-6-7 W,S,P,O,C G,A,M,N 3/6 S,N P,N C</small>	

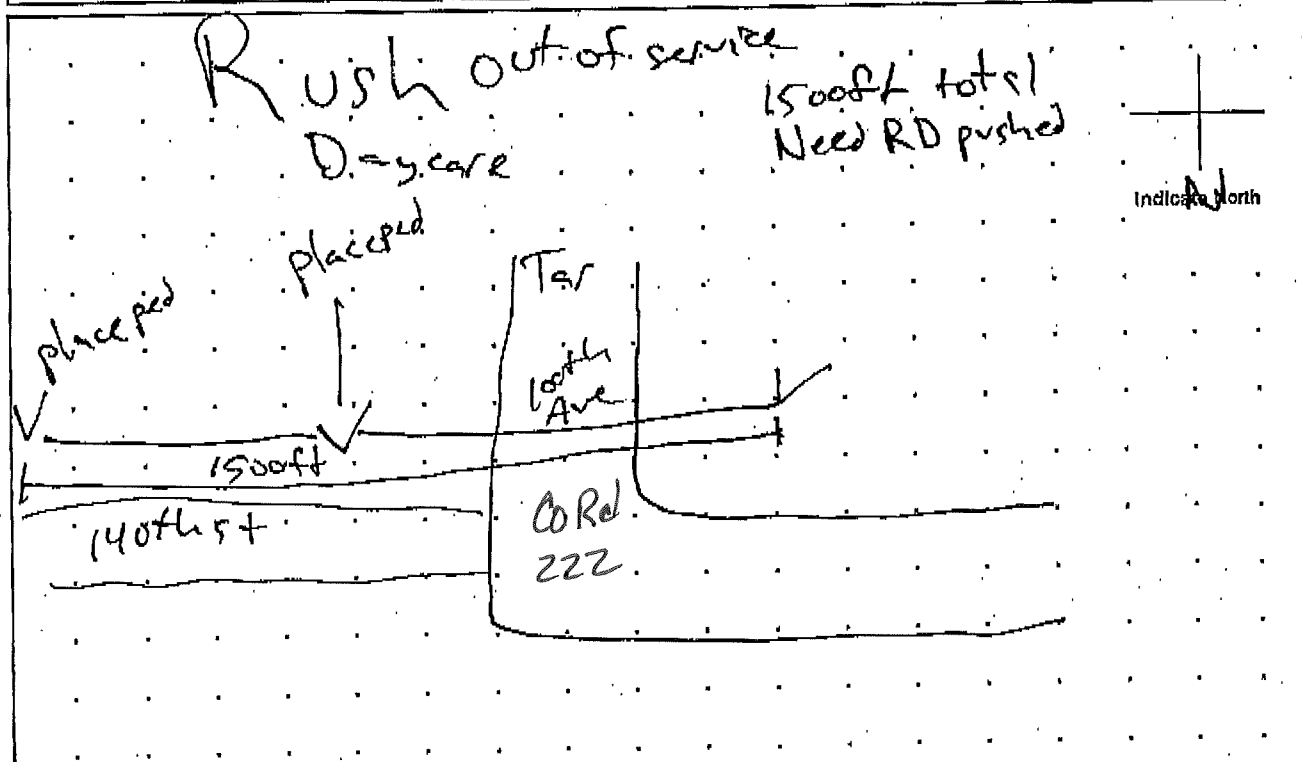

Any work in Right-of-Way requires a permit, fill out below

Distance of terminal to centerline 60ft Distance to nearest intersection 1500ft

Distance of bury in Right-of-Way 1500ft Mile marker if State permit needed _____

Road Push Permit Required Hand Dig (Note: Hand Dig Must be 12")