


MORRISON COUNTY  
T129N R31W  
SECTION 16 SW CORNER  
SECTION 17 SE CORNER



MORRISON COUNTY  
T129N R31W  
SECTION 16 SW CORNER  
SECTION 17 SE CORNER

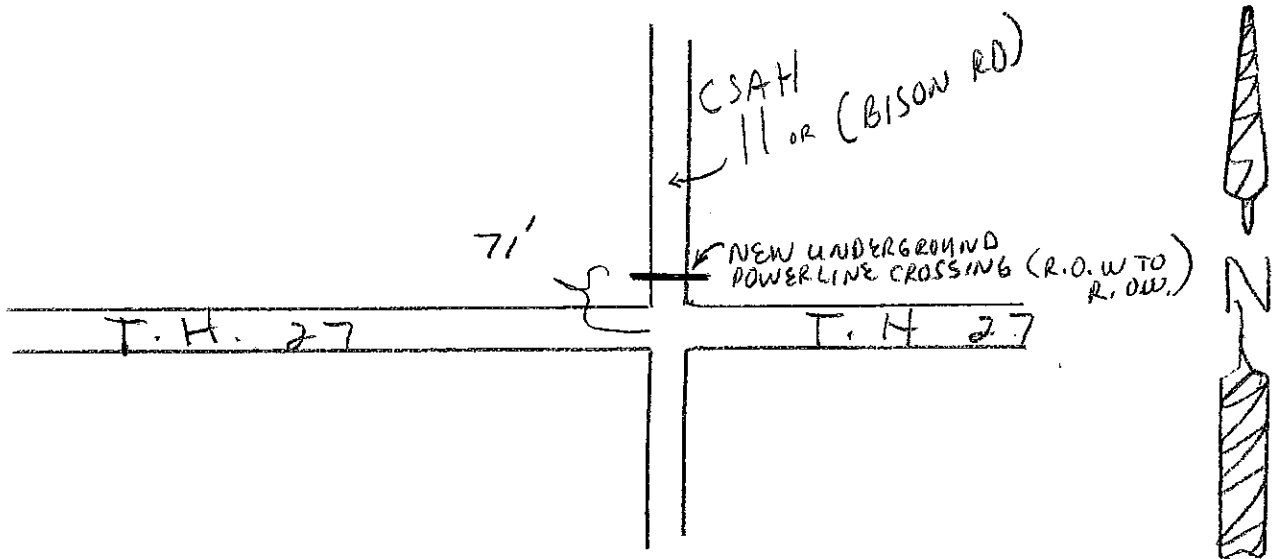