


DISTANCE FROM E ROAD
CTC
 SEE NOTATION
 STAKED BY: [Signature] DATE: 7/11
 PROJECT: MN537-2012
 EXCHANGE: LINCOLN
 REV. [] AS BUILT BY: [] DATE: []
 TWP 133 N ROUTE 2A
 RNG 31 W
 SEC. 33 34 SHEET 6 OF 7
 CO. MORRISON SERVICE AREA LINCOLN



FAIR PAINTS FARM

TURKEY BAY

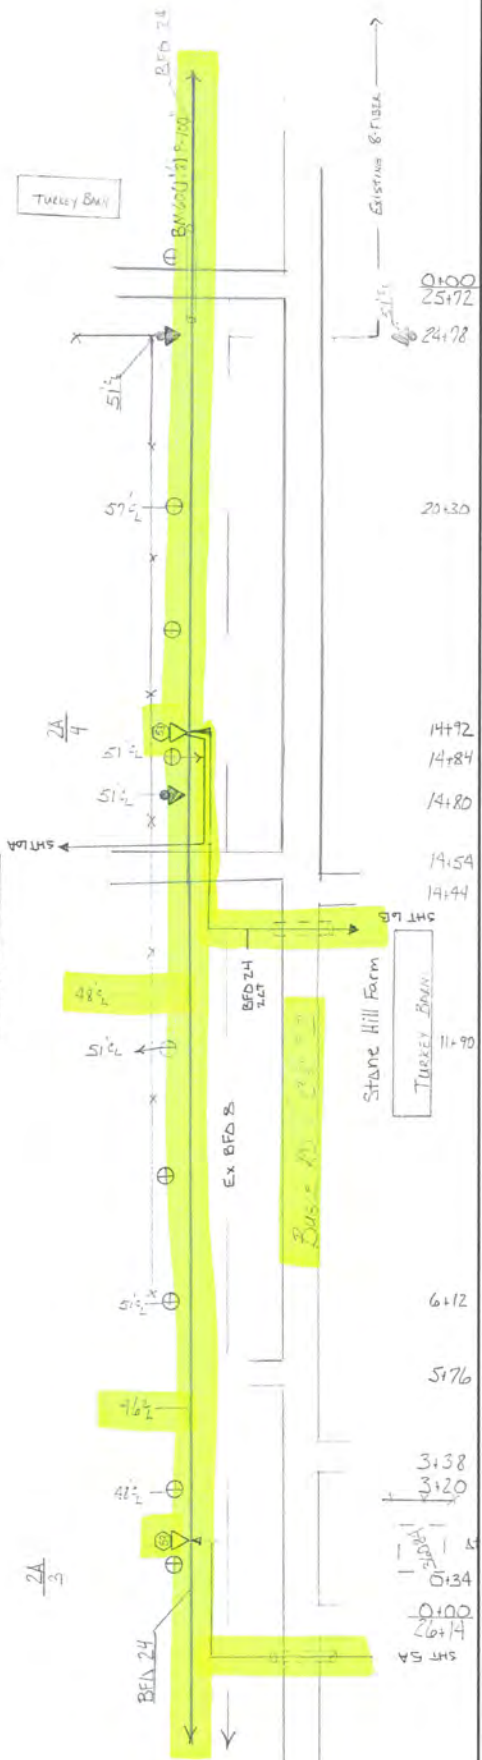

HOUSING NO.	BA	BDO	BFO	BH	BM	HBF	HO	NID	SUB NO.	SE	UD	UO
4		1 (S)	24		7 (S)		1	3		B		
		1	1547		1		3	1	4th Area 36425	530		
		1	1547		1		3	1		530		

DISTANCE FROM E ROAD
SEE NOTATION

STAKED BY: *RE* DATE: *7/11*

REV. DATE: _____


AS BUILT BY: _____ DATE: _____

PROJECT: MN537-2012
EXCHANGE: LINCOLN
TOWNSHIP: SCANDIA VALLEY

TWP. *132* N. ROUTE: *2A*

RNG. *31* W. SHEET: *4* OF *7*

SEC. *43* CO. MORRISON SERVICE AREA: LINCOLN

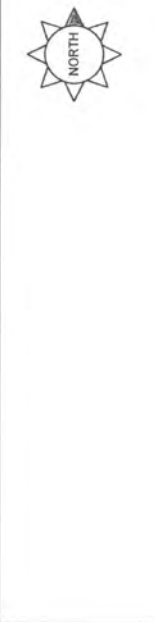

SEE SHEET 4A

SEE SHEET 3A

0+00
17+82

17+20
17+16
17+10

11+42

5+90
5+72

0+30
0+24

0+00
13+24

HOUSING NO.	BA		BDO		BFO		BH	BM		HBF	HO	NID	SUB NO.	SE	UD	UO
2		4 (515)						2 (515)	53		1					
		1						1	1		2					
								1	1		2					

CTC

PROJECT: MN537-2012
EXCHANGE: LINCOLN
TOWNSHIP: MORRISON

DATE: 7/11
REV: 1

STAKED BY: AE

AS BUILT BY:

ROUTE: 2A
SHEET: 3 OF 7
SERVICE AREA: LINCOLN

TWP: 132 N
RNG: 31 W
SEC: 4 3 10



ON HOUSING	BA	BDO	BFO	BH	BM	16D (1% P)	HBF	HO	NID	SUB NO.	SE	UD	UO	UD
Pen 7		4 (510)	24 (24 1/2 72) D		2 Z1 (510/8) (Pen 7)	53	16D (1%) P	1				(14+12) 5	850	7
1		1	578D 114D		1	4	16D	336				50	1	
		1	578D 114D		1	4	16D	338				50	1	


CTC

MIN537-2012
LINCOLN
Scandia Valley


TWP 137 N
RNG 31 W
SEC 11 11
SHEET 2 OF 11
ROUTE 20
CO. MORRISON
SERVICE AREA: LINCOLN

DISTANCE FROM C ROAD
SEE NOTATION
STAKED BY: EDB
DATE: 7-26-11
REV. G
AS BUILT BY: G
DATE: G

PROJECT: LINCOLN
EXCHANGE:
TOWNSHIP: Scandia Valley

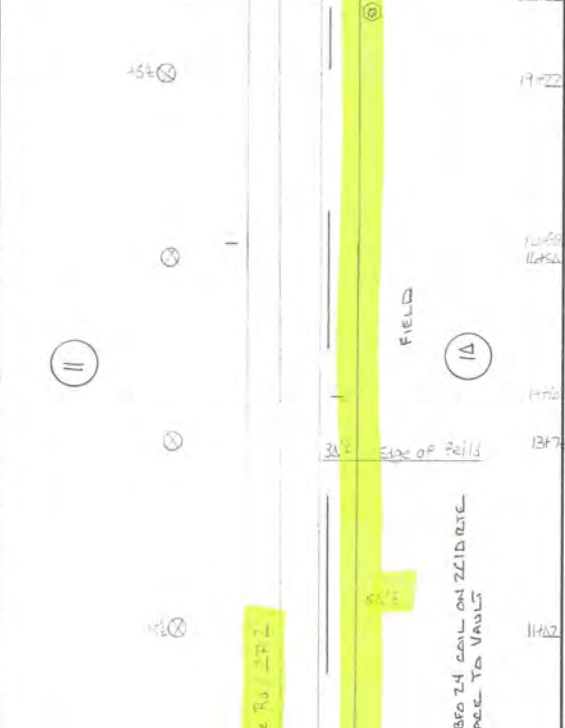


HOUSING NO.	BA	BDO	BFO	BH	BM	BHFB	HO	NID	SUB NO.	SE	UD	UD	WL
1		4 (516)	24	(418 ±) Post	F(36x46) x 36x37 (56x18)	60 (12) F	1 (192) (L)	3		B 4			BFO 24
1A		1	276	2240 (56x18)	1	60	1 24	1	3449B	316D			150D
		1	276	2240	2	60	1 15	1	316D	316D			150D

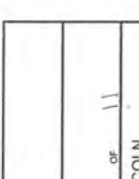

DISTANCE FROM § ROAD
SEE NOTATION
STAKED BY: EDR
DATE: 7-26-11
REV. 1
AS BUILT BY:

CTC
PROJECT: MN537-2012
EXCHANGE: LINCOLN
TOWNSHIP: Sandusky Valley

ROUTE: 2C
TWP: 132 N
RNG: 31 W
SEC: 1A 15
SHEET: 3 OF 11
CO: MORRISON
SERVICE AREA: LINCOLN

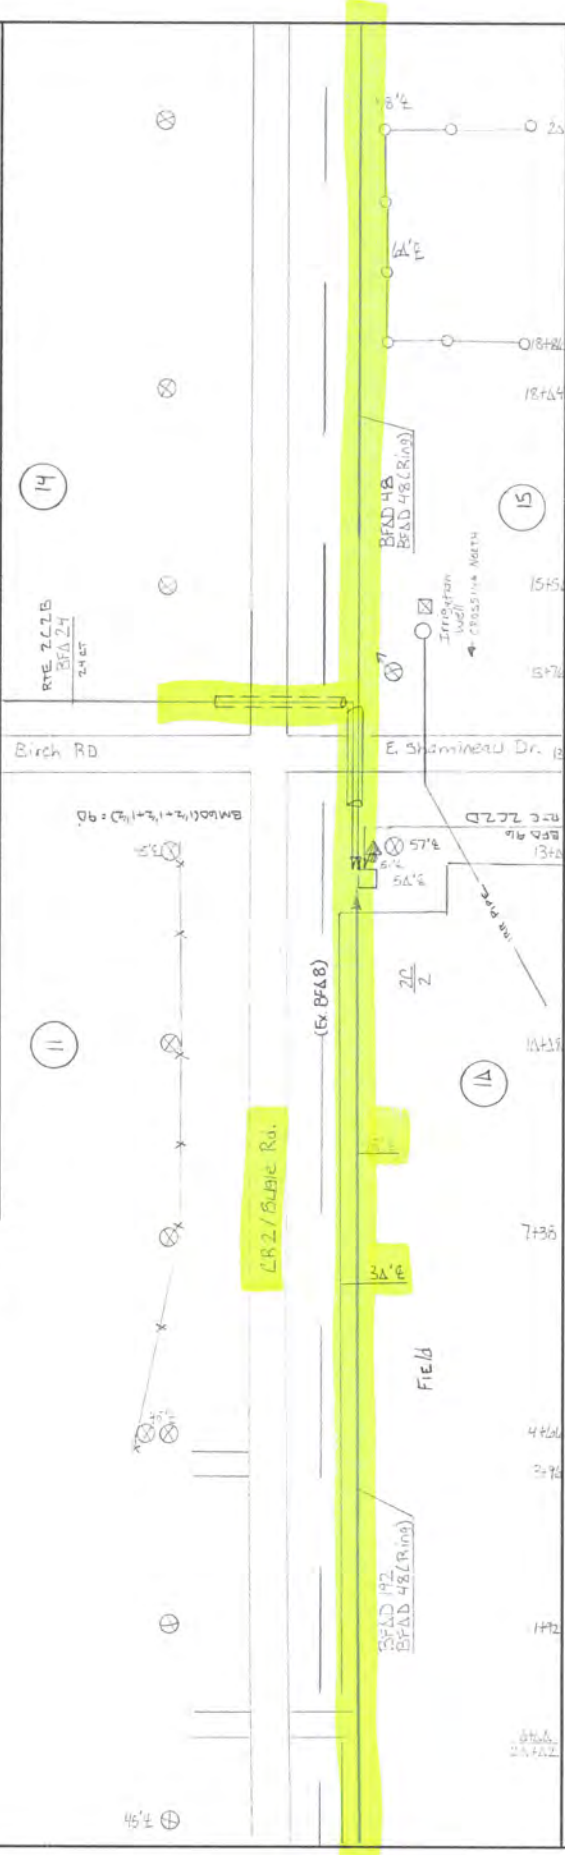

HOUSING NO.	BA	BDO	BFO	BH	BM	BF	HB	HO	NID	SUB NO.	SE	UD	UO
2			(48 ± Pole)	F (200' x 360') T (565') S	5 S	1	1	1	1	1	1	1	1
			2770 T	2850	4D	1	1	1	1	1	1	1	1
			2770	2850	4D	1	1	1	1	1	1	1	1




SEE NOTATION
 STAKED BY: EDB
 DATE: 7-27-11
 REV. DATE: 7-27-11



AS BUILT BY:
 DATE:

PROJECT: MN537-2012
 EXCHANGE: LINCOLN
 TOWNSHIP: Scandinavia Valley

TWP: 137 N
 R1G: 31 W
 SEC: 10A OF 11
 CO: MORRISON
 SERVICE AREA: LINCOLN

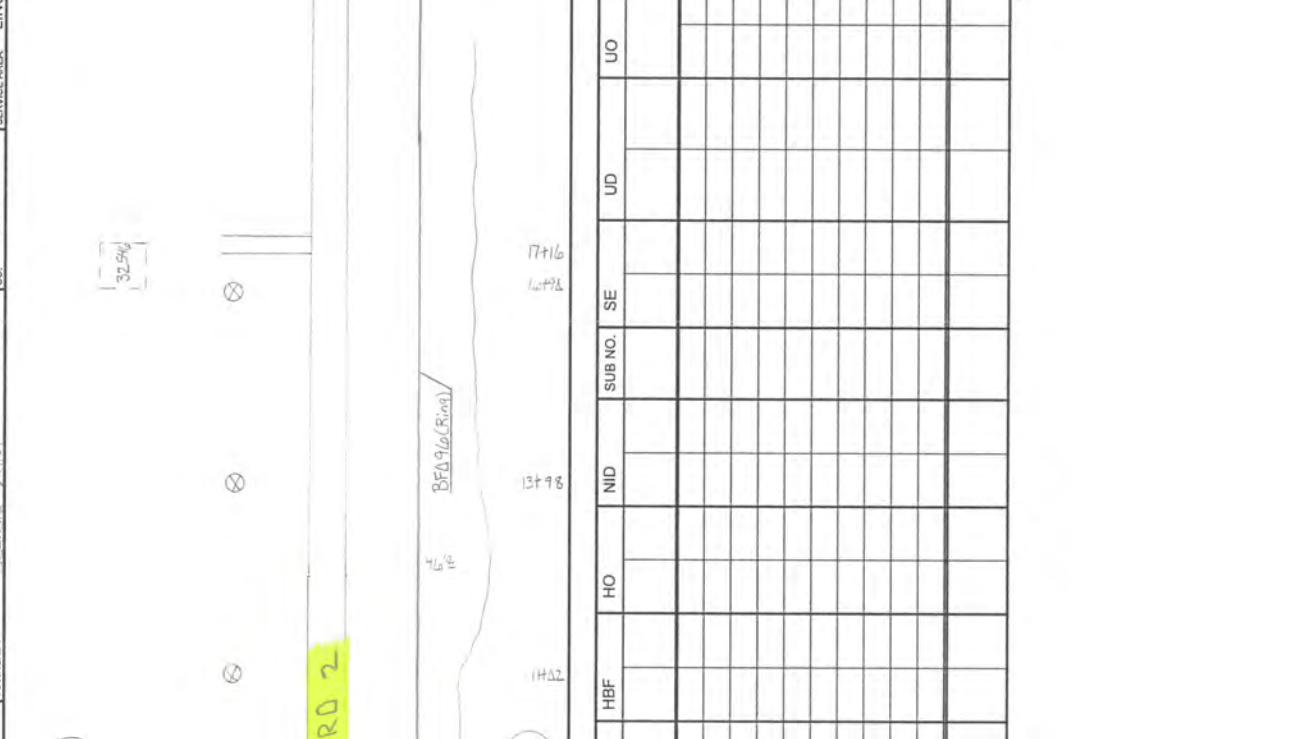

HOUSING NO.	BA	BDO	BFO	BH	BM	HBF	HO	NID	SUB NO.	SE	UD	UO
EDR1			916 Pavement		53							
			87Δ		1							
			87Δ		1							

