


CTC
 MN537-2012
 PROJECT:
 LINCINN
 EXCHANGE:
 SCANDIA VALLEY (W)
 TOWNSHIP:
 MORRISON
 CO.
 SERVICE AREA:
 LINCINN


STATED BY: RJB
 DATE: 10-19-11
 REV. DATE:
 AS BUILT BY:
 DATE:
 SEE NOTATION
 TWP 132 N
 RING 31 W
 SEC. 30 OF 10

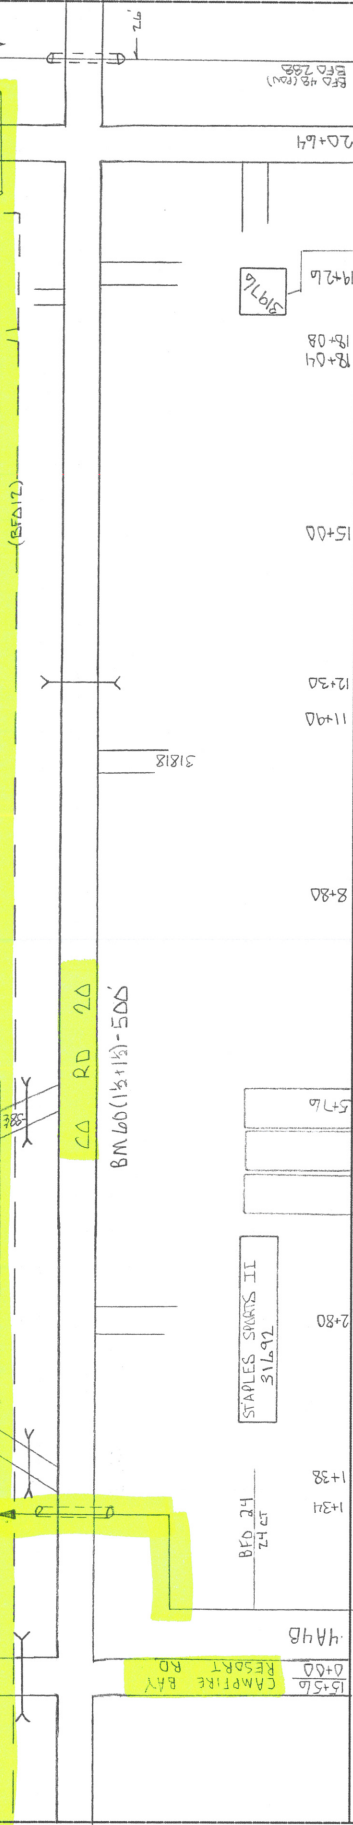

BA	BDO	BFO	BH	BH	BM	HSB	HO	NID	SUB NO.	SE6	UD	UO	X X
NO.													
44	RV PARK SHEET 3A of 10	(410 1/2) FSN	2880	F(30x48 x 31x42)	2	(5/8) 18	-						
LW/ZA	CAMPFIRE RY RD	704 Express	850		1		30						
		704 Express	850		1		30						

Prepared By: CNS 2/16/08 1000


DISTANCE FROM $\frac{1}{2}$ ROAD
 SEE NOTATION
 STAKED BY: RJB
 DATE: 10-19-11
 REV.
 AS BUILT BY:
 DATE: 3/5/12
 N.T.D. 3
 PROJECT: MIN537-2012
 EXCHANGE: LINCOLN
 TOWNSHIP: SCANDIA VALLEY (W)
 CO. MORRISON
 SERVICE AREA: LINCOLN
 SHEET: 20 OF 10
 ROUTE: 11A
 TWP 132 N
 RING 31 W
 SEC. 30

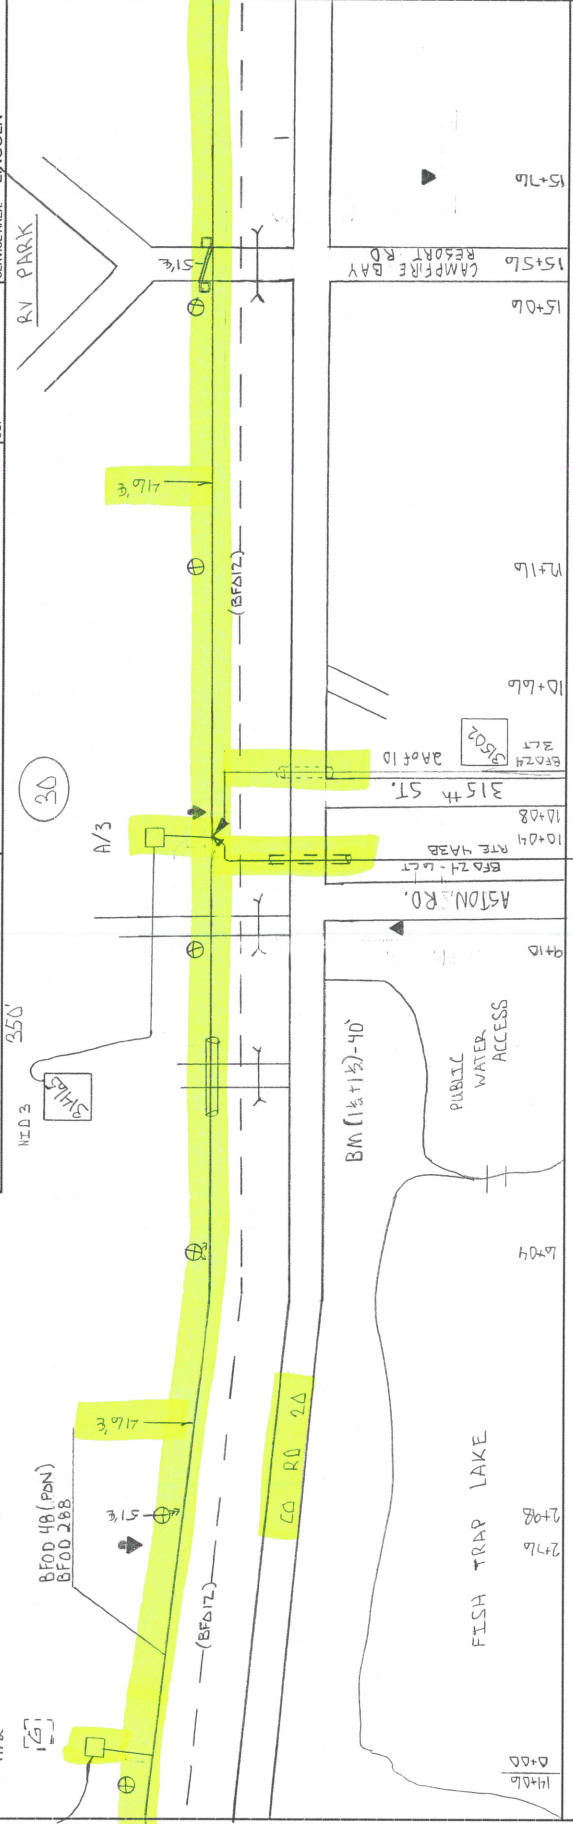

HOUSING NO.	BA	BDO	BFO	BH	BM	HBF	HO	NID	SUB NO.	SEB	UD	UO
48			(48) PBN 288	F(36X60) X(36X1)	2 (50)(18+13) 60	0 (288)	-1	3		4		
			1022 EXPRESS	1	1 40	1	10	1	31465	350		
			1022	1	1 40	1	10	1		350		




DISTANCE FROM ξ ROAD
 SEE NOTATION
 NORTH
 DATE: 8/15/2011
 STAGED BY: DM/E
 PROJECT: MN537-2012
 EXCHANGE: LINCOLN
 TOWNSHIP: SCADIA VALLEY
 CO. MORRISON
 REV. DATE: DATE: 1 OF 13
 SEC. 30
 RING 31 W
 TEMP. 137 N
 ROUTE: 4C

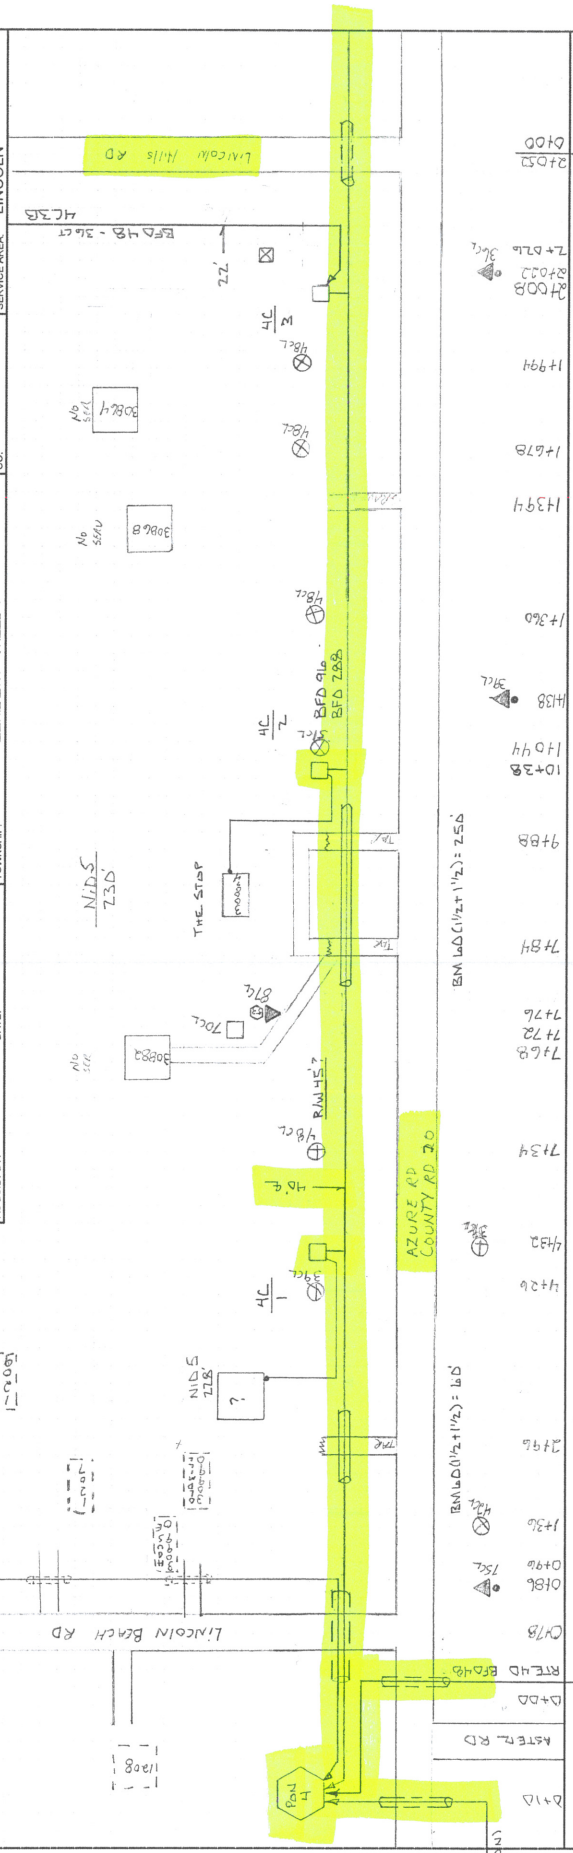

HOUSING NO.	BA	BDO	BFO	BH	BM	HBF	HO	NID	SUB NO.	SE	UD		UO
											UD	UO	
1				F (30x46) X365T	Z (81x8)	(916 \pm 250)D	1	5	5B	B 4	B 13		
2				720	710B	710B	1	1	7	27B			
3				1132	1070 EXP	250	2	1	3087H		330		
				21020	2470	310	39	1		228	230		

DISTANCE FROM ξ ROAD		CTC				TMP: 132 N		ROUTE: 4C	
SEE NOTATION		PROJECT: MN537-2012				RNG: 31 W			
STAKED BY: DJL E		DATE: 8/19/2011				EXCHANGE: LINCOLN		SHEET: 7 OF 13	
REV.						SEC: 31		MORRISON	
AS BUILT BY:		TOWNSHIP: SCLANGIA VALLEY-1				CO. MORRISON		SERVICE AREA: LINCOLN	

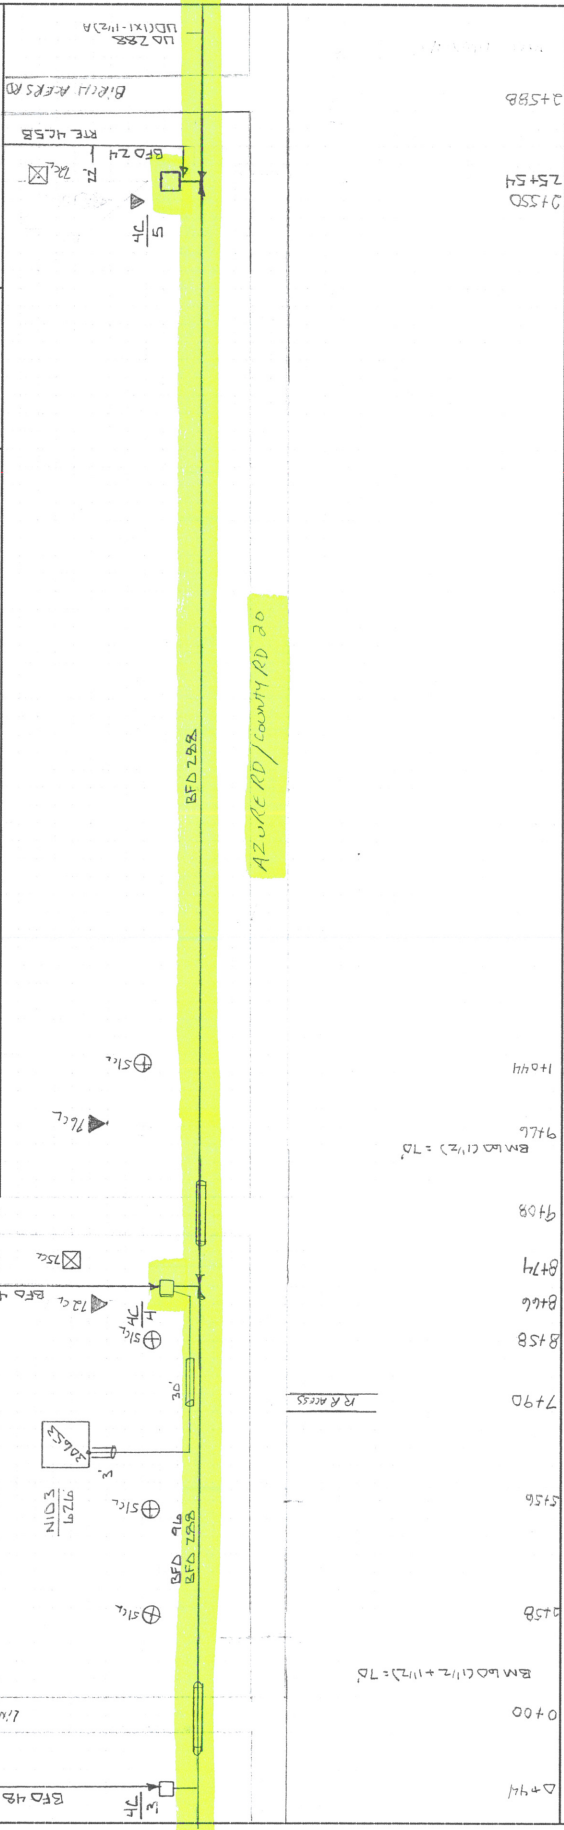


HOUSING NO.	BA	BDO	BFO		BH	BH	BM	HBF		HO	NID	SUB NO.	SE	UD	UO
			Z	Y				Δ	Δ						
1				109D		1		70	70	49	1	30653	676		
2						1				24					
				186D		1		70	70	73	1	676			

DISTANCE FROM ξ ROAD
CTC
 PROJECT: MN537-2012
 EXCHANGE: LINCOLN
 TOWNSHIP: SCANDIA Valley
 COUNTY: MORRISON
 SERVICE AREA: LINCOLN

STAMPED BY: DJL
 DATE: 10/31/2011
 REV. 1
 AS BUILT BY:

TWP. 132 N
 ROUTE: 41C
 RING 31 W
 SHEET: 3 OF 15

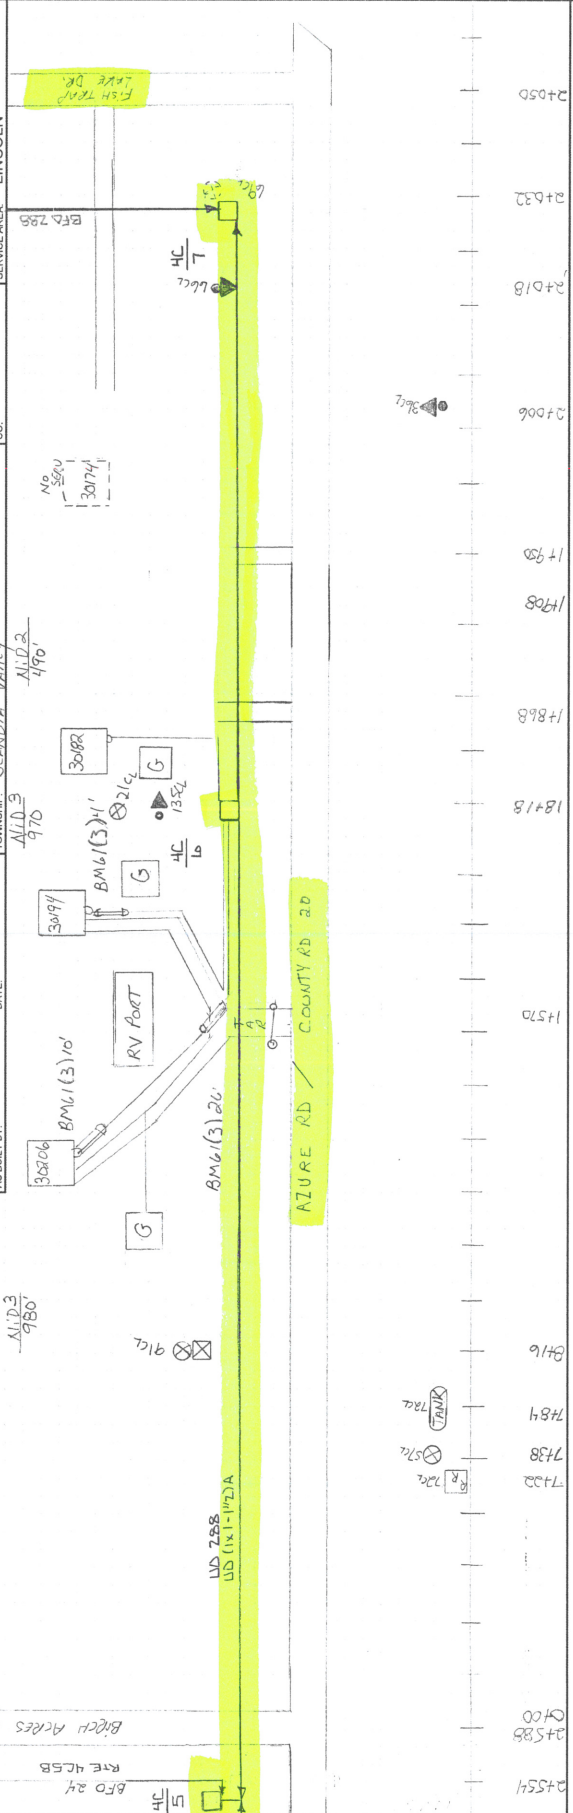

Housing No.	BA	BDO	BFO	BH	BM	61 (3)	HBFB	HO	NID	SUB NO.	SEB	UD	UO
11				1	2 (5/8)(8)	61 (3)	0 (288)	-1	2	3	4	(1x1)3A	288
6				1	1	36	1	3	1	30206	980	1852	2024
				1	1	4	1	288	1	30194	970	214	386
				2	2	40	2	291	1	2	2440	2016	2410