


DISTANCE FROM  $\frac{1}{2}$  ROAD  
**CTC**  
 PROJECT: MN637-2012  
 EXCHANGE: LINCOLN  
 TOWNSHIP: S44ND, A 1/4 1/4  
 DATE: 10/18/2011  
 AS BUILT BY:

TWP 132 N  
 RING 31 W  
 SEC 20  
 CO. MORRISON  
 SERVICE AREA: LINCOLN  
 SHEET 1 OF 4  
 ROUTE 4D  
 BENCH MARKS: 30938, 30946, 30944, 30946, 30944, 30946, 30944



HOUSING NO.	BA	BDO	BFO	BH	BM	HBF	HO	NID	SUB NO.	SE	UD	UO
1		4	48		53 (58)(8)		-1					
		1	874		1 1 70 114		7					
		1	874		1 1 70 114		7					

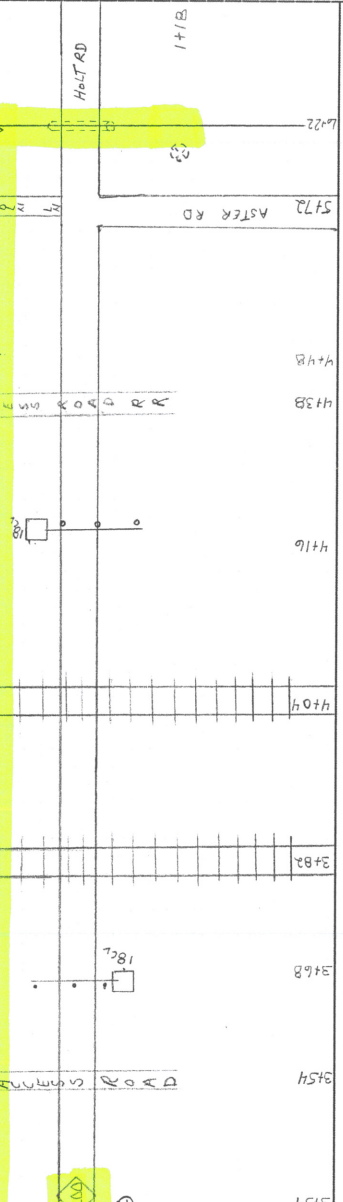