


GENERAL LOCATION ONLY.  
DO NOT USE TO LOCATE FOR EXCAVATION.  
CALL 1-800-252-1166 FOR ONSITE LOCATIONS AND STAKING.



Scale: 1" : 312'

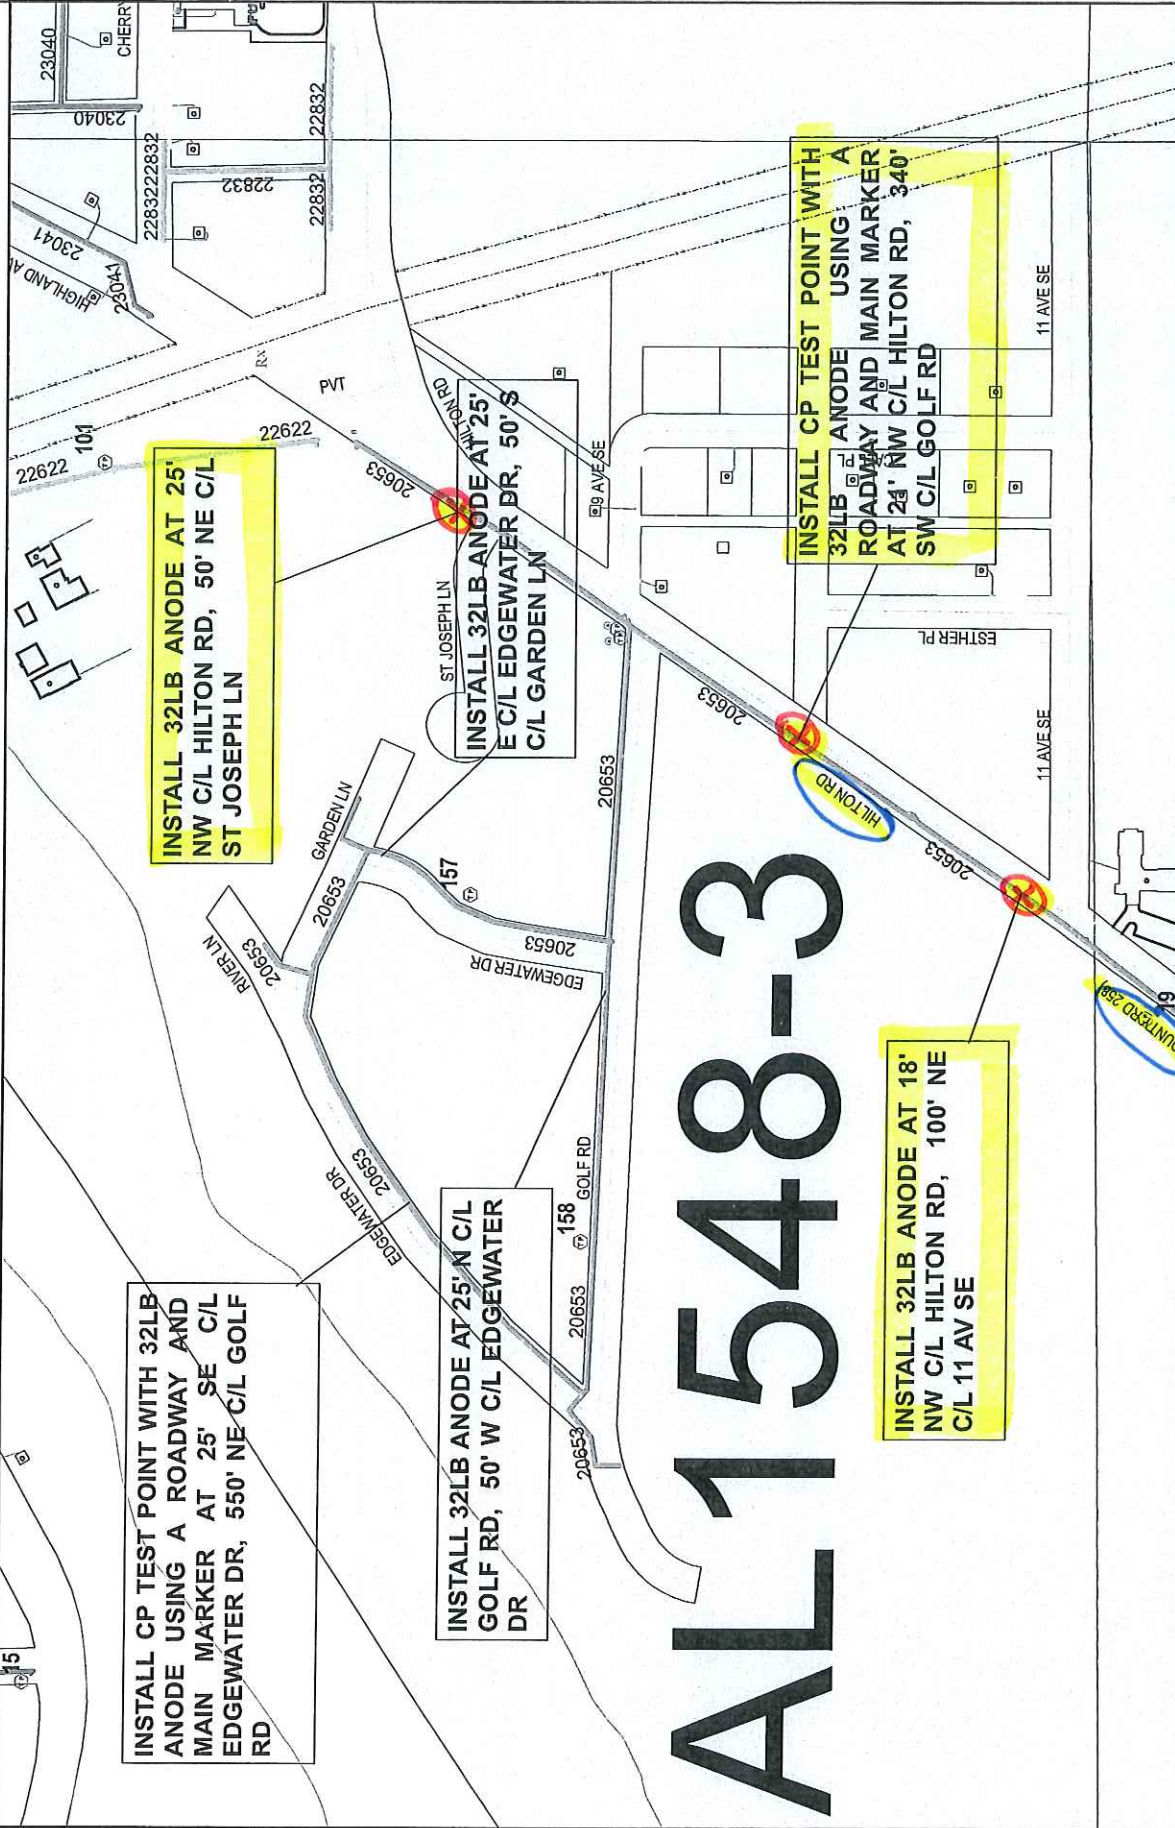

INSTALL CP TEST POINT WITH 32LB ANODE USING A ROADWAY AND MAIN MARKER AT 25' SE C/L EDGEWATER DR, 550' NE C/L GOLF RD

INSTALL 32LB ANODE AT 25' N C/L GOLF RD, 50' W C/L EDGEWATER DR

INSTALL 32LB ANODE AT 25' NW C/L HILTON RD, 50' NE C/L ST JOSEPH LN

INSTALL 32LB ANODE AT 25' E C/L EDGEWATER DR, 50' S C/L GARDEN LN

INSTALL 32LB ANODE AT 18' NW C/L HILTON RD, 100' NE C/L 11 AV SE

INSTALL CP TEST POINT WITH 32LB ANODE USING A ROADWAY AND MAIN MARKER AT 25' NW C/L HILTON RD, 340' SW C/L GOLF RD

# AL1548-3

Work Order #: 88841622  
Design Date: 01-09-2019

City: LITTLE FALLS  
Quad/Sec/Twp/Rng: NE SEC-18/T-40/R-32

CP Section #: 20653  
CP Area: AL1548-3  
Designed By: P TEESELINK  
Designer Phone #: 612.910.1378