

DISTANCE FROM E ROAD  
SEE NOTATION


DATE: 7-26-11  
PROJECT: MIN537-2012  
EXCHANGE: LINCOLN  
TOWNSHIP: Scandinavia Valley

DATE: \_\_\_\_\_  
AS BUILT BY: \_\_\_\_\_

DATE: 7-26-11  
PROJECT: MIN537-2012  
EXCHANGE: LINCOLN  
TOWNSHIP: Scandinavia Valley

DATE: \_\_\_\_\_  
AS BUILT BY: \_\_\_\_\_

DATE: \_\_\_\_\_  
AS BUILT BY: \_\_\_\_\_

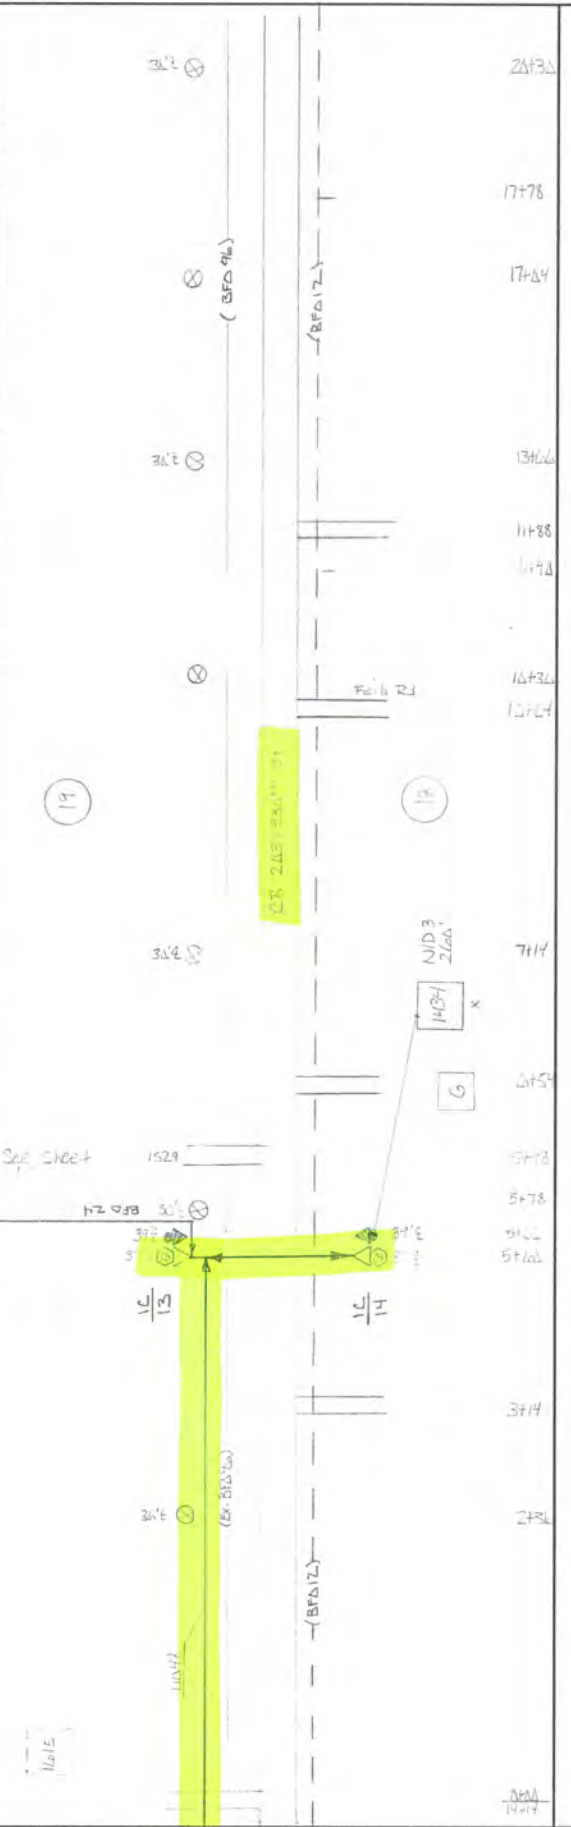

HOUSING	BA	BDO	BFO	BH	BM	HB	HO	NID	SUB NO.	SE	UD	UO	W
13		5 (S&C)		7 (S&C)	53		1	3		B 4	(11-11/2) (11-11/2) A	48	UD (11-11/2)
14		1		1	1		2				30	766	ZD
		1		1	1		1	1	1434	Z60	92	Z10	
		2		2	2		3	1		Z60	92	976	ZD

13+00 13+25 13+50 13+75 14+00 14+25 14+50 14+75 15+00 15+25 15+50 15+75 16+00 16+25 16+50 16+75 17+00 17+25 17+50 17+75 18+00

13+00 13+25 13+50 13+75 14+00 14+25 14+50 14+75 15+00 15+25 15+50 15+75 16+00 16+25 16+50 16+75 17+00 17+25 17+50 17+75 18+00

CTC

MIN537-2012  
LINCOLN  
STANBRIA VALLEY

TWP 137 N  
RNG 31 W  
SEC 19  
MORRISON  
CO. LINCOLN

ROUTE 10  
SHEET 4 OF 7

DATE: 7-24-11  
REV. 1  
AS BUILT BY: 1877


PROJECT: EXCHANGE  
TOWNSHIP: STANBRIA VALLEY

SEE NOTATION

STAKED BY: EDR  
DATE: 7-24-11  
REV. 1

DATE: 7-24-11  
REV. 1  
AS BUILT BY: 1877

NOTE:  
EXPOSE EX 1/2" PIPE AT  
LN 1/2 + 1/2 TO SIGNAL  
PIPE ENDS INTO NEW PEES

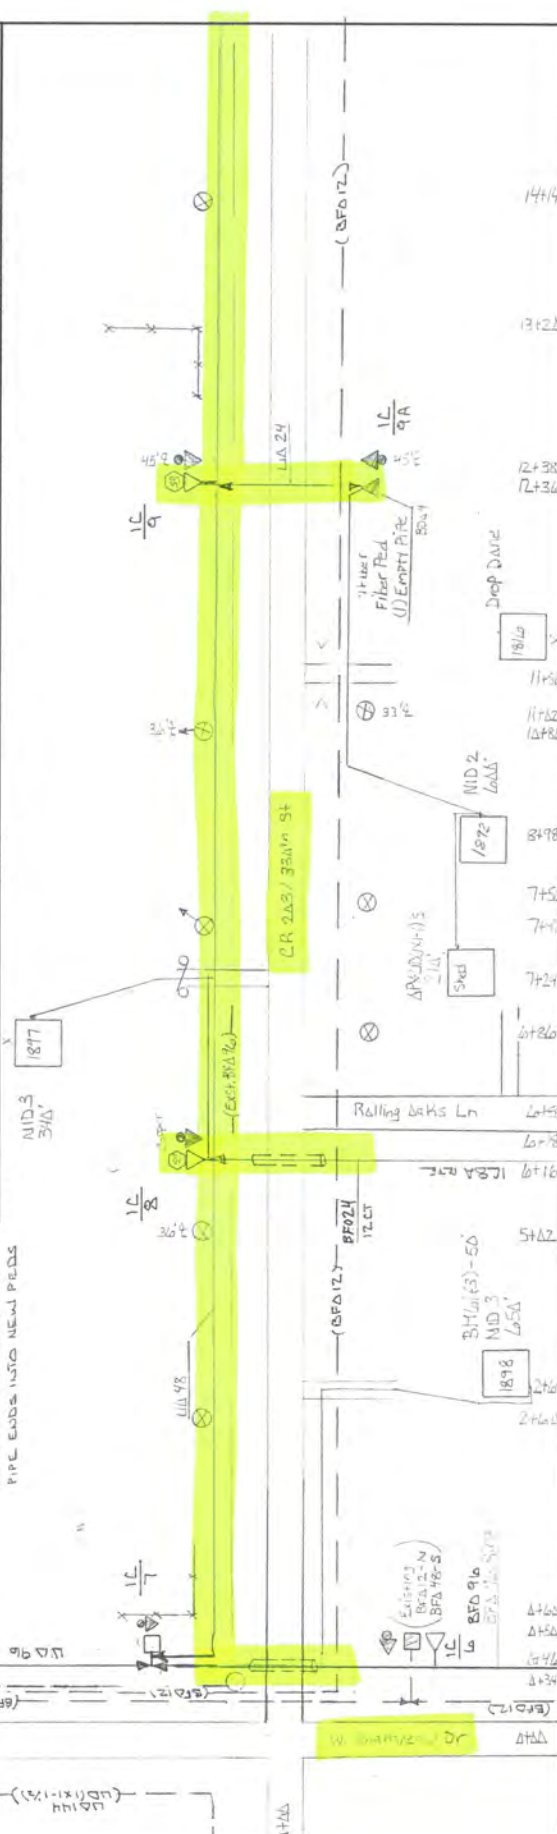

HOUSING NO.	BA	BDO	BFO	BH	BM	HBF	HO	NID	SUB NO.	SE	UD	UD	UD	WJ
8		4 (5lb)	9lb		7 (5lb)		1	2	3	B 4	(1x1)	(1x1)	48	BDD 4 (5lb) (1x1-1/2)
9					1		13		1	340			70lb	20
9A		EX			EX		1	1		600	210		75lb	20
LN-2			470				17	1		EX				
		2	470		2			2		940			170	
											210		146Z	40


CTC

PROJECT: MN537-2012  
 EXCHANGE: LINCOLN  
 TOWNSHIP: SCANDIA VALLEY

DATE: 5-12-11  
 REV. 1  
 AS BUILT BY:

TYPE: 32 N  
 RING: 31 W  
 SEC: 20 17 18  
 CO: MORRISON

ROUTE: A  
 SHEET: 7 OF 7  
 SERVICE AREA: LINCOLN

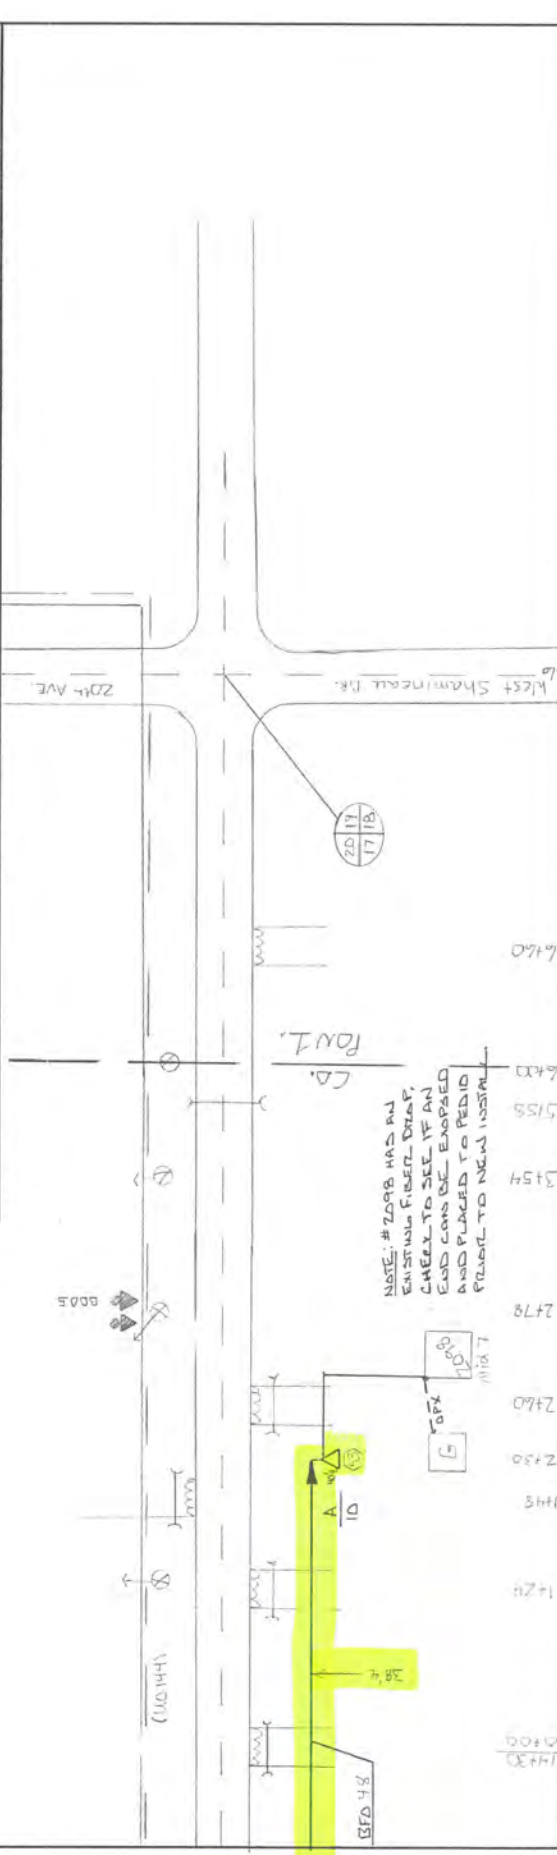

HOUSING	BA	BDO	BFO	BH	BM	BM	HBF	HO	NID	SUB NO.	SE	UD	UO	W
10	21	4 (S)	48		2 (S)	640		-1	7		4	(x-1) 5		SEB 4
	2	1	97D		1	30		1	1	2098	300	20		100
	2	1	97D		1	30		1	1		300	20		100















CTC

PROJECT: MN537-2012  
 EXCHANGE: LINCOLN VALLEY  
 TOWNSHIP: SCAMMIA VALLEY

DATE: 5-12-11  
 REV. 1

AS BUILT BY: DATE:

STAKED BY: JG/JMA  
 DATE: 5-12-11


SEE NOTATION  
 DISTANCE FROM E ROAD

ROUTE: ALGD  
 SHEET: 1 OF 2  
 SERVICE AREA: LINCOLN

CO. MORRISON  
 SEC. 16 17  
 T1 ZD

TWP 32 N  
 RNG 31 W

USE THE DAMAGED 144 AS POLL ROPE

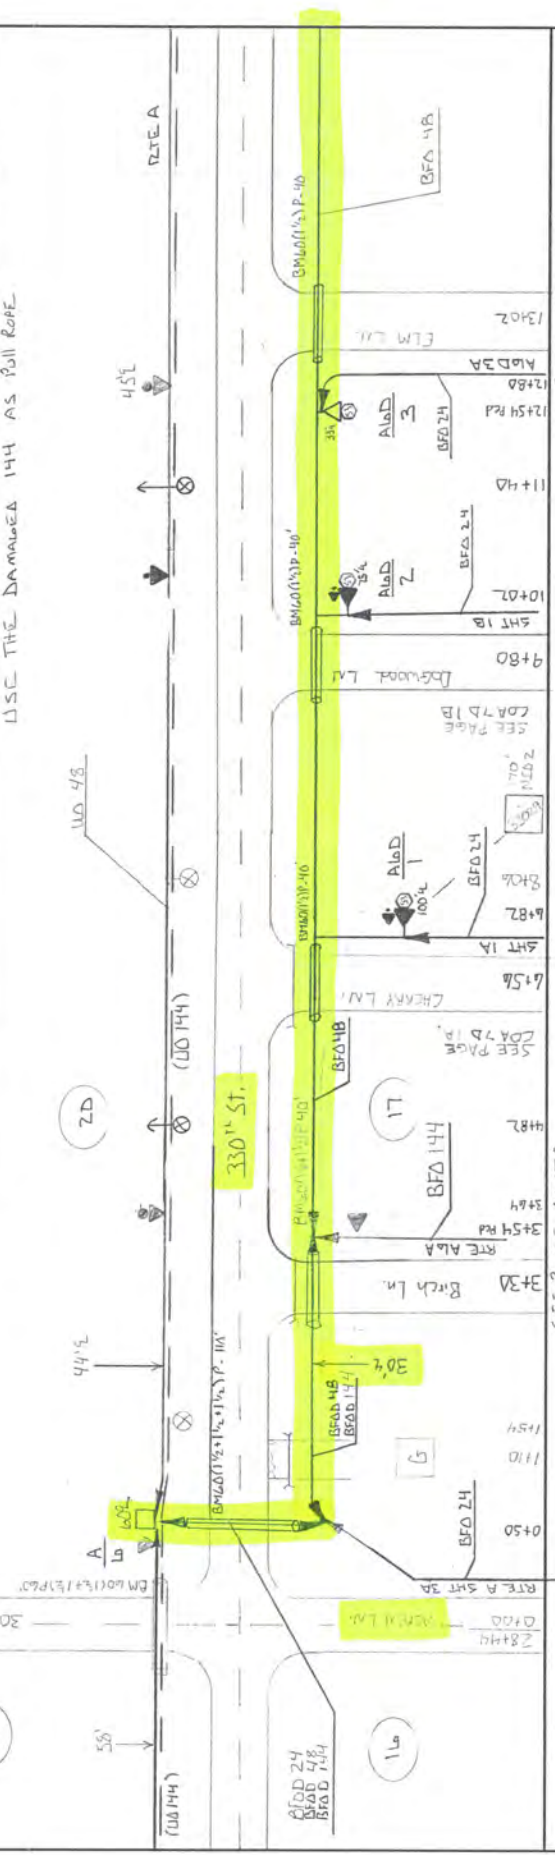

SEE ROUTE DATA

HOUSING	BA	BDO	BFO	BH	BM	HBF	HO	NID	SUB NO.	SEE	UD	UO	UJ
1	4	(5G)	144\144	4B	53	60 (112)	1	2	4	4			BDD 4
2			490	490			5	1	33029	170			1
3							5						1
							8						1
							18	1		170			2

SEE ROUTE DATA

REVISION 15, CHS 2/18/2010



**CTC**

DISTANCE FROM E ROAD  
SEE NOTATION

DATE: 5-11-11  
REV. 1

PROJECT: MN537-2012  
EXCHANGE: LINCOLN

DATE: \_\_\_\_\_  
REV. \_\_\_\_\_

TOWNSHIP: SCANDIA VALLEY

CO. MORRISON

ROUTE: A

SHEET: 2 OF 7

SERVICE AREA: LINCOLN



HOUSING NO.	BA	BDO	BFO	BH	BM	60 (110)P	53	1274	1328	HO	NID	SUB NO.	SE	UD	UO	V
2				1	2	60 (110)P	53	1274	1328	-1	2	4	B		192	UD (191-175)
3				1	1	70	70	1274	1328	1	1	3678	60		810	70
				1	1	70	70	1274	1328	1	1	3676	520		1340	70
				2	2	140	140	1274	1328	2	1		1130		2150	40







CTC


PROJECT: MN537-2012  
 EXCHANGE: LINCOLN  
 TOWNSHIP: SCANDIA VALLEY

STAMPED BY: EE DATE: 7/11  
 REV. DATE: 7/11

AS BUILT BY: DATE:

TPM 132 N  
 RWG 31 W  
 SEC 23/24  
 CO. MORRISON

ROUTE: ZC  
 SHEET: 8 OF 11  
 SERVICE AREA: LINCOLN

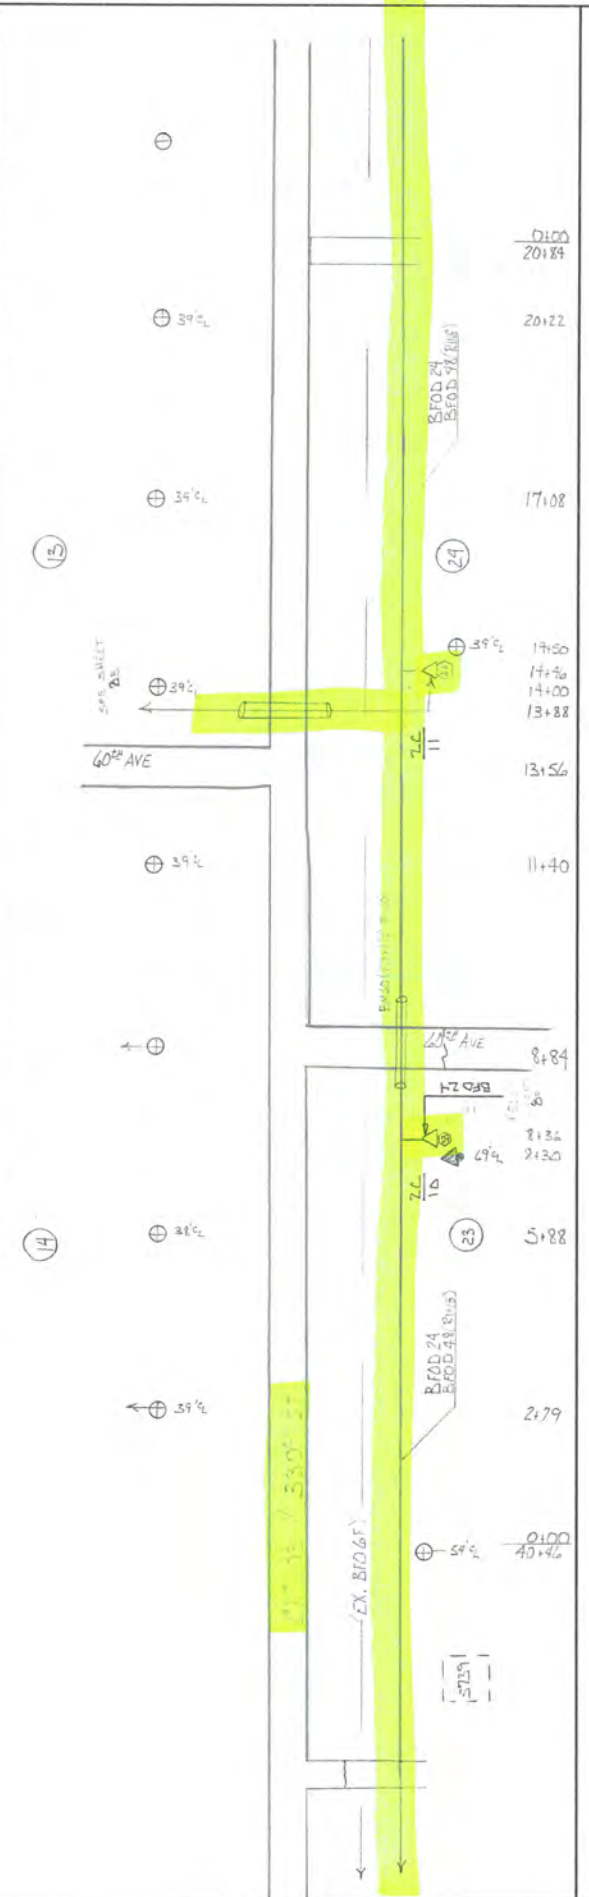

ON HOUSING	BA	BDO	BFO	BH	BM	53	BM	HBF	HO	NID	SE	UD	UO
10		(24) (53)	48) D RINGS		(53) (53)				1				
11		1	131D		1				2				
		1	7DD		1				2				
		2	ZDD		2				4				



