


WO 2361094  
j corrow

Sta 01--Replace pole id 190062  
with a 45' cl 3 pole. Replace down  
guy assembly installing with a lead  
length of 10' minimum.

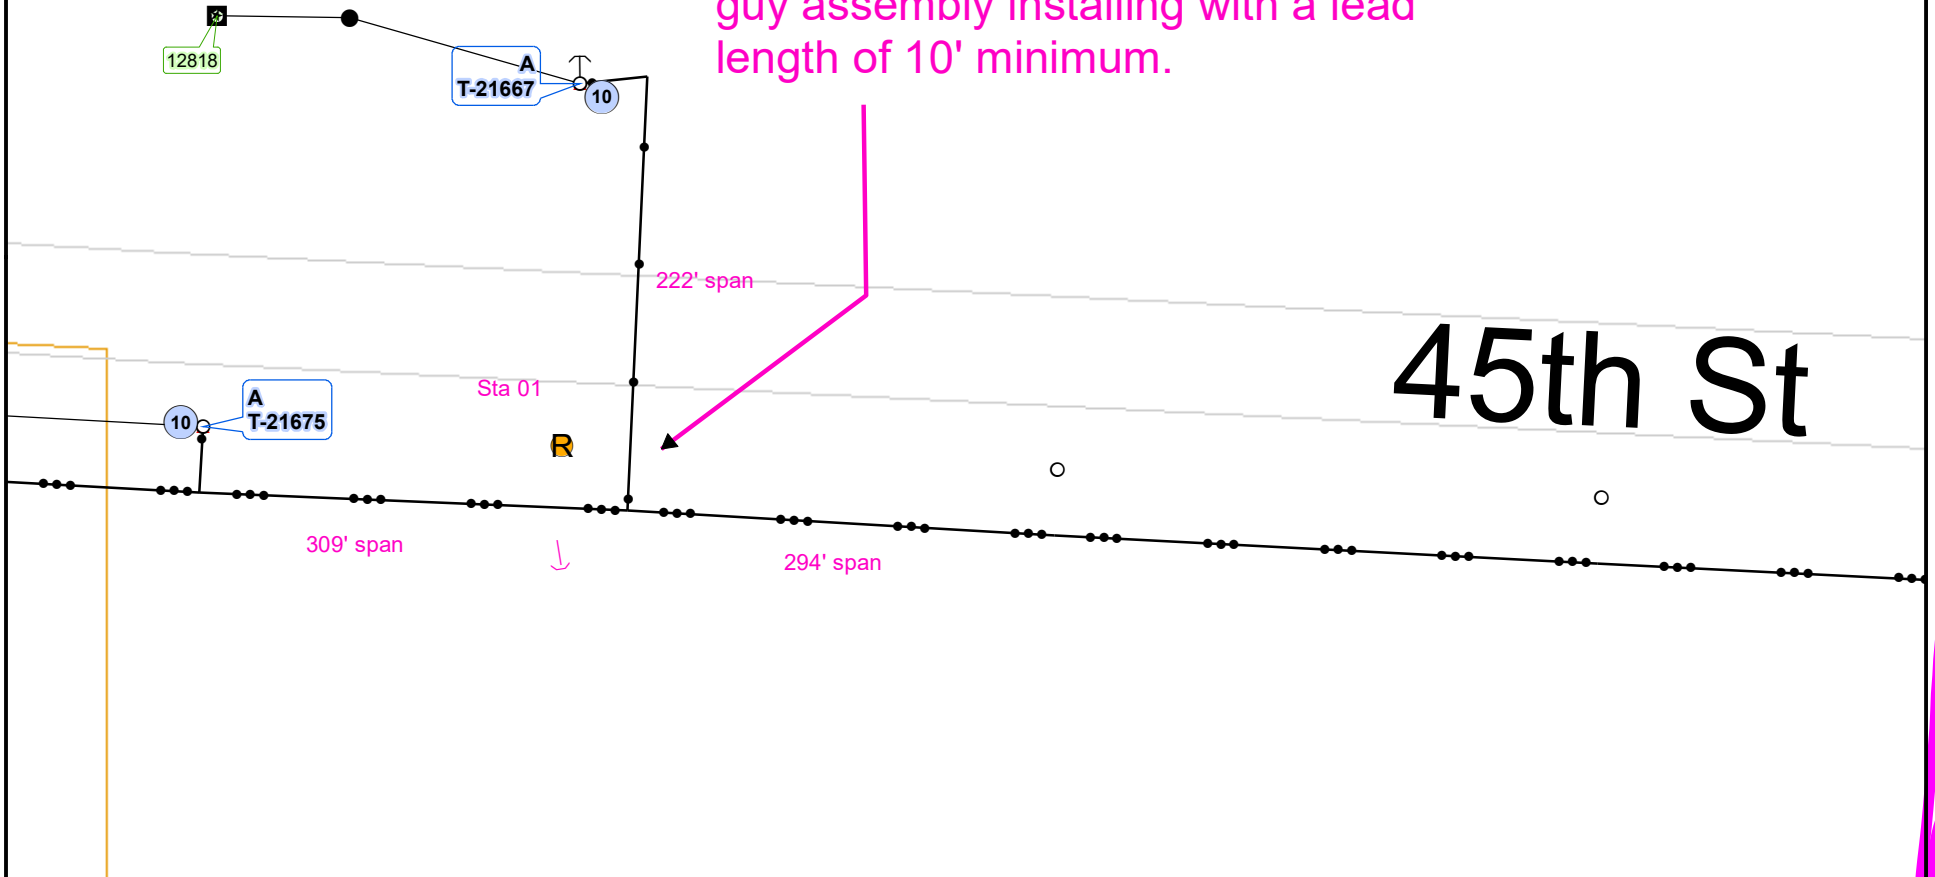

45th St

jcorrow

3/29/2019

