


WO-2362065
J Corrow

Sta 01-Remove pole and anchor.
Pole id 190069/M5555455

Sta 02-Install 40/3 pole.

45th St

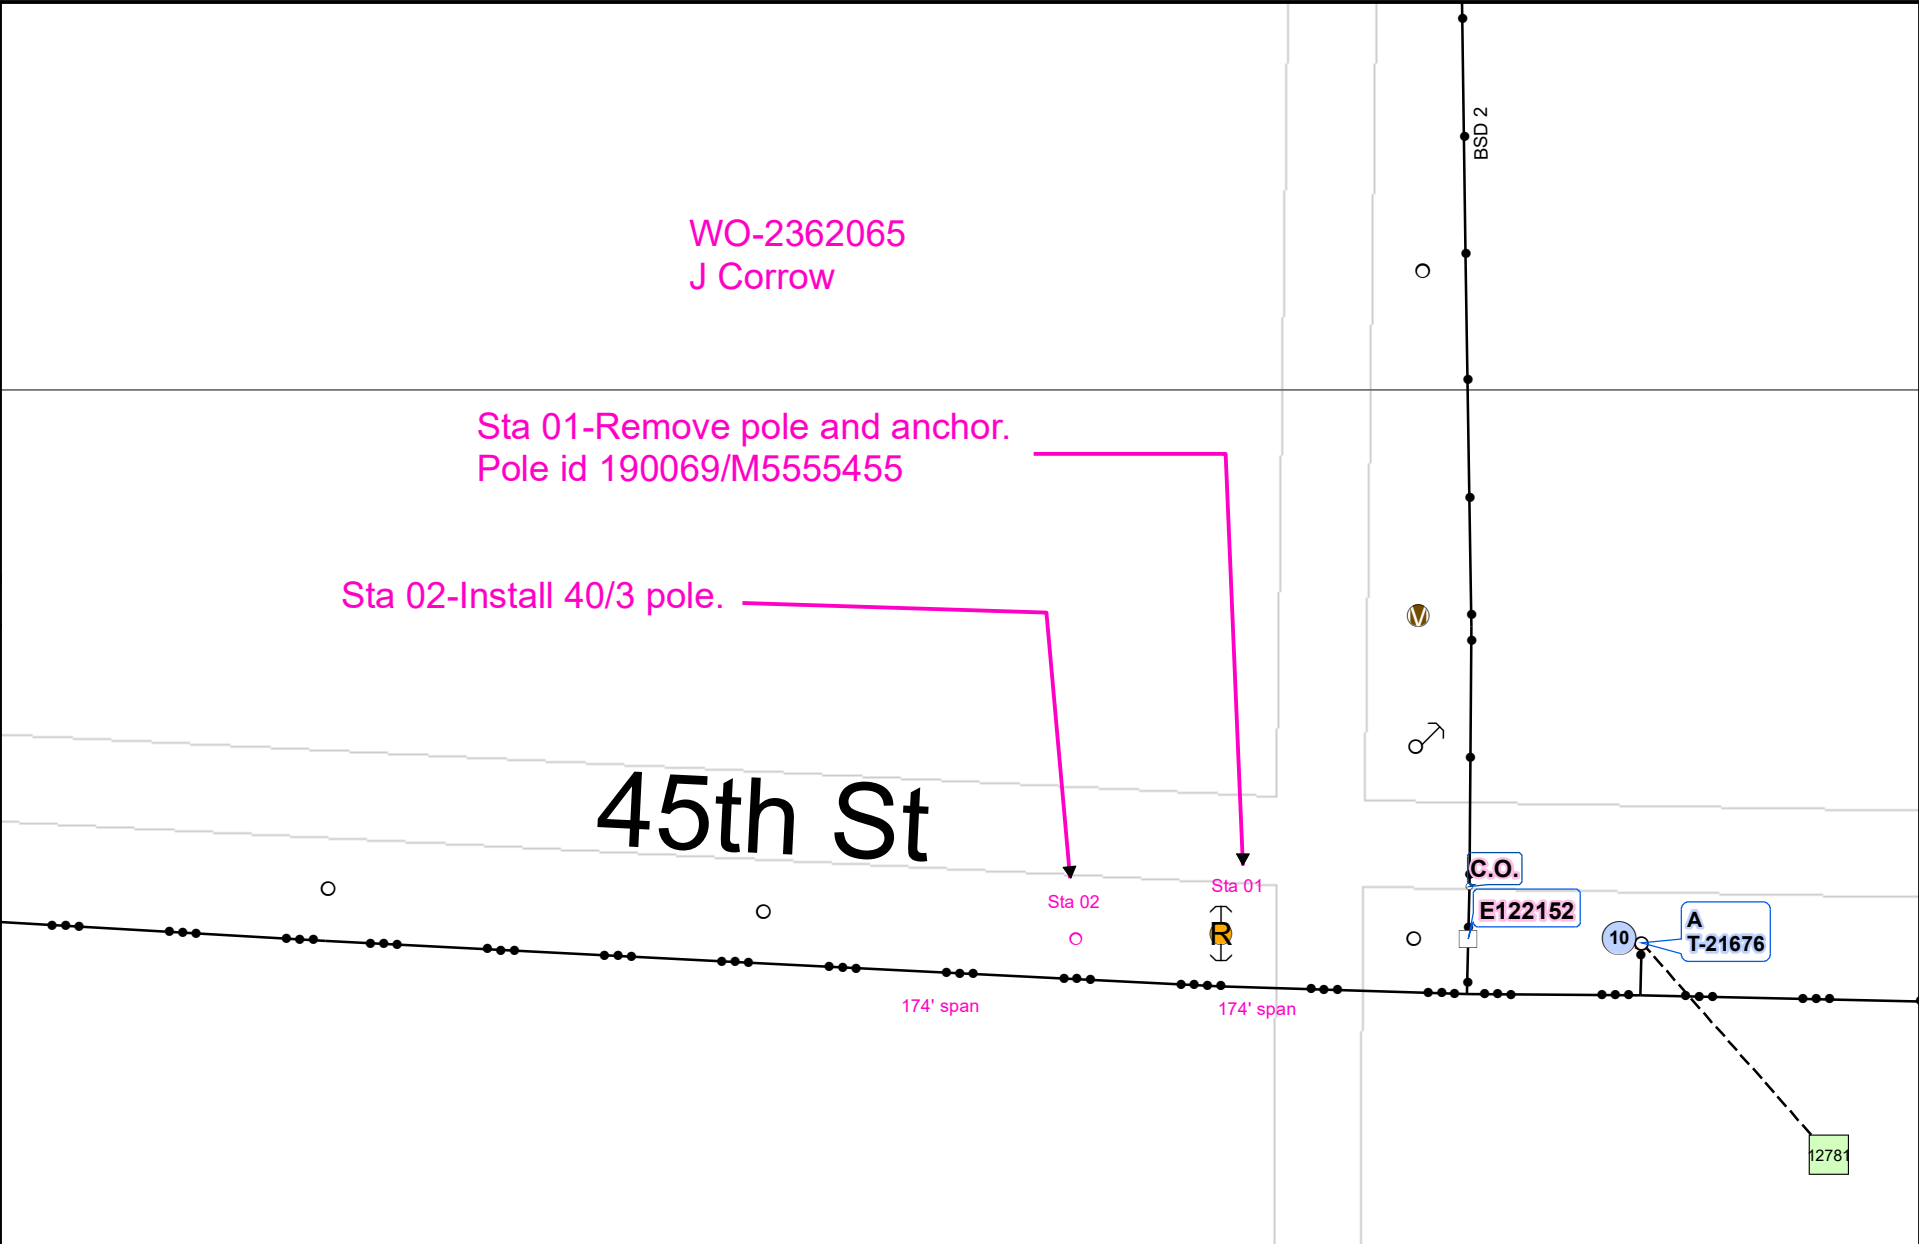

jcorrow

4/3/2019

