


Morrison County Permit
6 of the 7 pole locations
along Nature Rd and east
of 130th Ave.

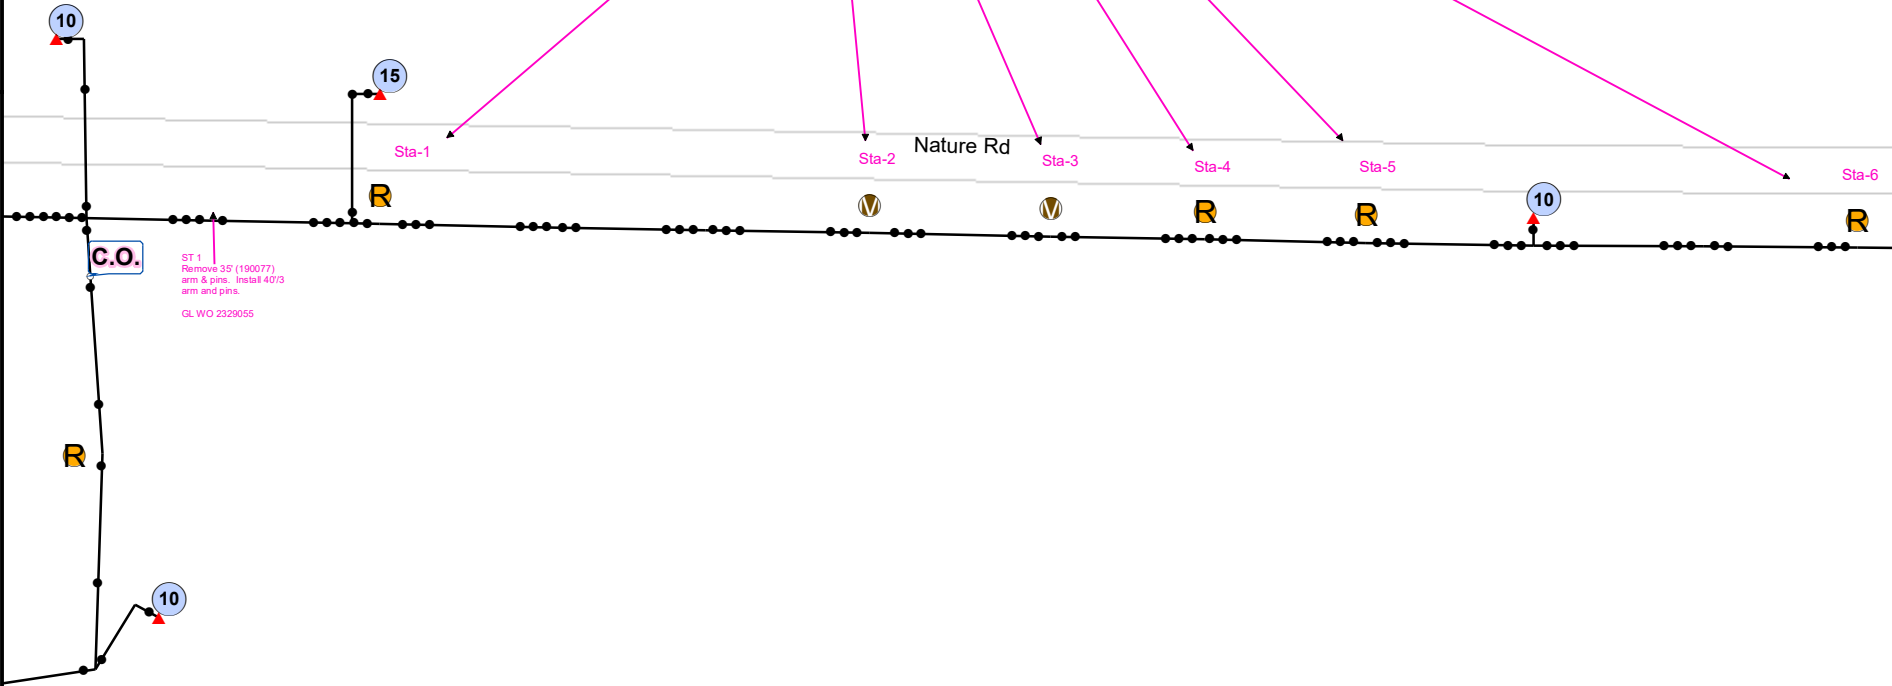

ST 1
Remove 35' (190077)
arm & pins. Install 40/3
arm and pins.
GL WO 2329055

jcorrow

4/3/2019

