


00320253

GENERAL LOCATION ONLY. DO NOT USE TO LOCATE FOR EXCAVATION. CALL 1-800-252-1166 FOR ONSITE LOCATIONS AND STAKING.

Remove Abandoned
3" Steel Pipe

Proposed @ 3' EWL
3" Plastic

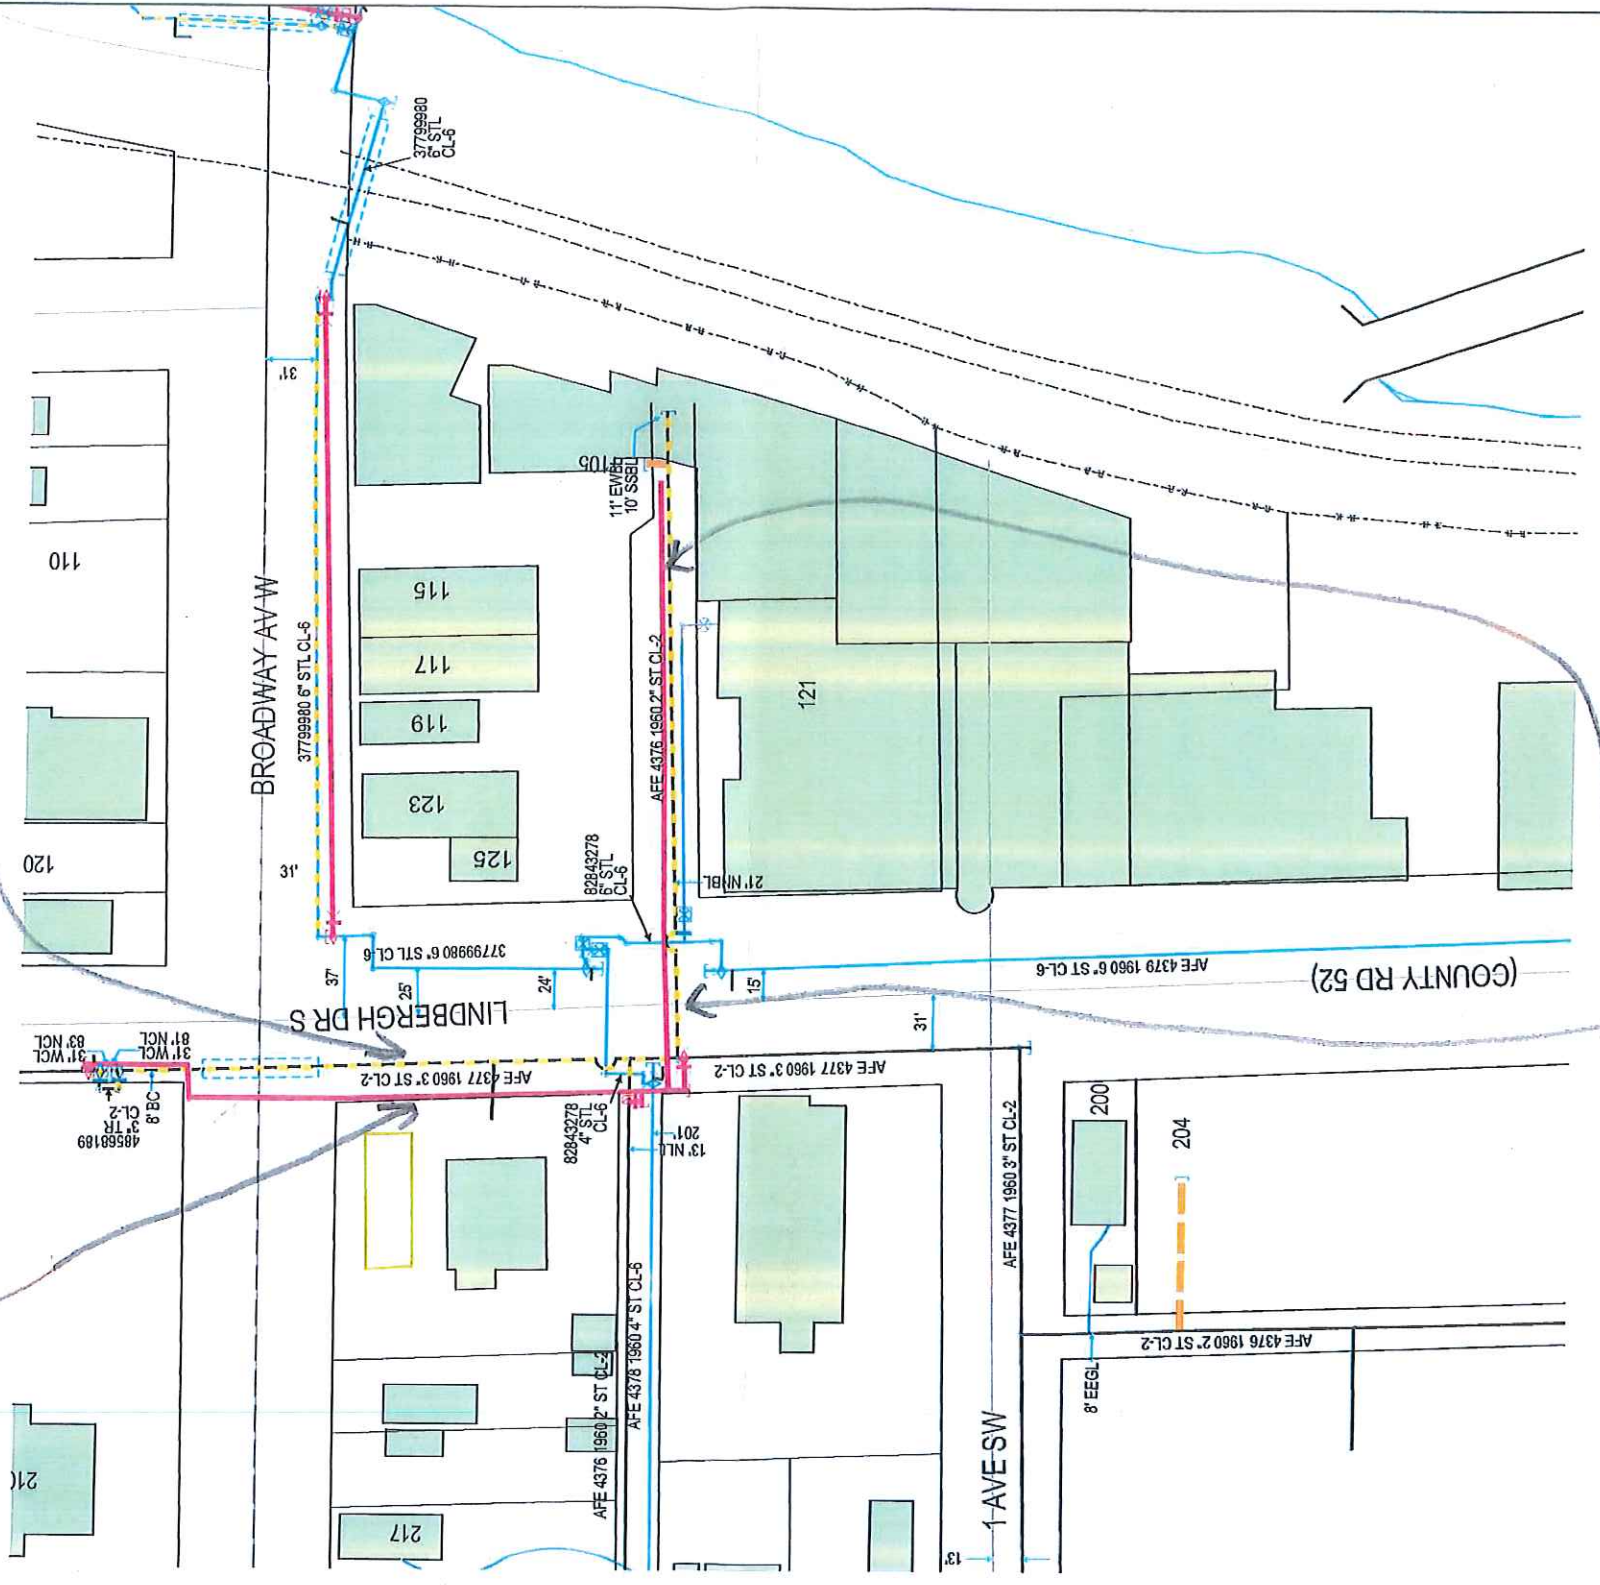

Proposed 2" Plastic @
3' North of Existing

Leave Abandoned
2" Steel in place
as approved by
County