




GENERAL LOCATION ONLY.
DO NOT USE TO LOCATE FOR EXCAVATION.
CALL 1-800-252-1166 FOR ONSITE LOCATIONS AND STAKING.



North

Scale: 1" = 114'

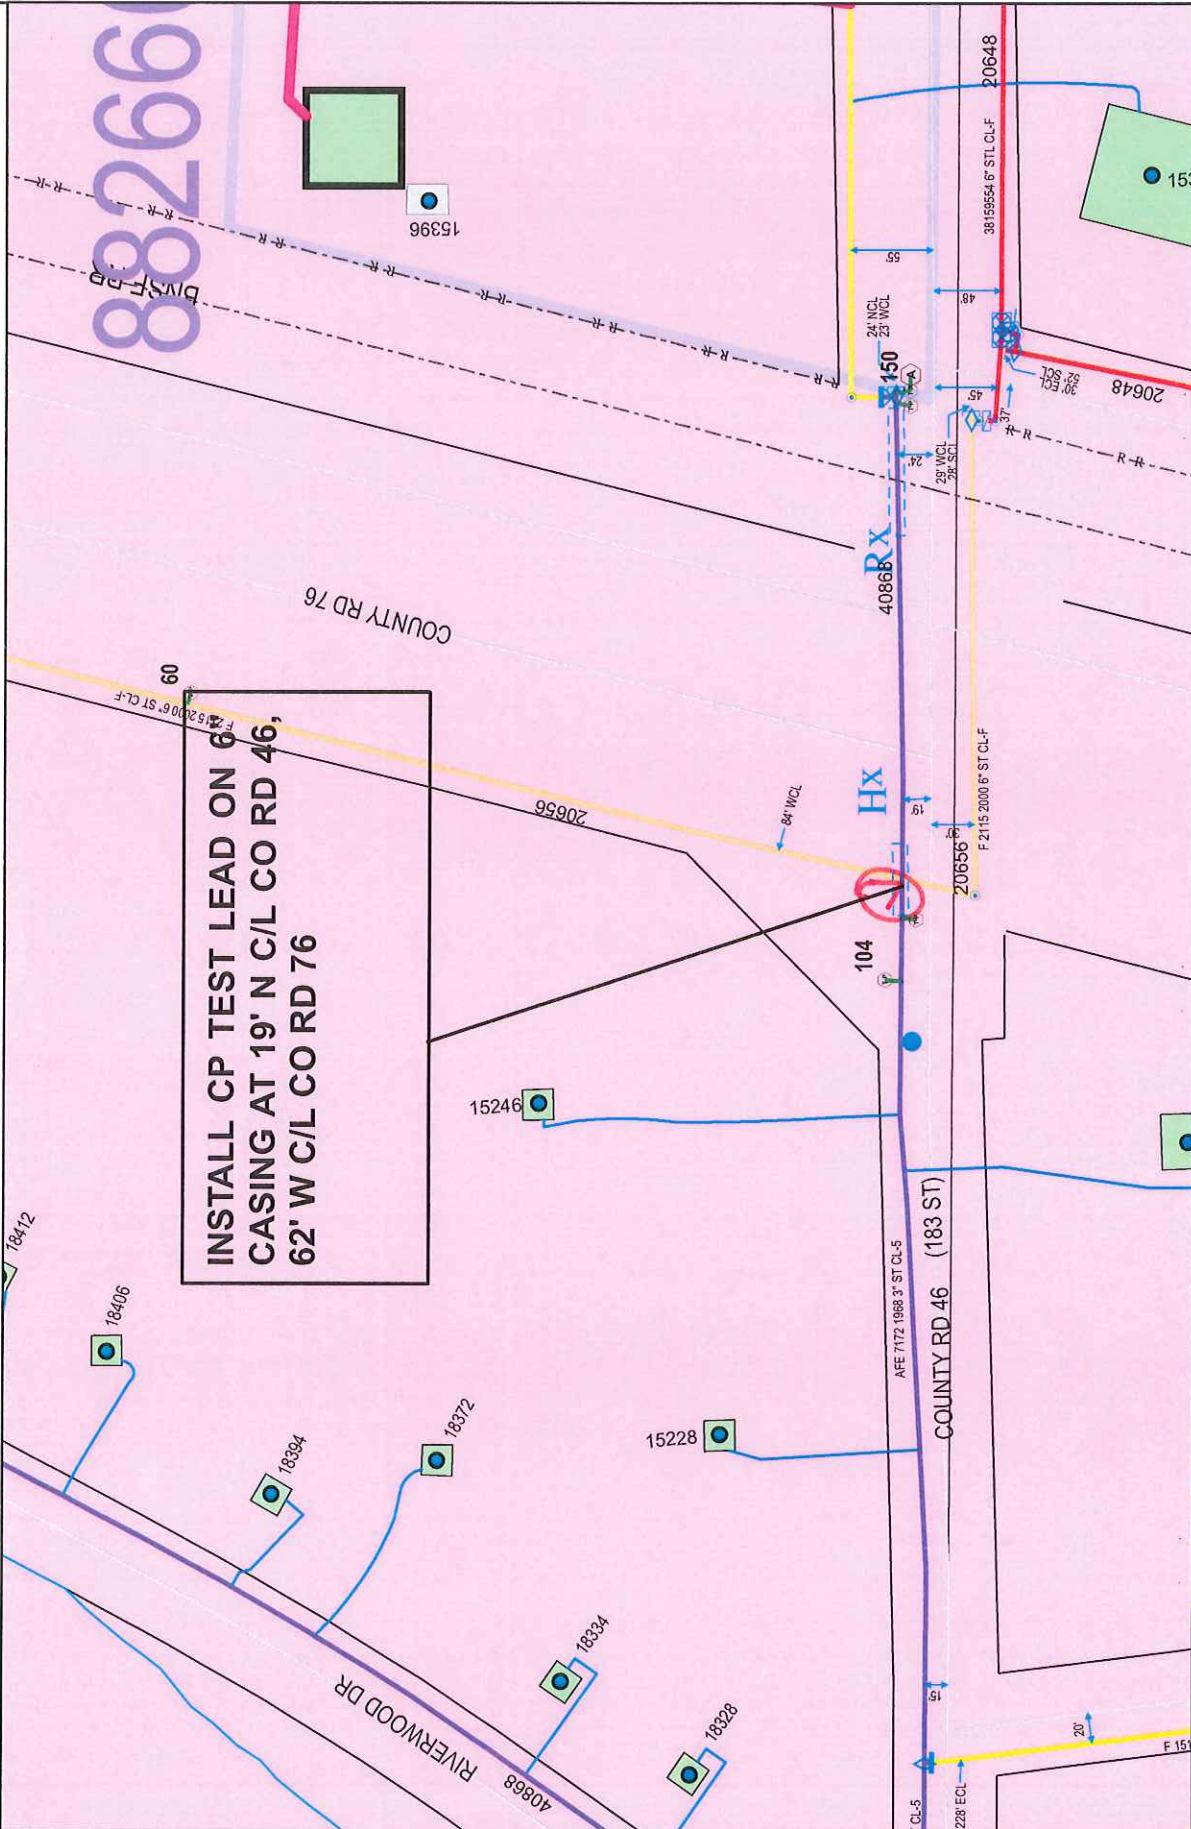

Work Order #: 89947966
Design Date: 04-19-2019

City: LITTLE FALLS
Quad/Sec/Twp/Rng: NE SEC-23/T-41/R-32

CP Section #: 40868
CP Area: AL1549-2

Designed By: P TEESELINK
Designer Phone #: 612 910 1378