



| From                  | To                   | PType    | Units  | Feet | BA 4 | BM        | HO | Remarks |
|-----------------------|----------------------|----------|--------|------|------|-----------|----|---------|
| (Randall CO: COD8C/2) | Randall CO: COD8C/2A | BDO5(AS) | BFO 24 | 2000 | 1    | 2(5/8)(8) | 1  | 1       |
|                       |                      |          |        |      |      |           |    | 2       |

|                                       |                     |
|---------------------------------------|---------------------|
| <b>As Built</b>                       |                     |
| <b>Consolidated Telephone Company</b> |                     |
| Name:                                 | COD8C-04            |
| WO:                                   | Randall - 2012 FTTH |
| Exch:                                 | Randall             |
| Route:                                | COD8C               |
| ROW:                                  | 50'                 |
| State:                                | Minnesota           |
| County:                               | Morrison            |
| Range:                                | 31W                 |
| Twsp:                                 | 130N Section: 12    |
| Township:                             | Parker              |
| Staked By:                            | ZBG Date: 5/2011    |
| Revised By:                           | CLP Date: 6/14/12   |
| Revised By:                           | RF Date: 11/26/12   |
| Revised By:                           | Date:               |
| As-Built By:                          | CLP Date: 2/14/13   |

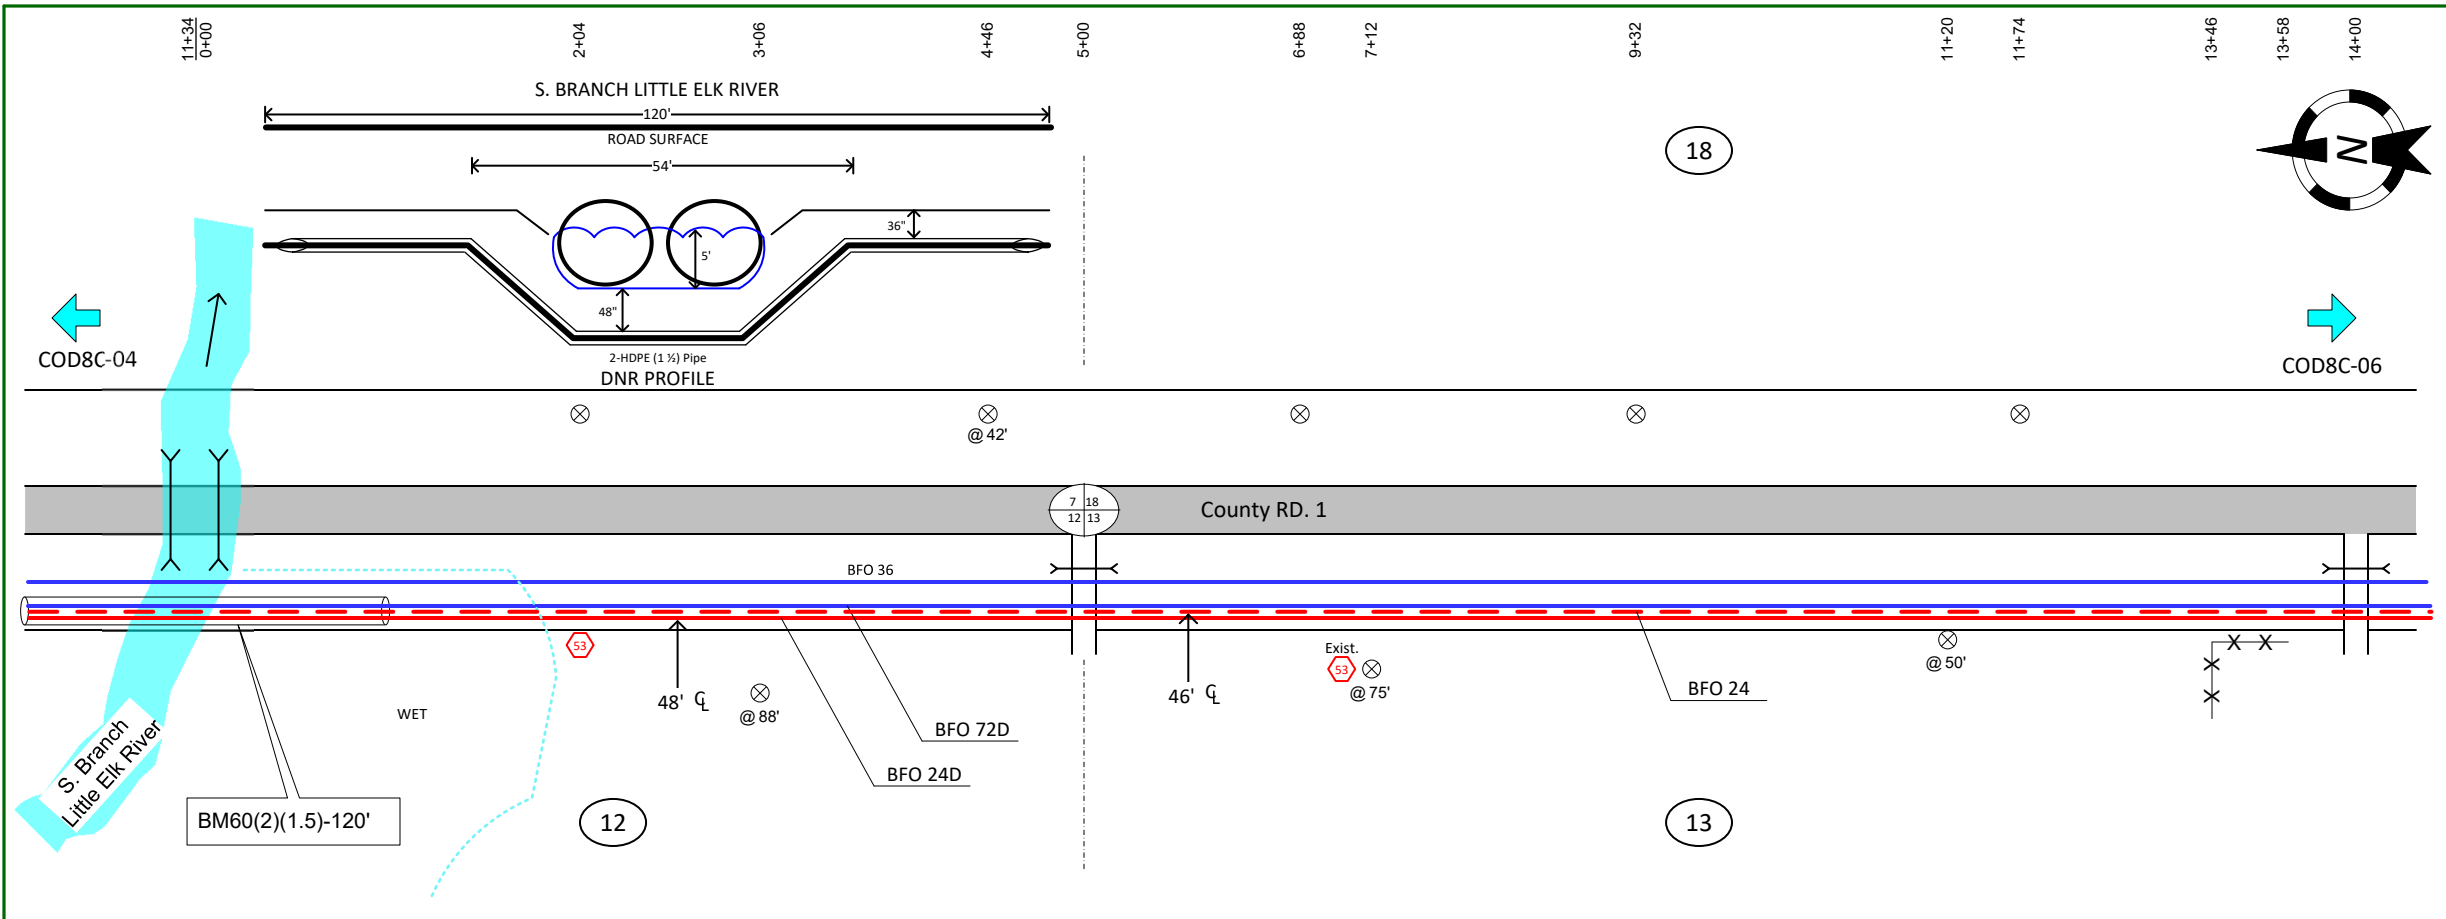

| From | To | PType | Units | Feet | Remarks   |
|------|----|-------|-------|------|---|
|      |    |       |       |      | Dig up on each side of river and find Existing 1.5" duct and shove new cable through. |

|                                       |                     |
|---------------------------------------|---------------------|
| <b>As Built</b>                       |                     |
| <b>Consolidated Telephone Company</b> |                     |
| Name:                                 | COD8C-05            |
| WO:                                   | Randall - 2012 FTTH |
| Exch:                                 | Randall             |
| Route:                                | COD8C               |
| ROW:                                  | 50'                 |
| State:                                | Minnesota           |
| County:                               | Morrison            |
| Range:                                | 31W                 |
| Twsp:                                 | 130N Section: 12/13 |
| Township: Parker                      |                     |
| Staked By:                            | ZBG Date: 5/2011    |
| Revised By:                           | CLP Date: 6/15/12   |
| Revised By:                           | RF Date: 11/26/12   |
| Revised By:                           | Date:               |
| As-Built By:                          | CLP Date: 2/14/13   |

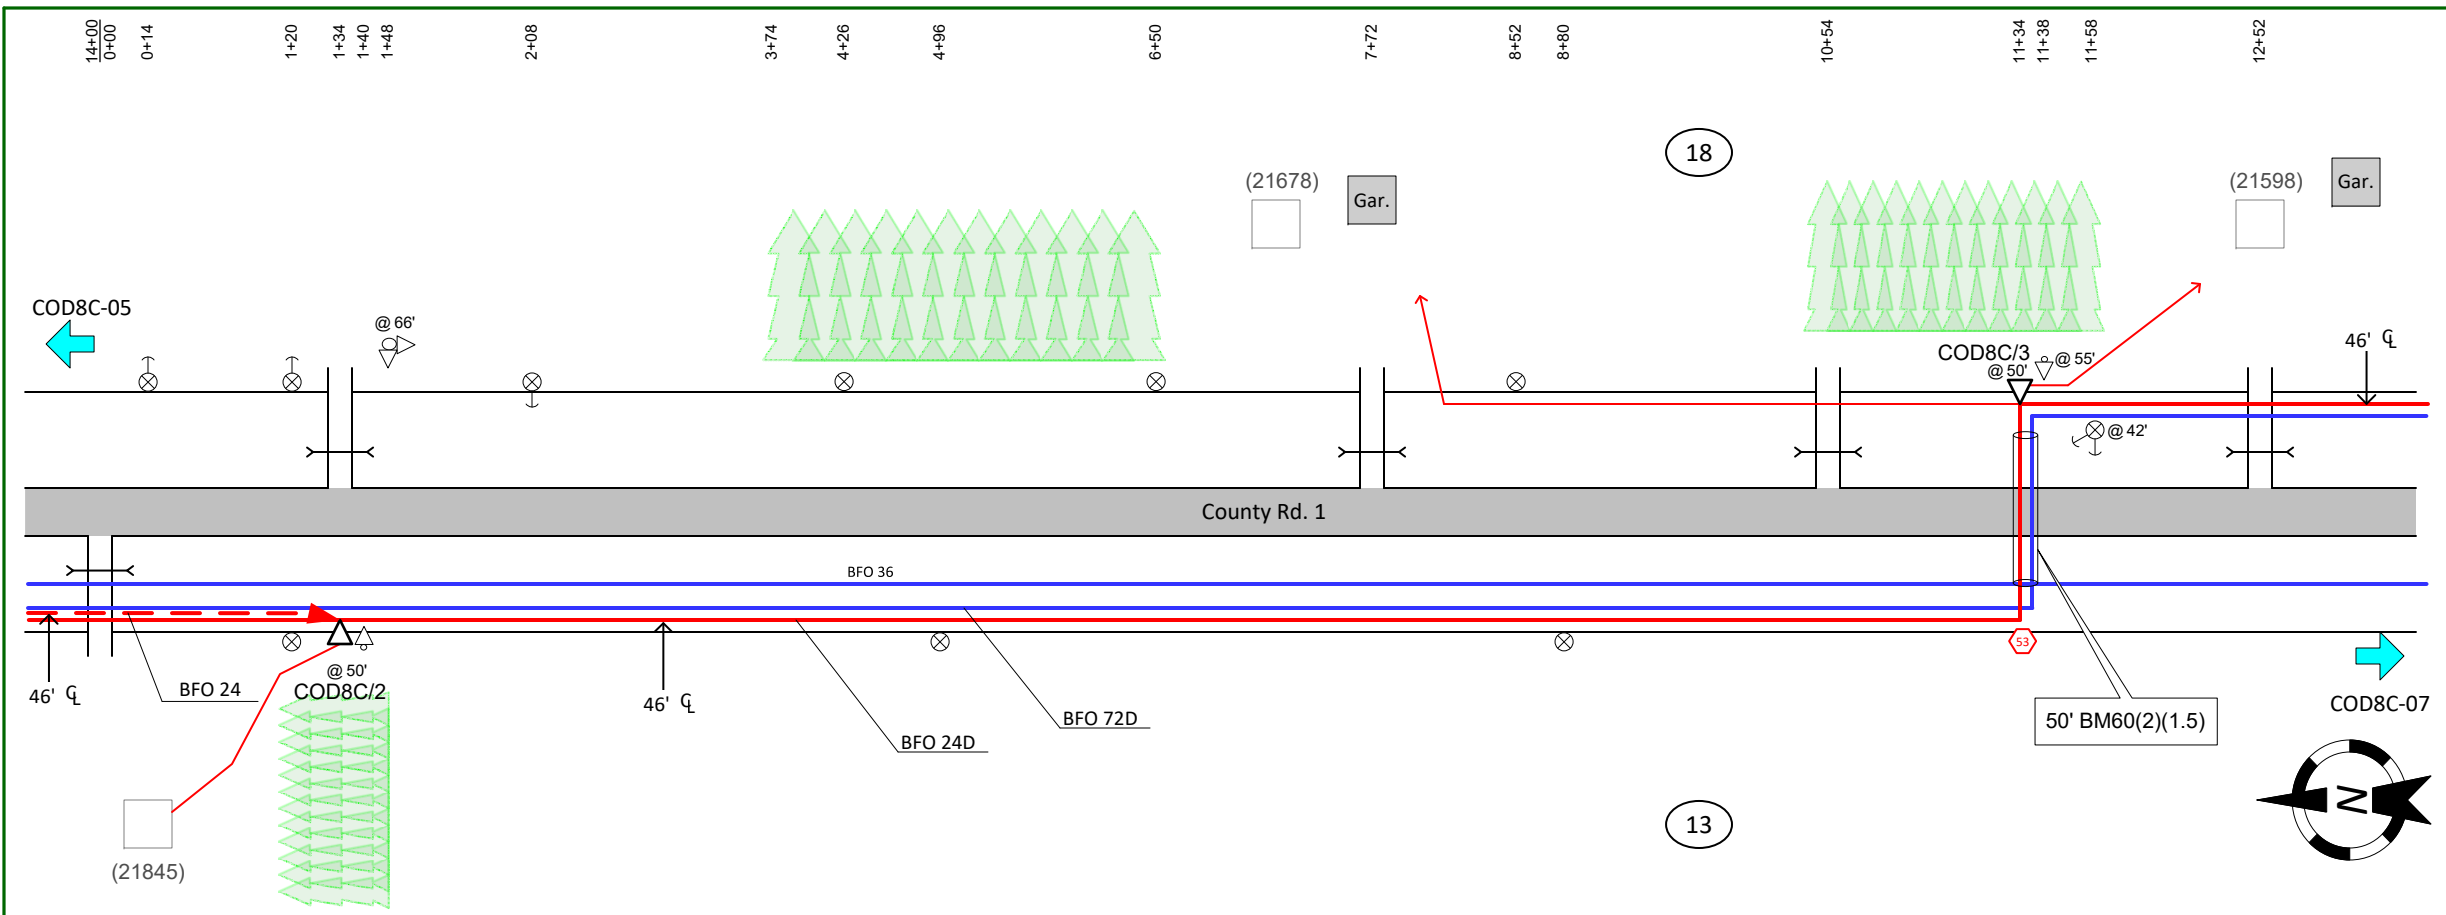

| From                  | To                  | PType    | Units   | Feet | BM             | HO  | Remarks |
|-----------------------|---------------------|----------|---------|------|----------------|-----|---------|
| (Randall CO: COD8C/1) | Randall CO: COD8C/2 | BDO4(SG) | BFO 72D | 4534 | 2(5/8)(8) 1    |     |         |
|                       | Randall CO: COD8C/2 |          | BFO 24D | 4564 | 53 4           |     |         |
| Randall CO: COD8C/2   | Randall CO: COD8C/2 | BDO4(SG) |         |      | 60(2)(1.5) 120 |     |         |
|                       | Randall CO: COD8C/3 |          | BFO 72D | 1062 | 2(5/8)(8) 1    | 1 2 |         |
|                       | Randall CO: COD8C/3 |          | BFO 24D | 1096 | 53 2           |     |         |
|                       | Randall CO: COD8C/3 |          |         |      | 60(2)(1.5) 50  |     |         |

| As Built                              |                     |
|---------------------------------------|---------------------|
| <b>Consolidated Telephone Company</b> |                     |
| Name:                                 | COD8C-06            |
| WO:                                   | Randall - 2012 FTTH |
| Exch:                                 | Randall             |
| Route:                                | COD8C               |
| ROW:                                  | 50'                 |
| State:                                | Minnesota           |
| County:                               | Morrison            |
| Range:                                | 31W                 |
| Twsp:                                 | 130N Section: 13    |
| Township:                             | Parker              |
| Staked By:                            | ZBG Date: 5/2011    |
| Revised By:                           | CLP Date: 6/15/12   |
| Revised By:                           | RF Date: 11/26/12   |
| Revised By:                           | Date:               |
| As-Built By:                          | CLP Date: 2/14/13   |