


From	To	PType	Units	Feet	BM	HO	Remarks
(COD/8V)	COD8C/1	BDO4(SG)	BFO 72D	1840	2(5/8)(Ø)	1	Splice for 22641
(COD/8)	COD8C/1		BFO 24D	1858	53	1	

As Built
Consolidated Telephone Company
 Name: **COD8C-02**
 WO: **Randall - 2012 FTTH**
 Exch: **Randall**
 Route: **COD8C**
 ROW: **33'**
 State: **Minnesota**
 County: **Morrison**
 Range: **31W**
 Twsp: **130N Section: 12**
 Township: **Parker**


Staked By: **ZBG** Date: **5/2011**
 Revised By: **CLP** Date: **6/14/12**
 Revised By: **RF** Date: **11/26/12**
 Revised By: _____ Date: _____
 As-Built By: **CLP** Date: **2/14/13**

Sheet No. **2** of **14**

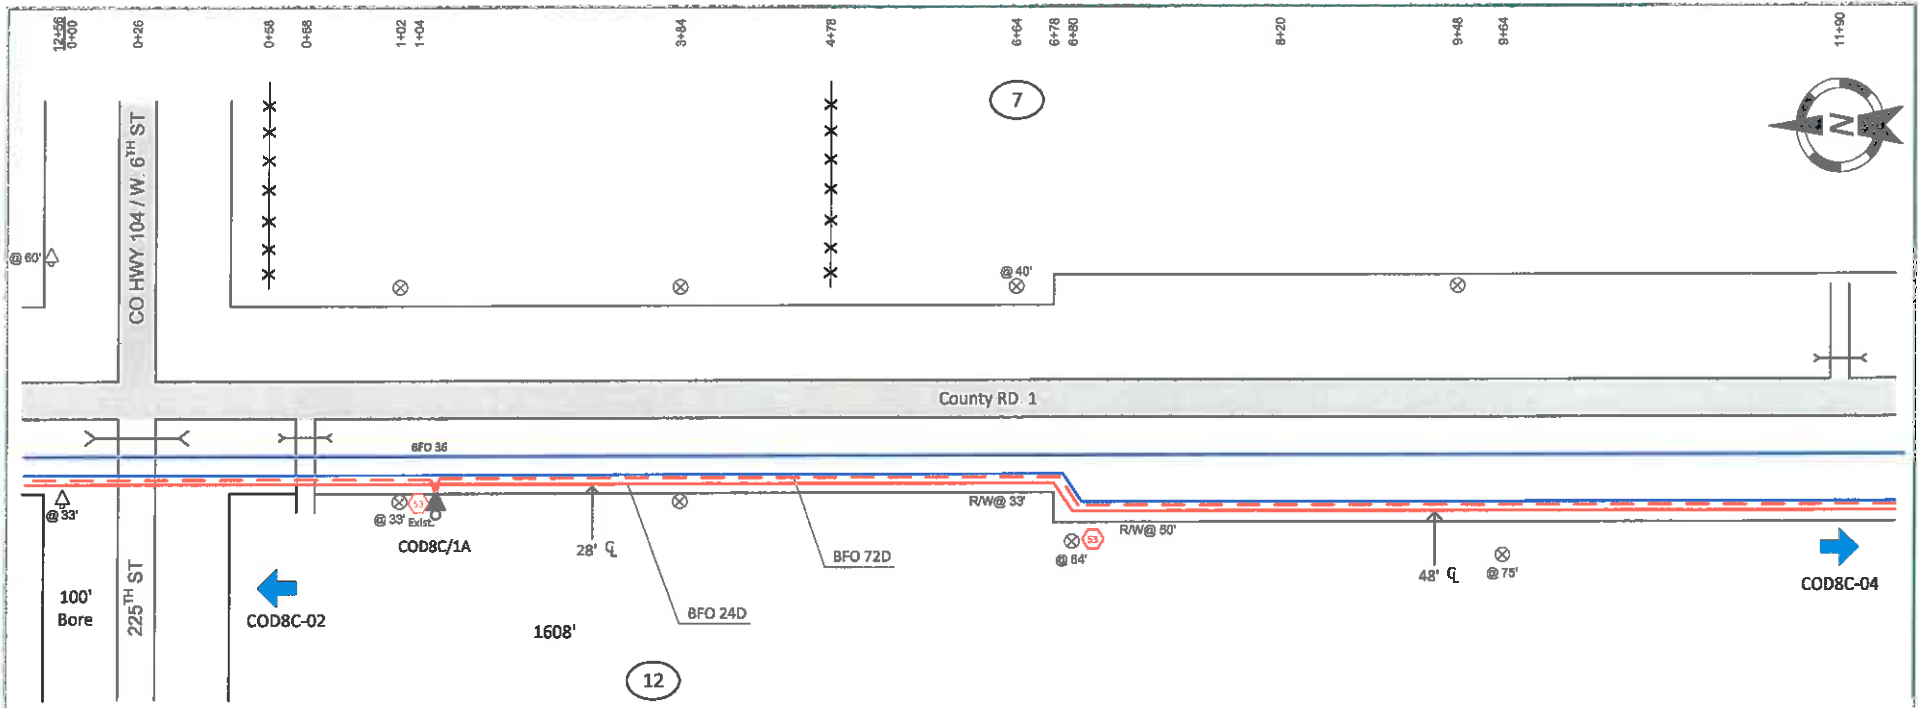

From	To	PType	Units	Feet	BM	HB	HO	Remarks
(Randall CO: COD8C/1)	Randall CO: COD8C/2	BHF(30x48x36)T	BFO 72 & BFO 24 D	1794	2(5/8)(8)	1	FO(72)(M)	
	Randall CO: COD8C/2				53	1		

As Built Consolidated Telephone Company
Company
Name: COD8C-03
WO: Randall - 2012 FTTH
Exch: Randall
Route: COD8C
ROW: 33'
State: Minnesota
County: Morrison
Range: 31W
Twsp: 130N Section: 12
Township: Parker
Staked By: ZBG **Date:** 6/2011
Revised By: CLP **Date:** 6/14/12
Revised By: RF **Date:** 11/28/12
Revised By: _____ **Date:** _____
As-Built By: CLP **Date:** 2/13/13

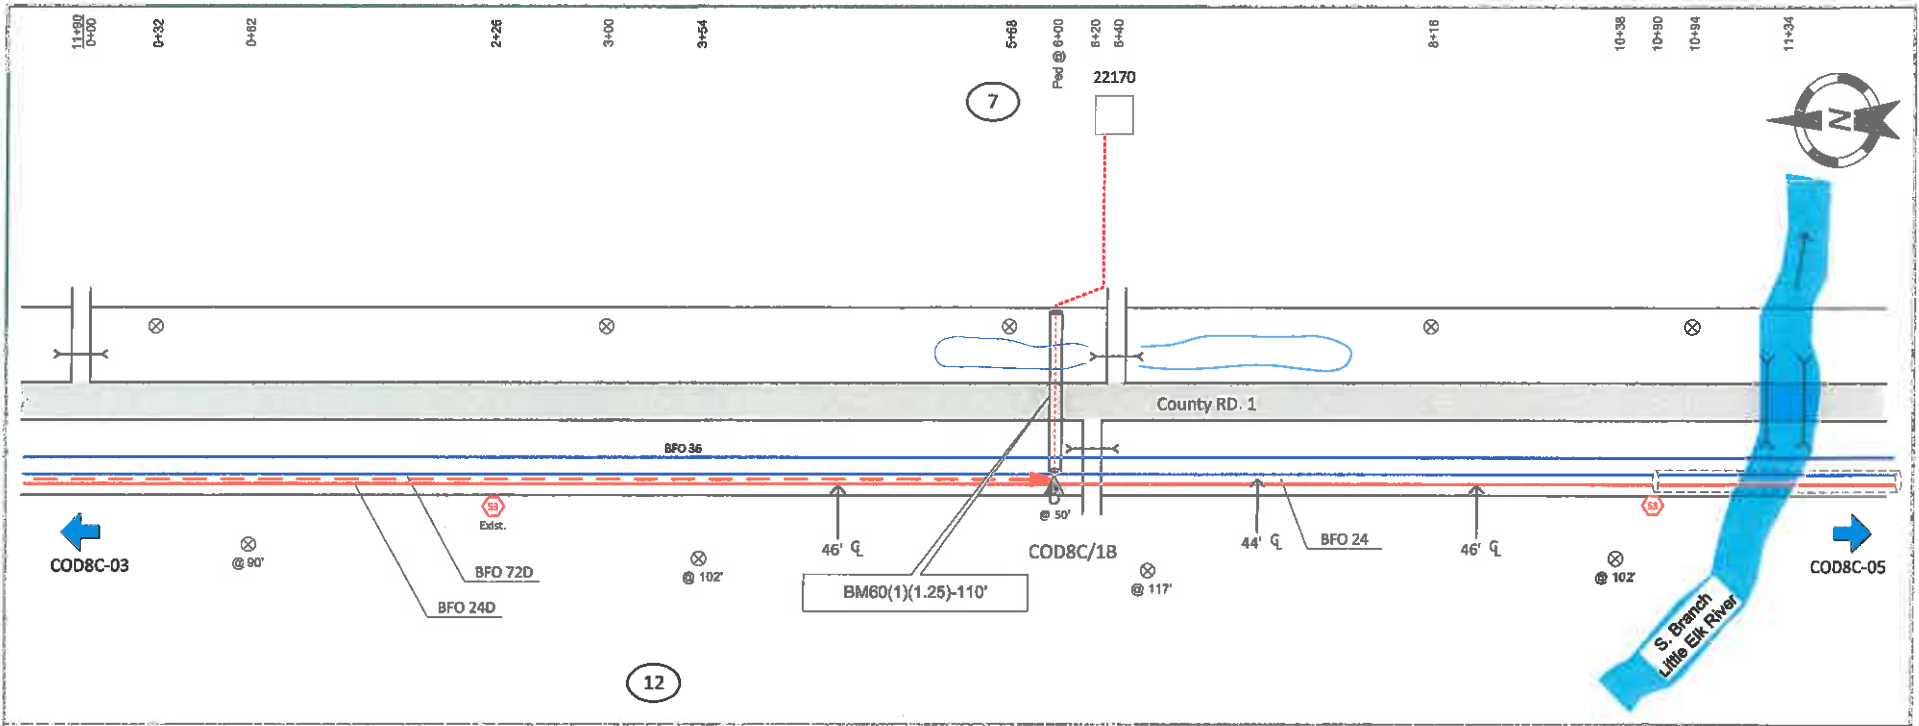


From	To	PType	Units	Feet	BA 4	BM	HO	Remarks
(Randall CO: COD8C/2)	Randall CO: COD8C/2A	BDO5(AS)	BFO 24	2000	1	2(5/8)(8)	1	1 2

As Built
Consolidated Telephone Company
COD8C-04

Name: COD8C-04
WO: Randall - 2012 FTTH
Exch: Randall
Route: COD8C
ROW: 50'
State: Minnesota
County: Morrison
Range: 31W
Twsp: 130N Section: 12
Township: Parker

Staked By: ZBG Date: 5/2011
Revised By: CLP Date: 8/14/12
Revised By: RF Date: 11/28/12
Revised By: _____ Date: _____
As-Built By: CLP Date: 2/14/13

Sheet No. 4 of 14

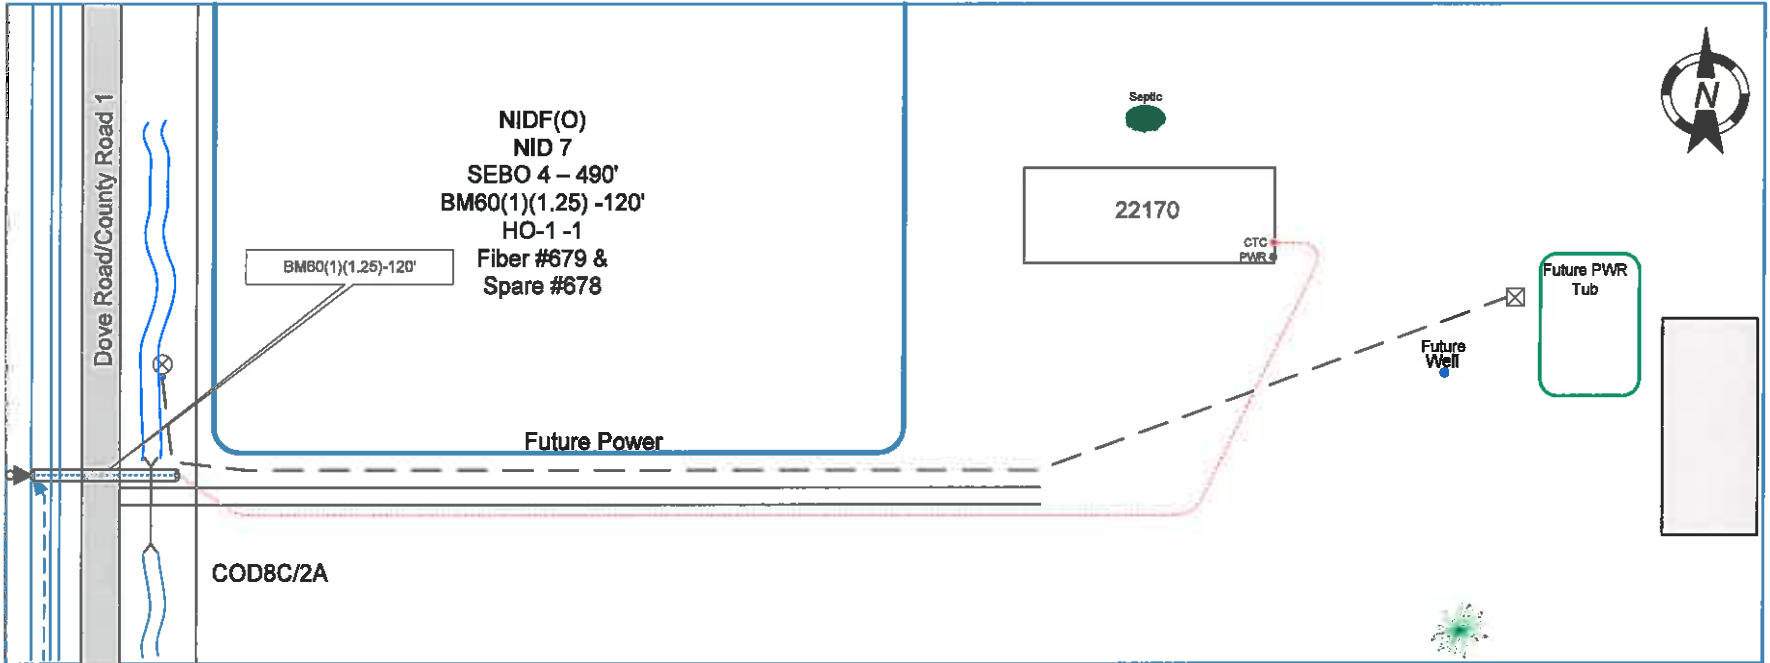

FROM	TO	BA																	

Staking Sheet
Consolidated Telephone Company
Name: 22170 Dove Road
WO: 2019-Randall
Exch: ILEC
Route: COD8C/2B
ROW: House Drop
State: Minnesota
County: Morrison
Range: 31W
Twsp: 130N Section: 7
Township: _____
Staked By: EDB **Date:** 8-5-19
Revised By: _____ **Date:** _____
Revised By: _____ **Date:** _____
Revised By: _____ **Date:** _____
As-Built By: _____ **Date:** _____