


GENERAL LOCATION ONLY. DO NOT USE TO LOCATE FOR EXCAVATION. CALL 1-800-252-1166 FOR ONSITE LOCATIONS AND STAKING.

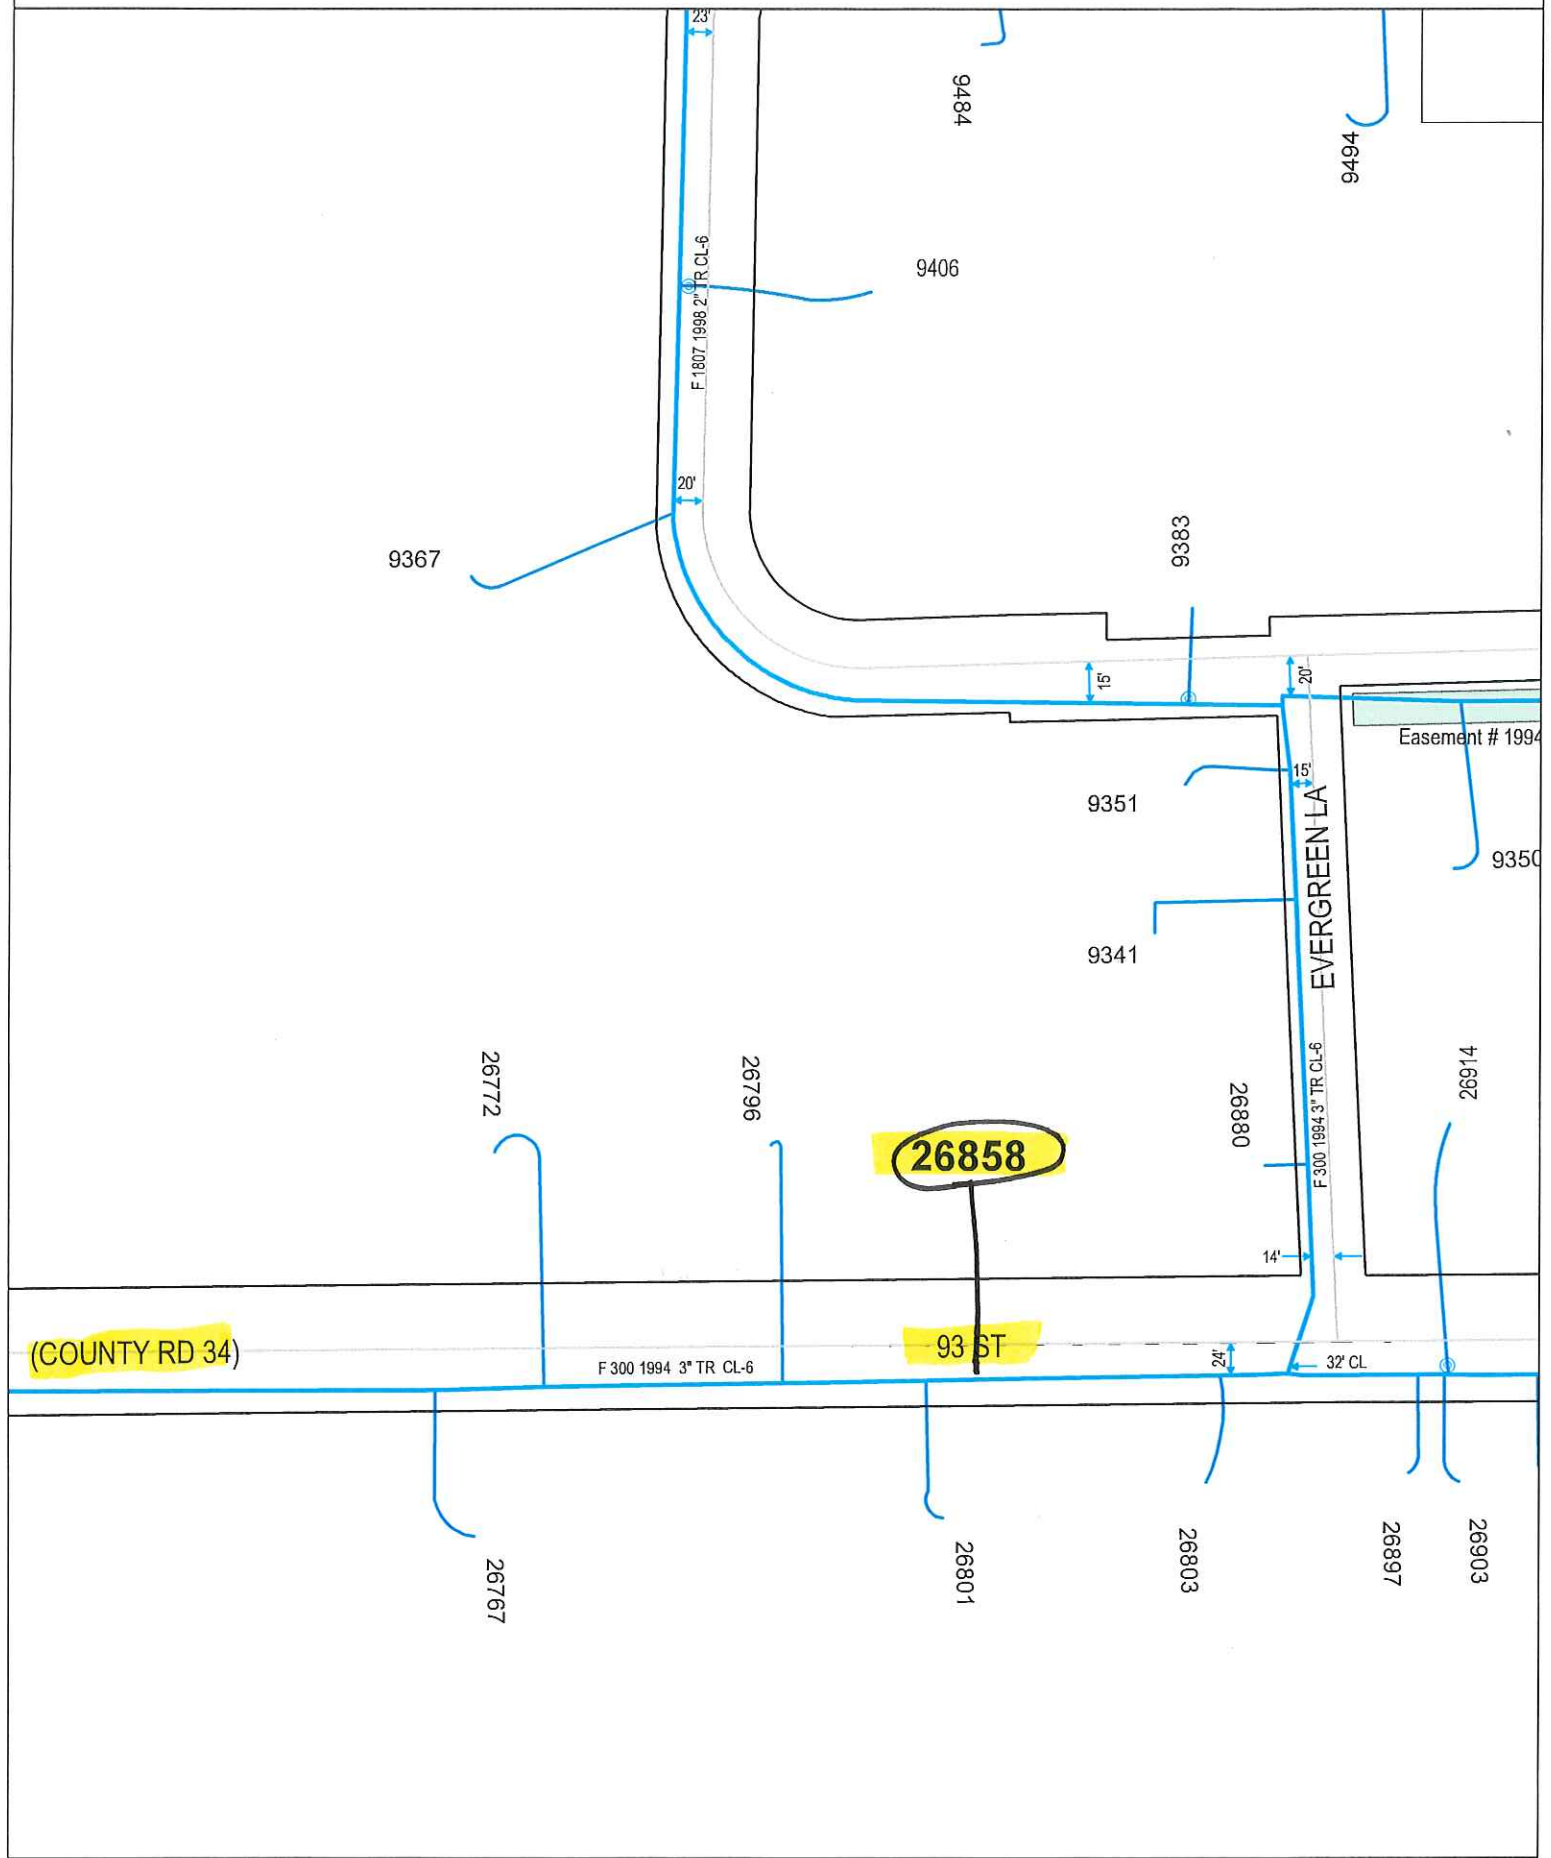

Plotted by: i222382

Plot Date: 9/30/2019

26858 93RD ST (MORRISON CO RD 34)

BUCKMAN, MN 56364

Scale: 1" : 100'

