


GENERAL LOCATION ONLY.  
DO NOT USE TO LOCATE FOR EXCAVATION.  
CALL 1-800-252-1166 FOR ONSITE LOCATIONS AND STAKING.



Scale: 1" : 174'

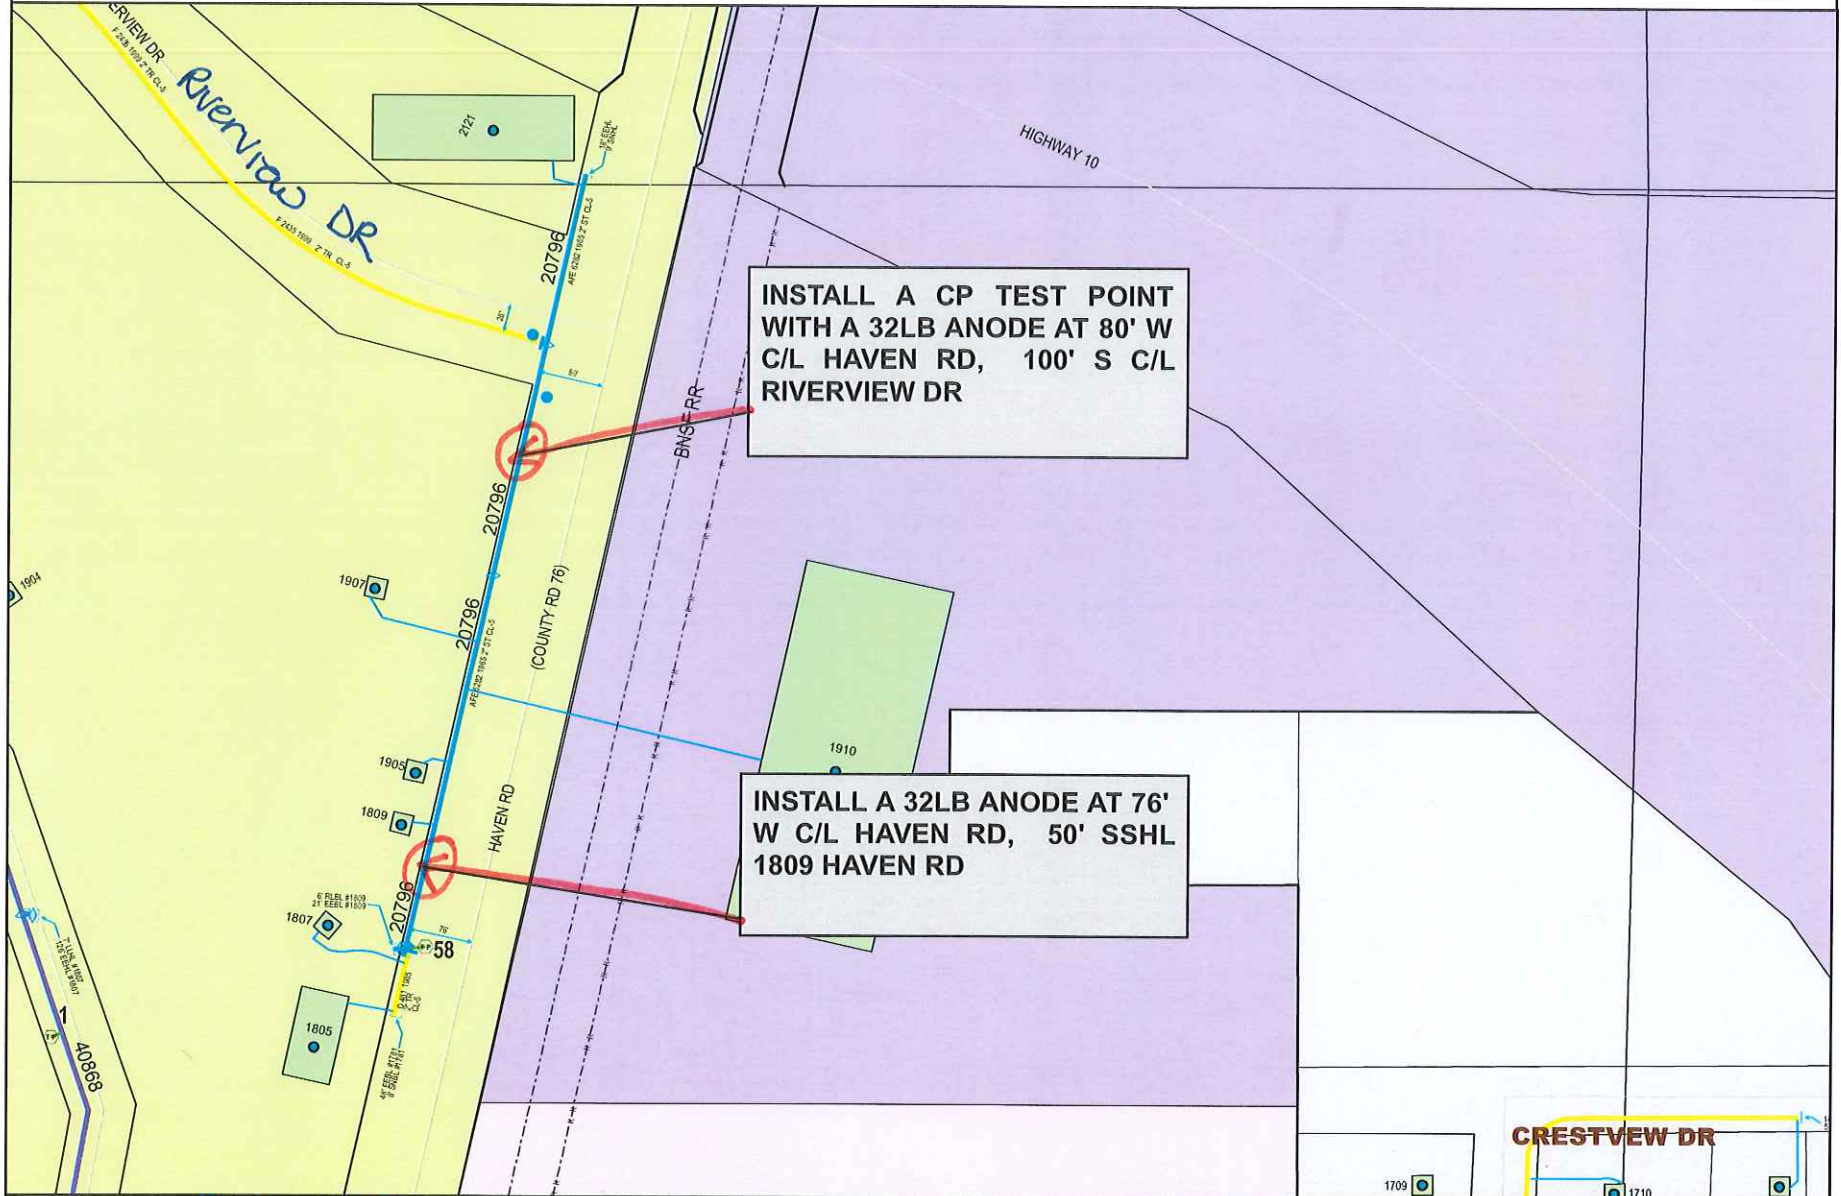

Work Order #: 92441132  
Design Date: 12-17-2019

City: LITTLE FALLS  
Quad/Sec/Twp/Rng: NW SEC-35 /T-41 /R-32

CP Section #: 20796  
CP Area: AL1549-3

Designed By: P TEESELINK  
Designer Phone #: 612 910 1378