

Project: E.384351  
WC NAME: LITTLE FALLS  
WC ID: LFLMNLF  
Design Eng: Ben Buchholz  
Telephone: 3202558533  
Issue:  
Issue Date:  
Plot Ref.:


CONFIDENTIAL Disclose and Distribute  
Solely To CenturyLink Employees Having  
a Need to Know.

Reason for Reissue:

140<sup>TH</sup> AVE

Permit to dig approx 2'  
of cable from existing  
app case post to existing  
pedestal.

Sec: 32  
Twn: 130N  
Rng: 29W

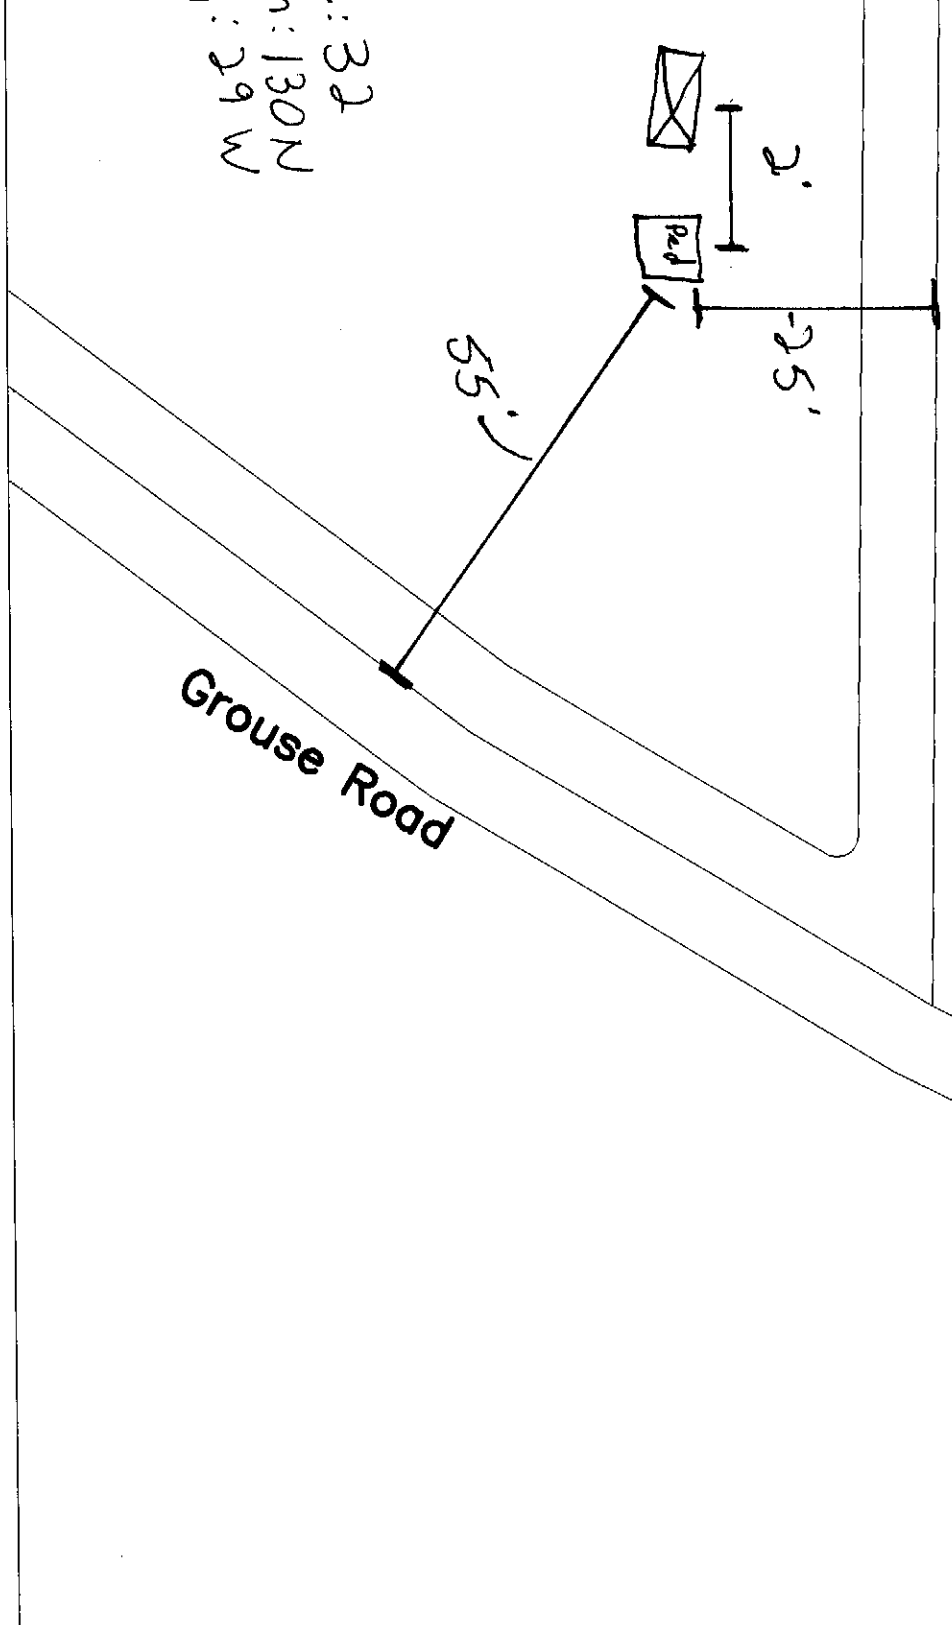

Eng:  
E.384351  
Ben Buchholz  
(320) 255-8533