


Revised 4-4-2019				CMS#		19208248					
CenturyLink BSW Order/Maintenance Work Authorization											
Company	T600	Exchange Name	LTFLMNLF			Service Order#	vn191276				
Work Activity				Capital	Maintenance						
Customer Name	Josh Gibbs			Phone#							
Address	15221 hawthorn rd			One Call Ticket#							
City & Zip	little falls										
Location/Directions											
Description of Work or Special Instructions											
Held Order	Y	N	Permit:	Y	N	Bore:	Y	N	CBR#		
Tech Name and Tech #	Robert 343					Employee Contact#	320-291-9640				
Sketch <small>(Include Cntr Line & Pedestal)</small>	Material/Labor Units					Footage/Quantity	Comments				
	Description			Notes							
Cntr Line foot	SEB3-22			BSW-3 & plow plcmt		720					
	SEB3-22T			BSW-3 & hand dig plcmt							
Ped#	SEPCUTOVER			CUTOVER BSW		1					
Parish/County	BM83			BSW guard at house							
Morrison	XXSEB-GL			Remove temp drop		750	Footage when temp can't be re-used				
Township:	t40n	BM61(1.25)SEB			BSW Bore footage						
Section	9	SEBO PER FT LBR			Fiber & plow plcmt						
Range	r32w	SEBO PER FT LBR T			Fiber & hand dig plcmt						
	SEB6-22			BSW-6 & plow plcmt							
	BM2(5/8)(8)			Ground Rod							
	Trip Charge			Trip Charge							
	Permit			Permit			Any placement within the ROW requires a permit				
Nearest cross st.	153rd st					Plat Page		Map#			

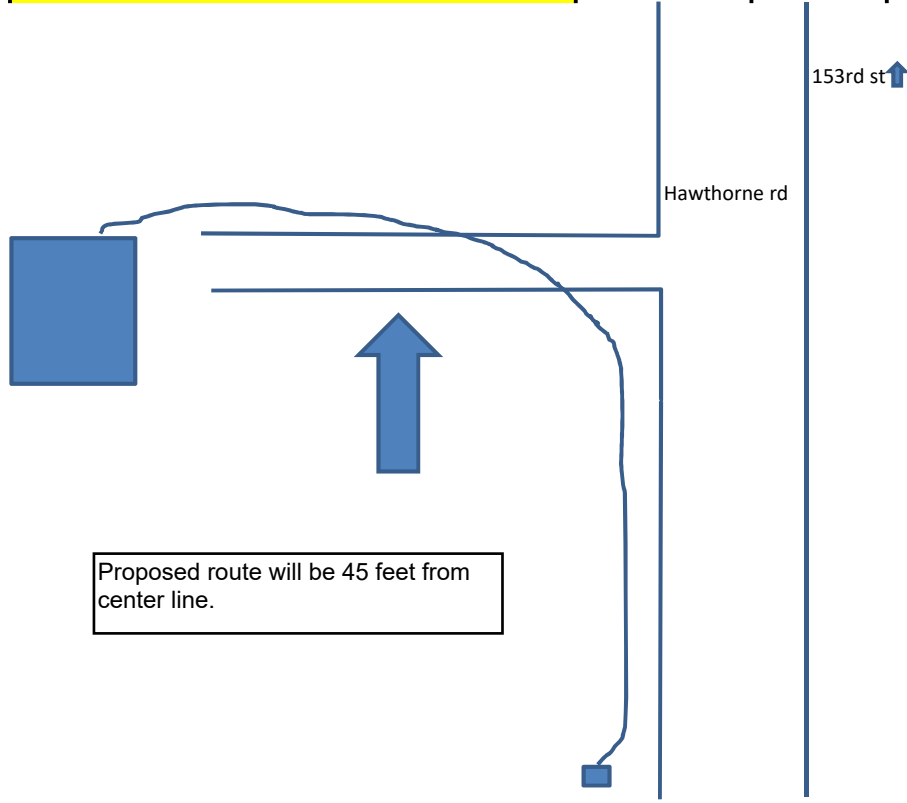

Originated By:	Robert	Date:		Completed By:		Date:	
Authorized By: (APS)		Date:		Inspected By:		Date:	
Authorized By: (AOM)		Date:					
Email sketch to:	MetroBSW@Centurylink.com						

1. Distance of the bury in Right-of-Way		3. Distance to the nearest intersection	
2. Distance from the terminal to the centerline		4. Nearest State Hwy mile marker	