

FROM	TO	BA													

Staking Sheet	
Consolidated Telephone Company	
Name:	16801
WO:	2020-Sullivan
Exch:	I L E C
Route:	2C/24
ROW:	Drop
State:	Minnesota
County:	Morrison
Range:	
Twsp:	Section: _____
Township:	City of Hillman
Staked By:	JP Date: 4/20/20
Revised By:	____ Date: _____
Revised By:	____ Date: _____
Revised By:	____ Date: _____
As-Built By:	____ Date: _____
Sheet No.	1 of 1

CTC Map Update/Service Order Form



Tech Name:

Date:

Exchange:

Contact #

Service Area:


Secondary Contact #

Customer Name:

Address:

Notes:

Drawing Area

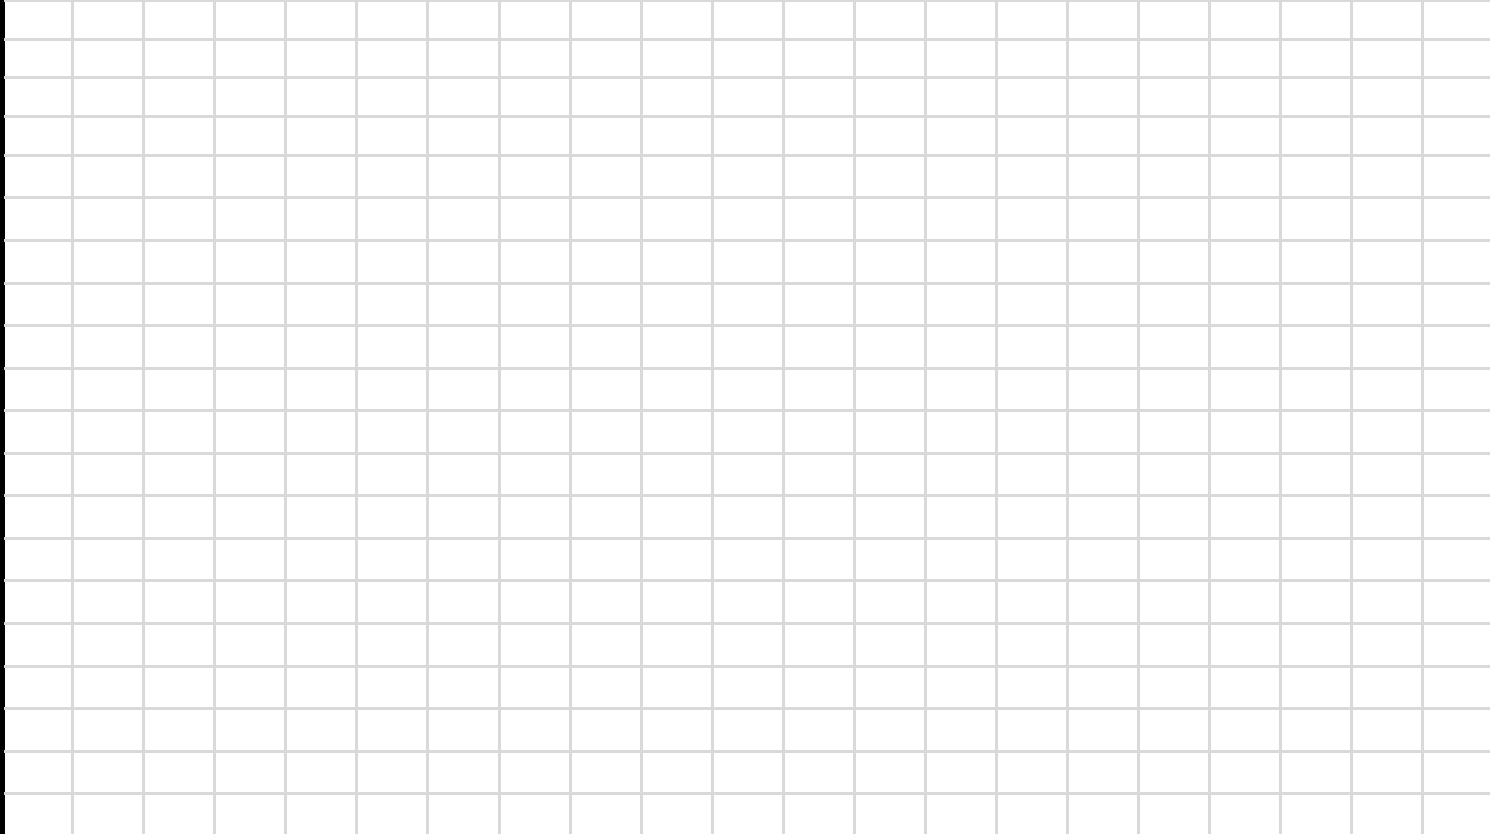

CTC Material Inventory			Project Description					
CTC#	QTY.	Units/Part Description	QTY.		CTC#	Units/Part Description	QTY.	
Stub Post						Miscellaneous		
2676		*BA 21, 6.5' Sawn Post						
1245		*BA 3, 8' Round post			5949	Warning Sign, BM 53		
Copper/ Fiber Ped & Hardware					5950	Warning Sign,(test Station),BM 53(TS)		
0630		BD 3/ BDO 3 - Locate Ped			0187	*HC-1, Scotchlok		
1970		BD 4			0778	*Pedestal Integrity Guard (PIG)		
4902		BD 5			5923	*Uraseal-Drain N' Seal Foam 220		
0633		BD 7			5924	*Uraseal-Drain N' Seal Foam 660		
4727		BDO 4			0256	*Uraseal Splice Kit		
4728		BDO5			7110	*Locate Ball, BM55A 3M MM1401-XR		
4915		BDO PON Ped						
4729		Ped Stake with Bolts						
2396		*Stand Off Bracket			Reel#	Cable/ Conduit		
4905		Tunnel Mill Cone			FIBER			QTY.
		*Ped Numbers/ Letters						
Handholes					Start Seq.-		End Seq.-	
4911		BHF (30x48x36)T						
4912		(30x48x36) Cover			Start Seq.-		End Seq.-	
5654		BHF (36x60x36)T						
5655		(36x60x36) Cover			Start Seq.-		End Seq.-	
		BHF (48x48x48)T						
		(48x48x48) Cover			Start Seq.-		End Seq.-	
Grounding								
0206		*5' Ground Rod BM 2 (1/2)x(5)			Start Seq.-		End Seq.-	
2433		*8' Ground Rod BM 2 (5/8)x(8)			COPPER			
0188		*Ground Rod Clamp (Acorn)						
0185		*Split Bolt 5893/5897			Start Seq.-		End Seq.-	
0197		*Trailer Frame Clamp						
5941		*Meter Ground Clamp 5941/5942			Start Seq.-		End Seq.-	
5895		*External ground connectors (L-70)						
2518		*#6 Solid Bare Grd. Wire (Feet)			Start Seq.-		End Seq.-	
5866		*#6 Solid Coated Grd. Wire (Feet)						
0184		*#6 Bond Harness(Fiber)			Start Seq.-		End Seq.-	
2464		*#14 Bond Harness (Copper)						
0239		*Bullet/Shield Bonds Connector			Start Seq.-		End Seq.-	
5894		*Grounding Strap (Pwr. Mast)						
NID					Start Seq.-		End Seq.-	
0135		*Copper NID						
2981		Fiber NID (720 Residential)			Start Seq.-		End Seq.-	
4559		Fiber NID (760 Commercial)						
2677		*Mounting Board/J-FLASHING			Start Seq.-		End Seq.-	
6892		*1" Riser Guard, BM 83						
0707		*1/2" Riser Guard, BM 83						