


GENERAL LOCATION ONLY. DO NOT USE TO LOCATE FOR EXCAVATION. CALL 1-800-252-1166 FOR ONSITE LOCATIONS AND STAKING.

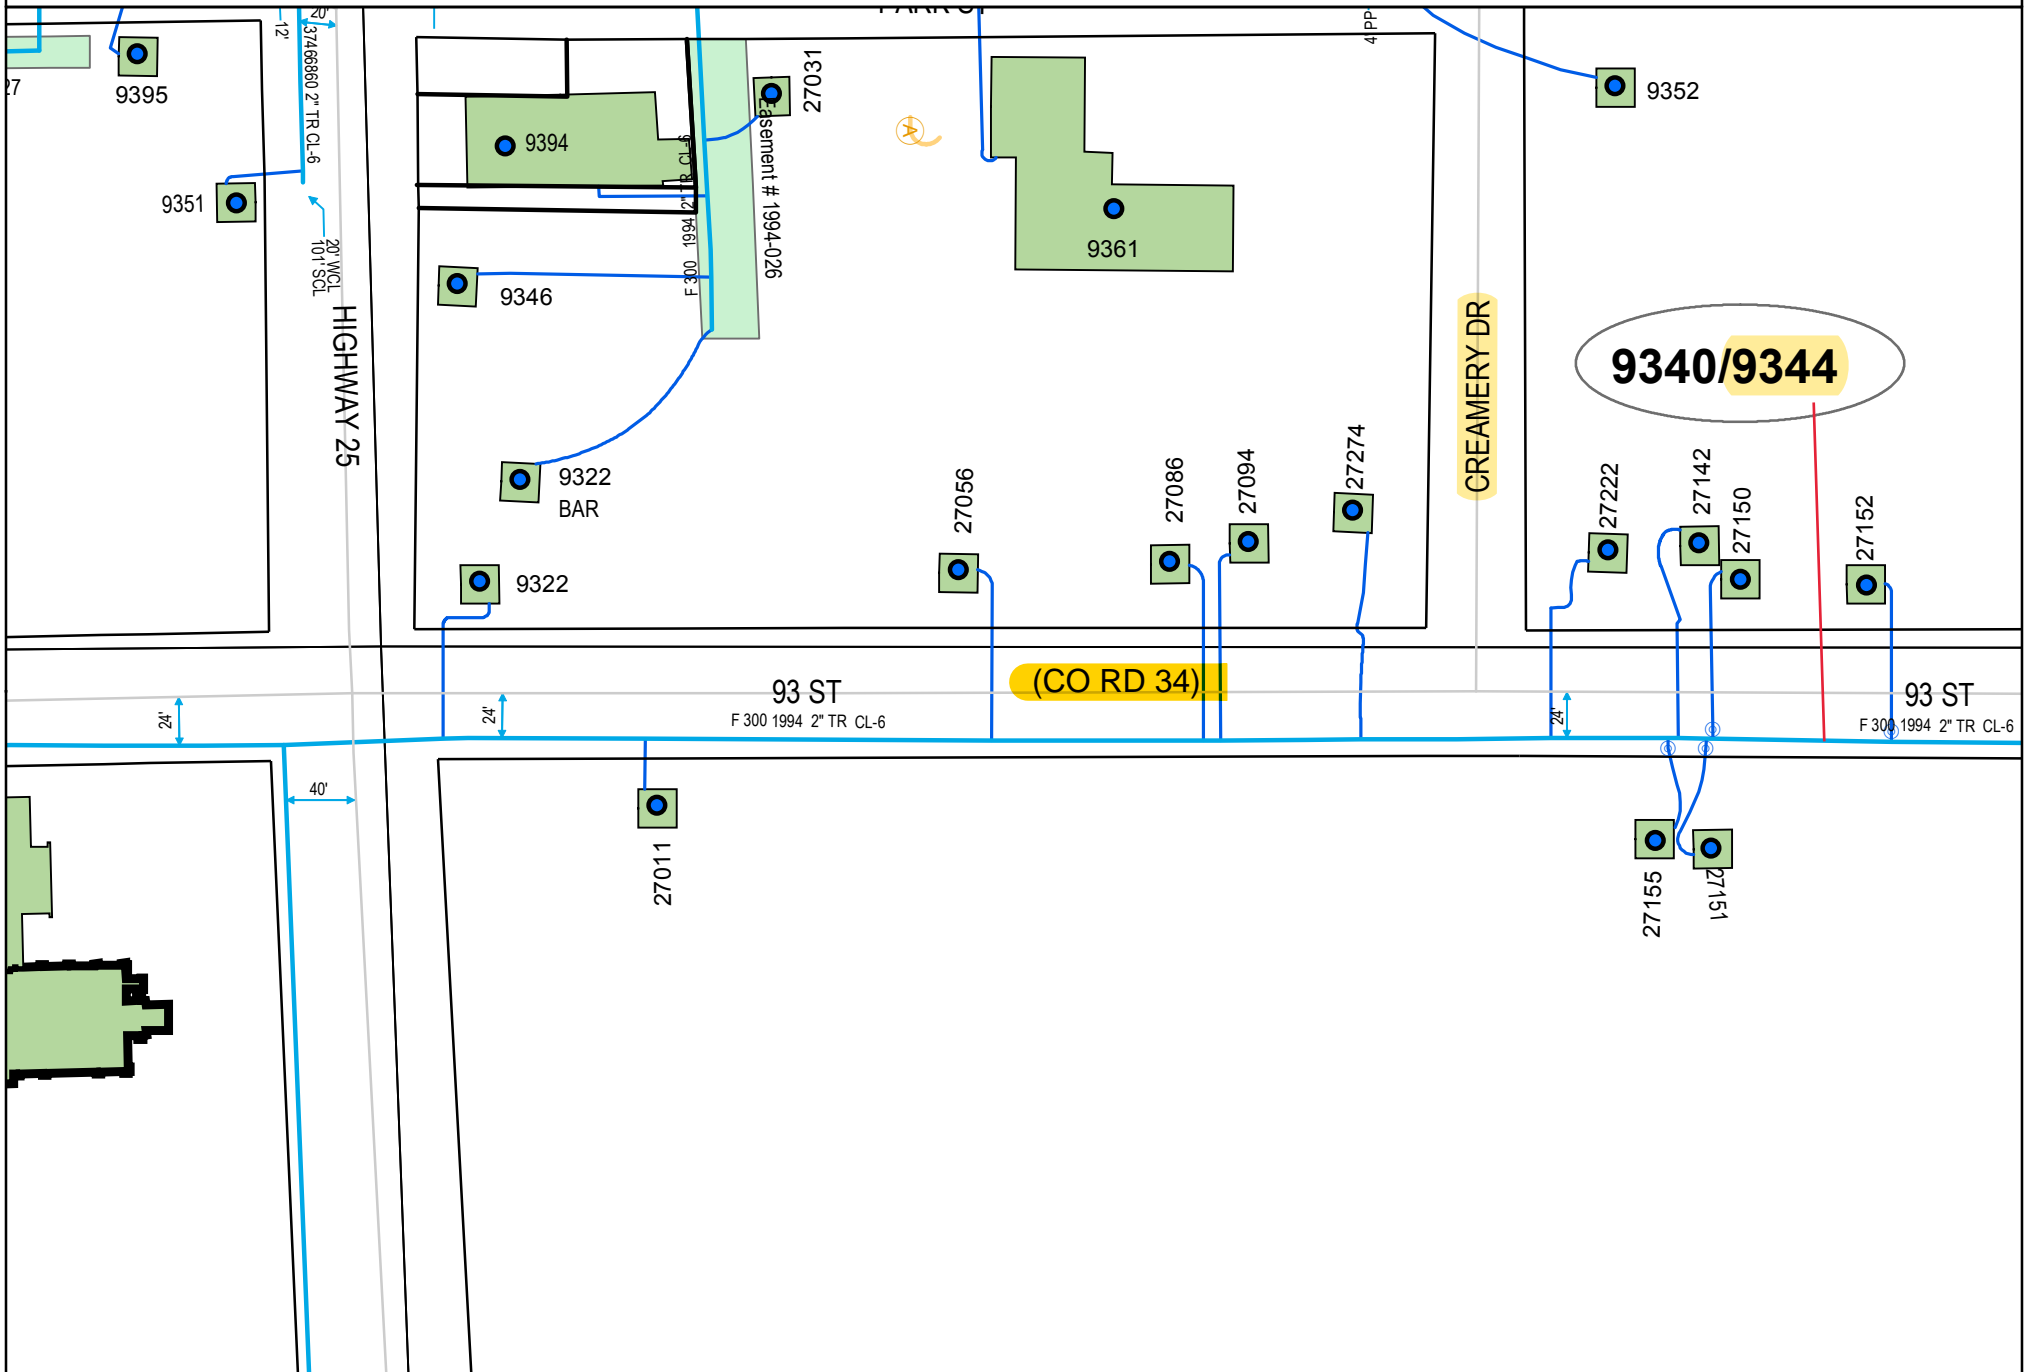

Plotted by: i221539

Plot Date: 9/16/2020

9340 9344 CREAMERY DR (CO RD 34)

BUCKMAN (MORRISON CO)

Scale: 1" : 100'

