


GENERAL LOCATION ONLY. DO NOT USE TO LOCATE FOR EXCAVATION. CALL 1-800-252-1166 FOR ONSITE LOCATIONS AND STAKING.

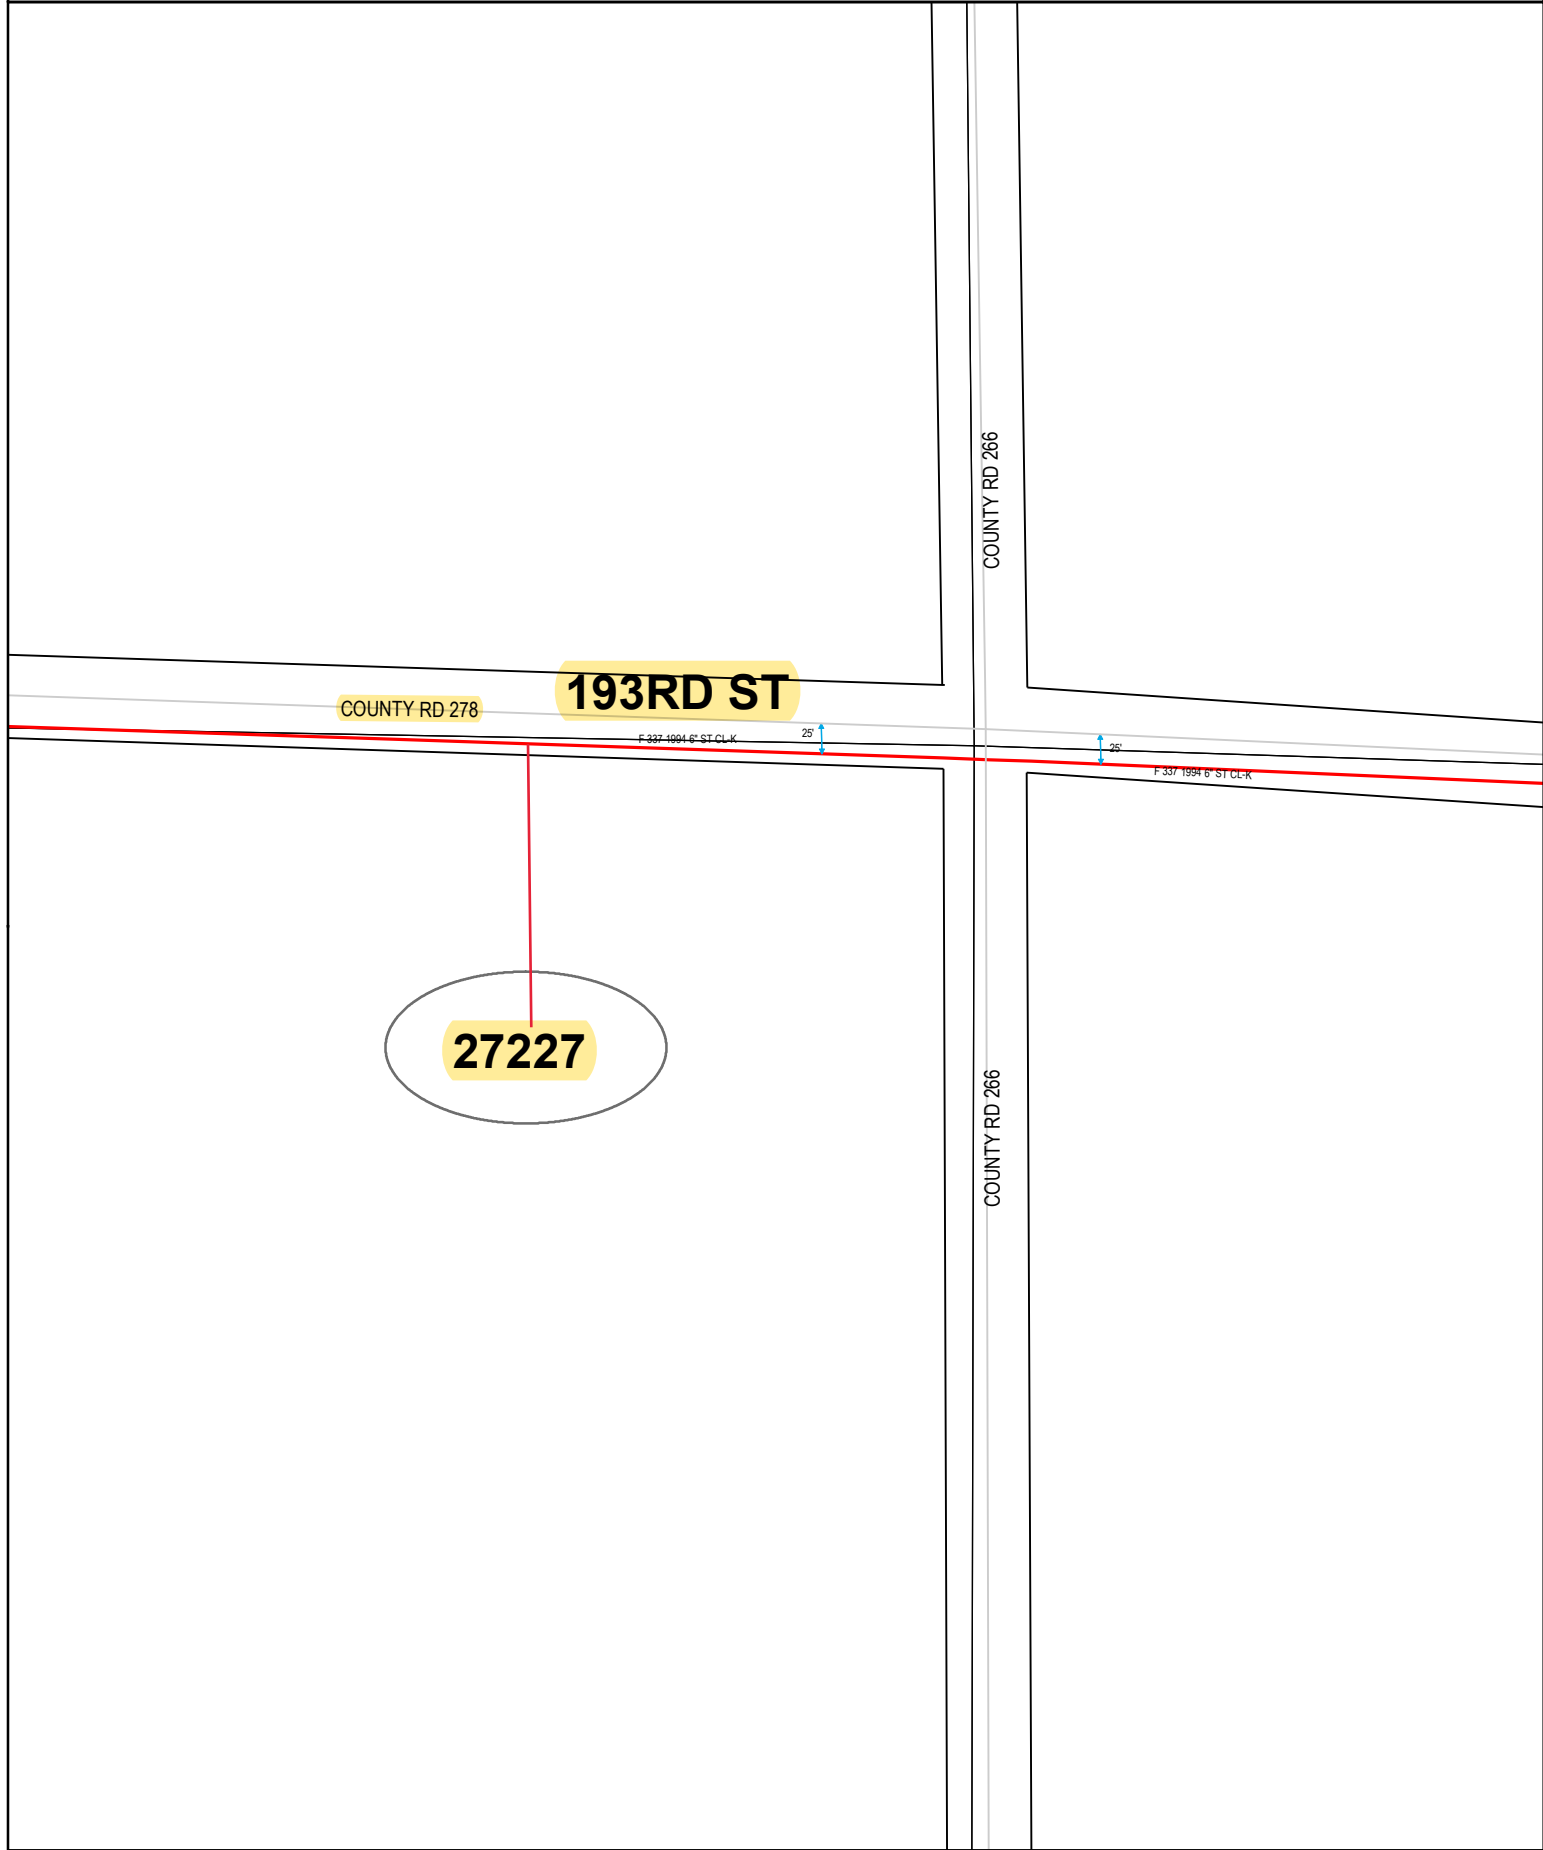

Plotted by: i221539

Plot Date: 11/3/2020

**27227 193RD ST (CO RD 278)**

BUH TWP (MORRISON CO)

Scale: 1" : 150'

