



W.O. 202101791
OH → OH
URD CROSSINGS (2)

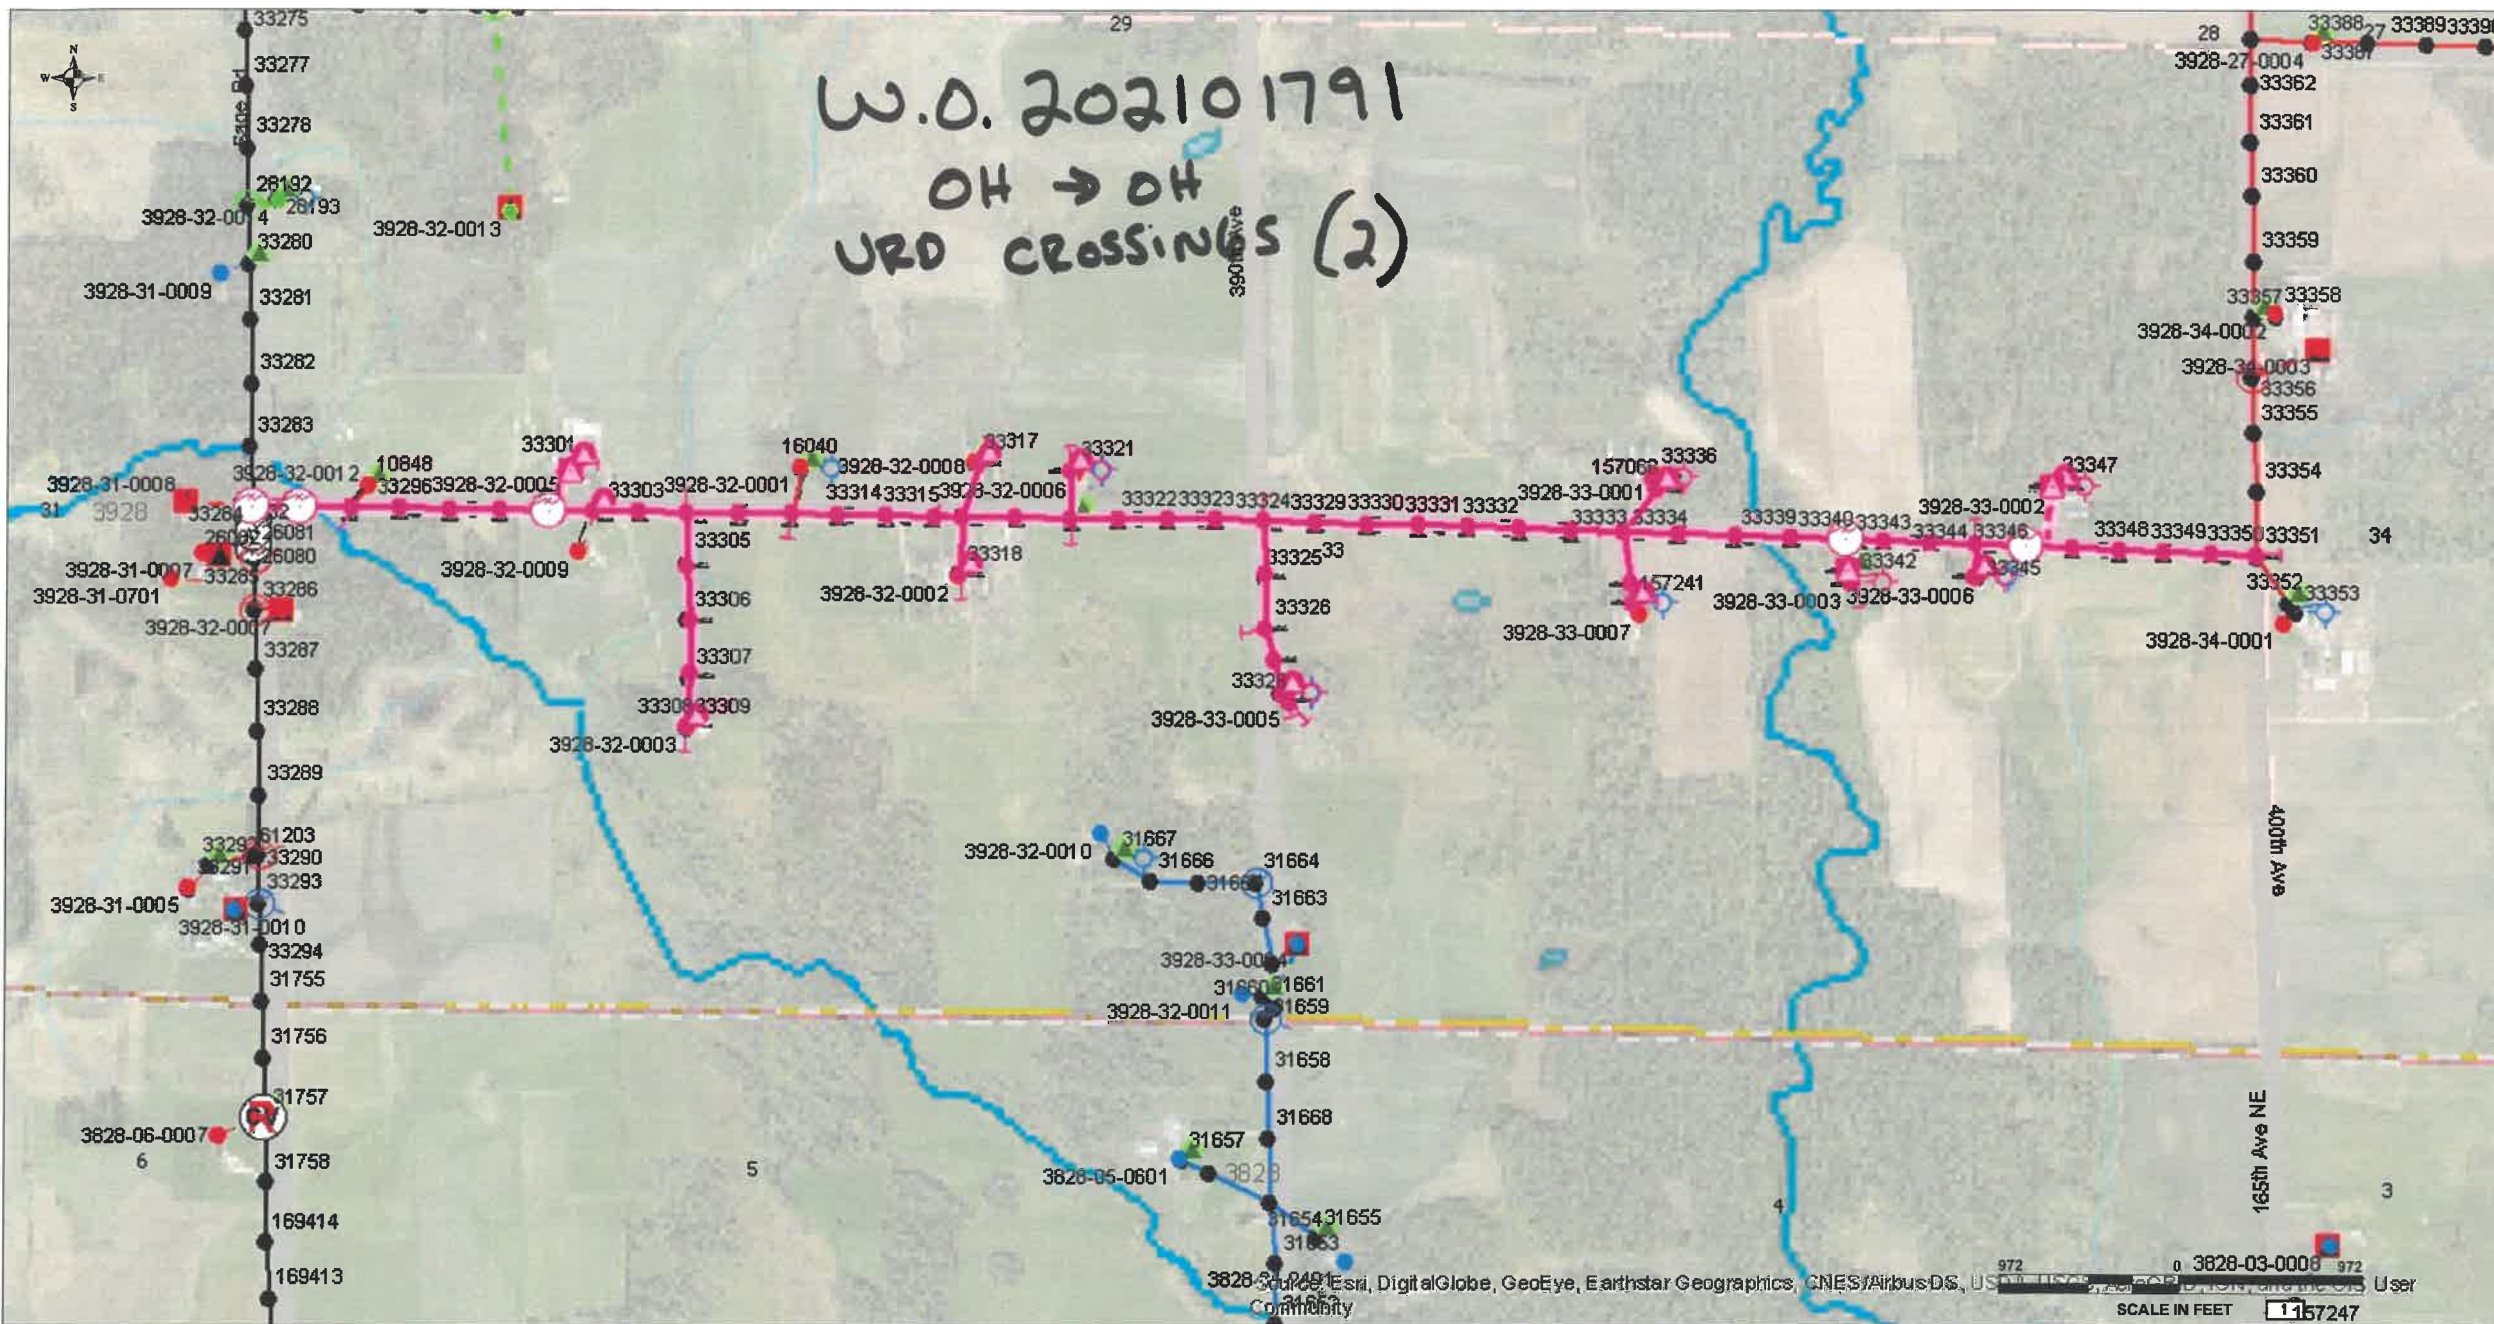


East Central Energy

START OF JOB
EXISTING POLE

NEW UNDERGROUND -
BORE ROAD
60" DEEP

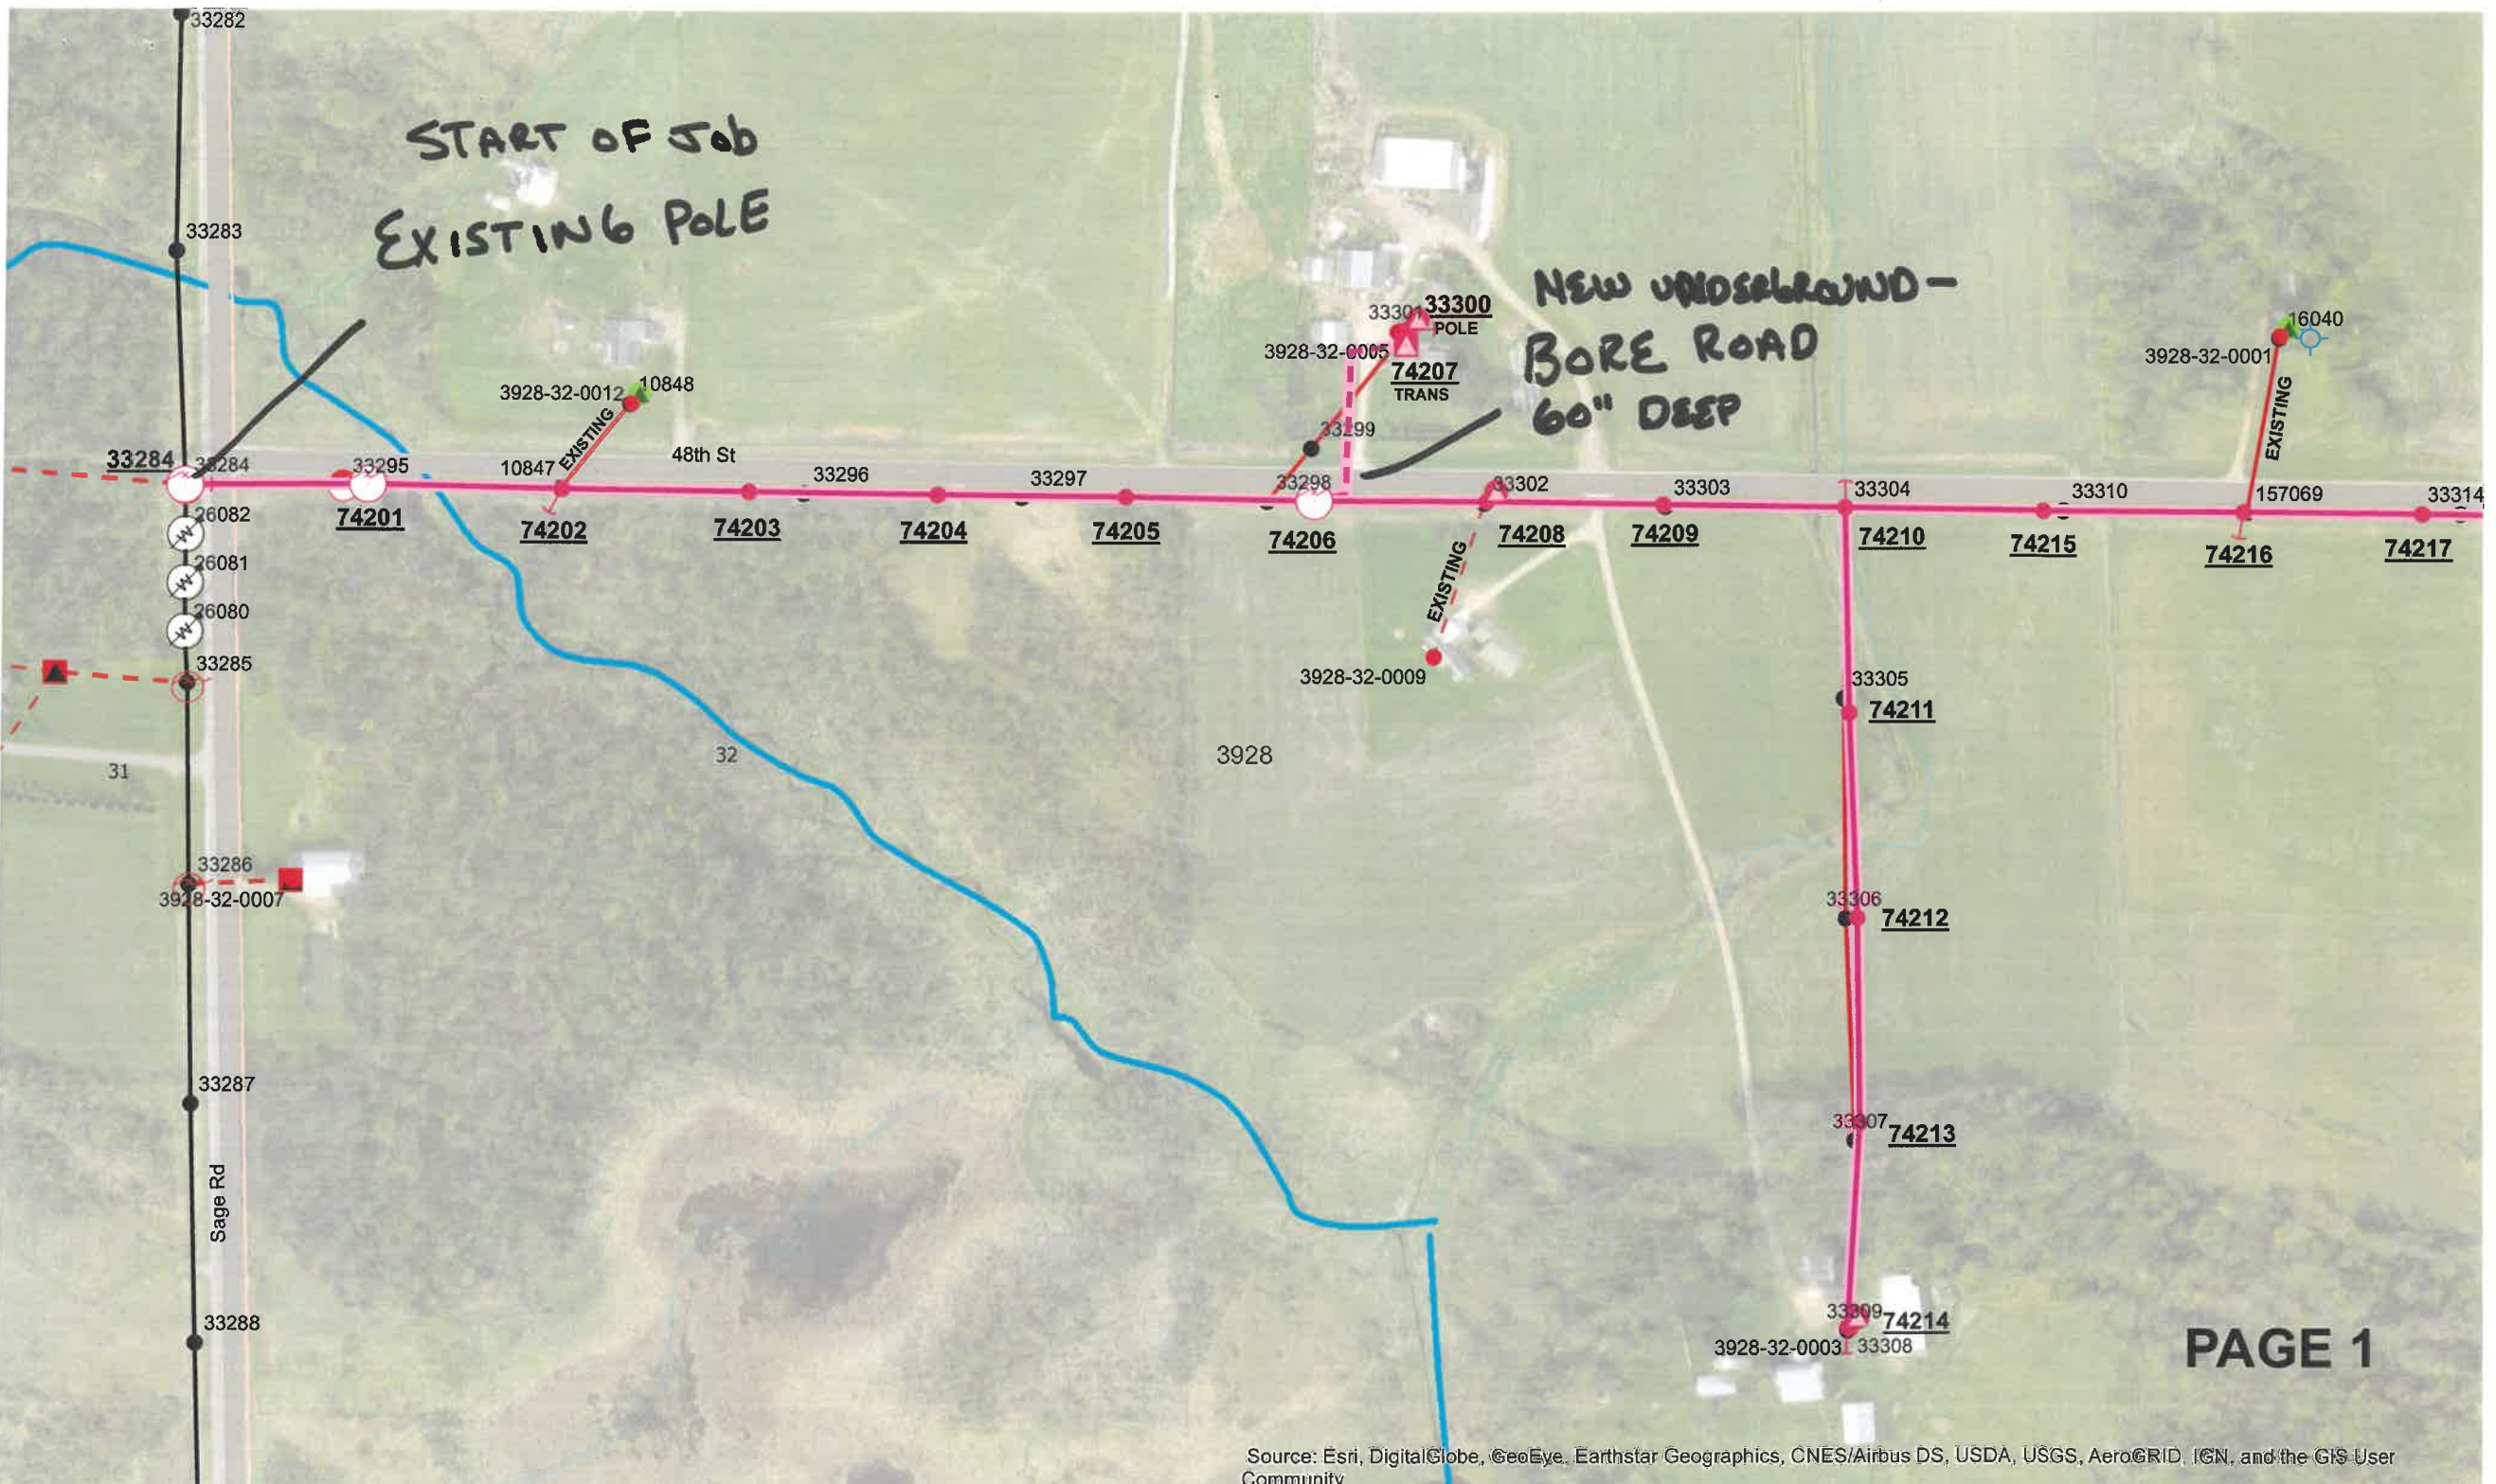

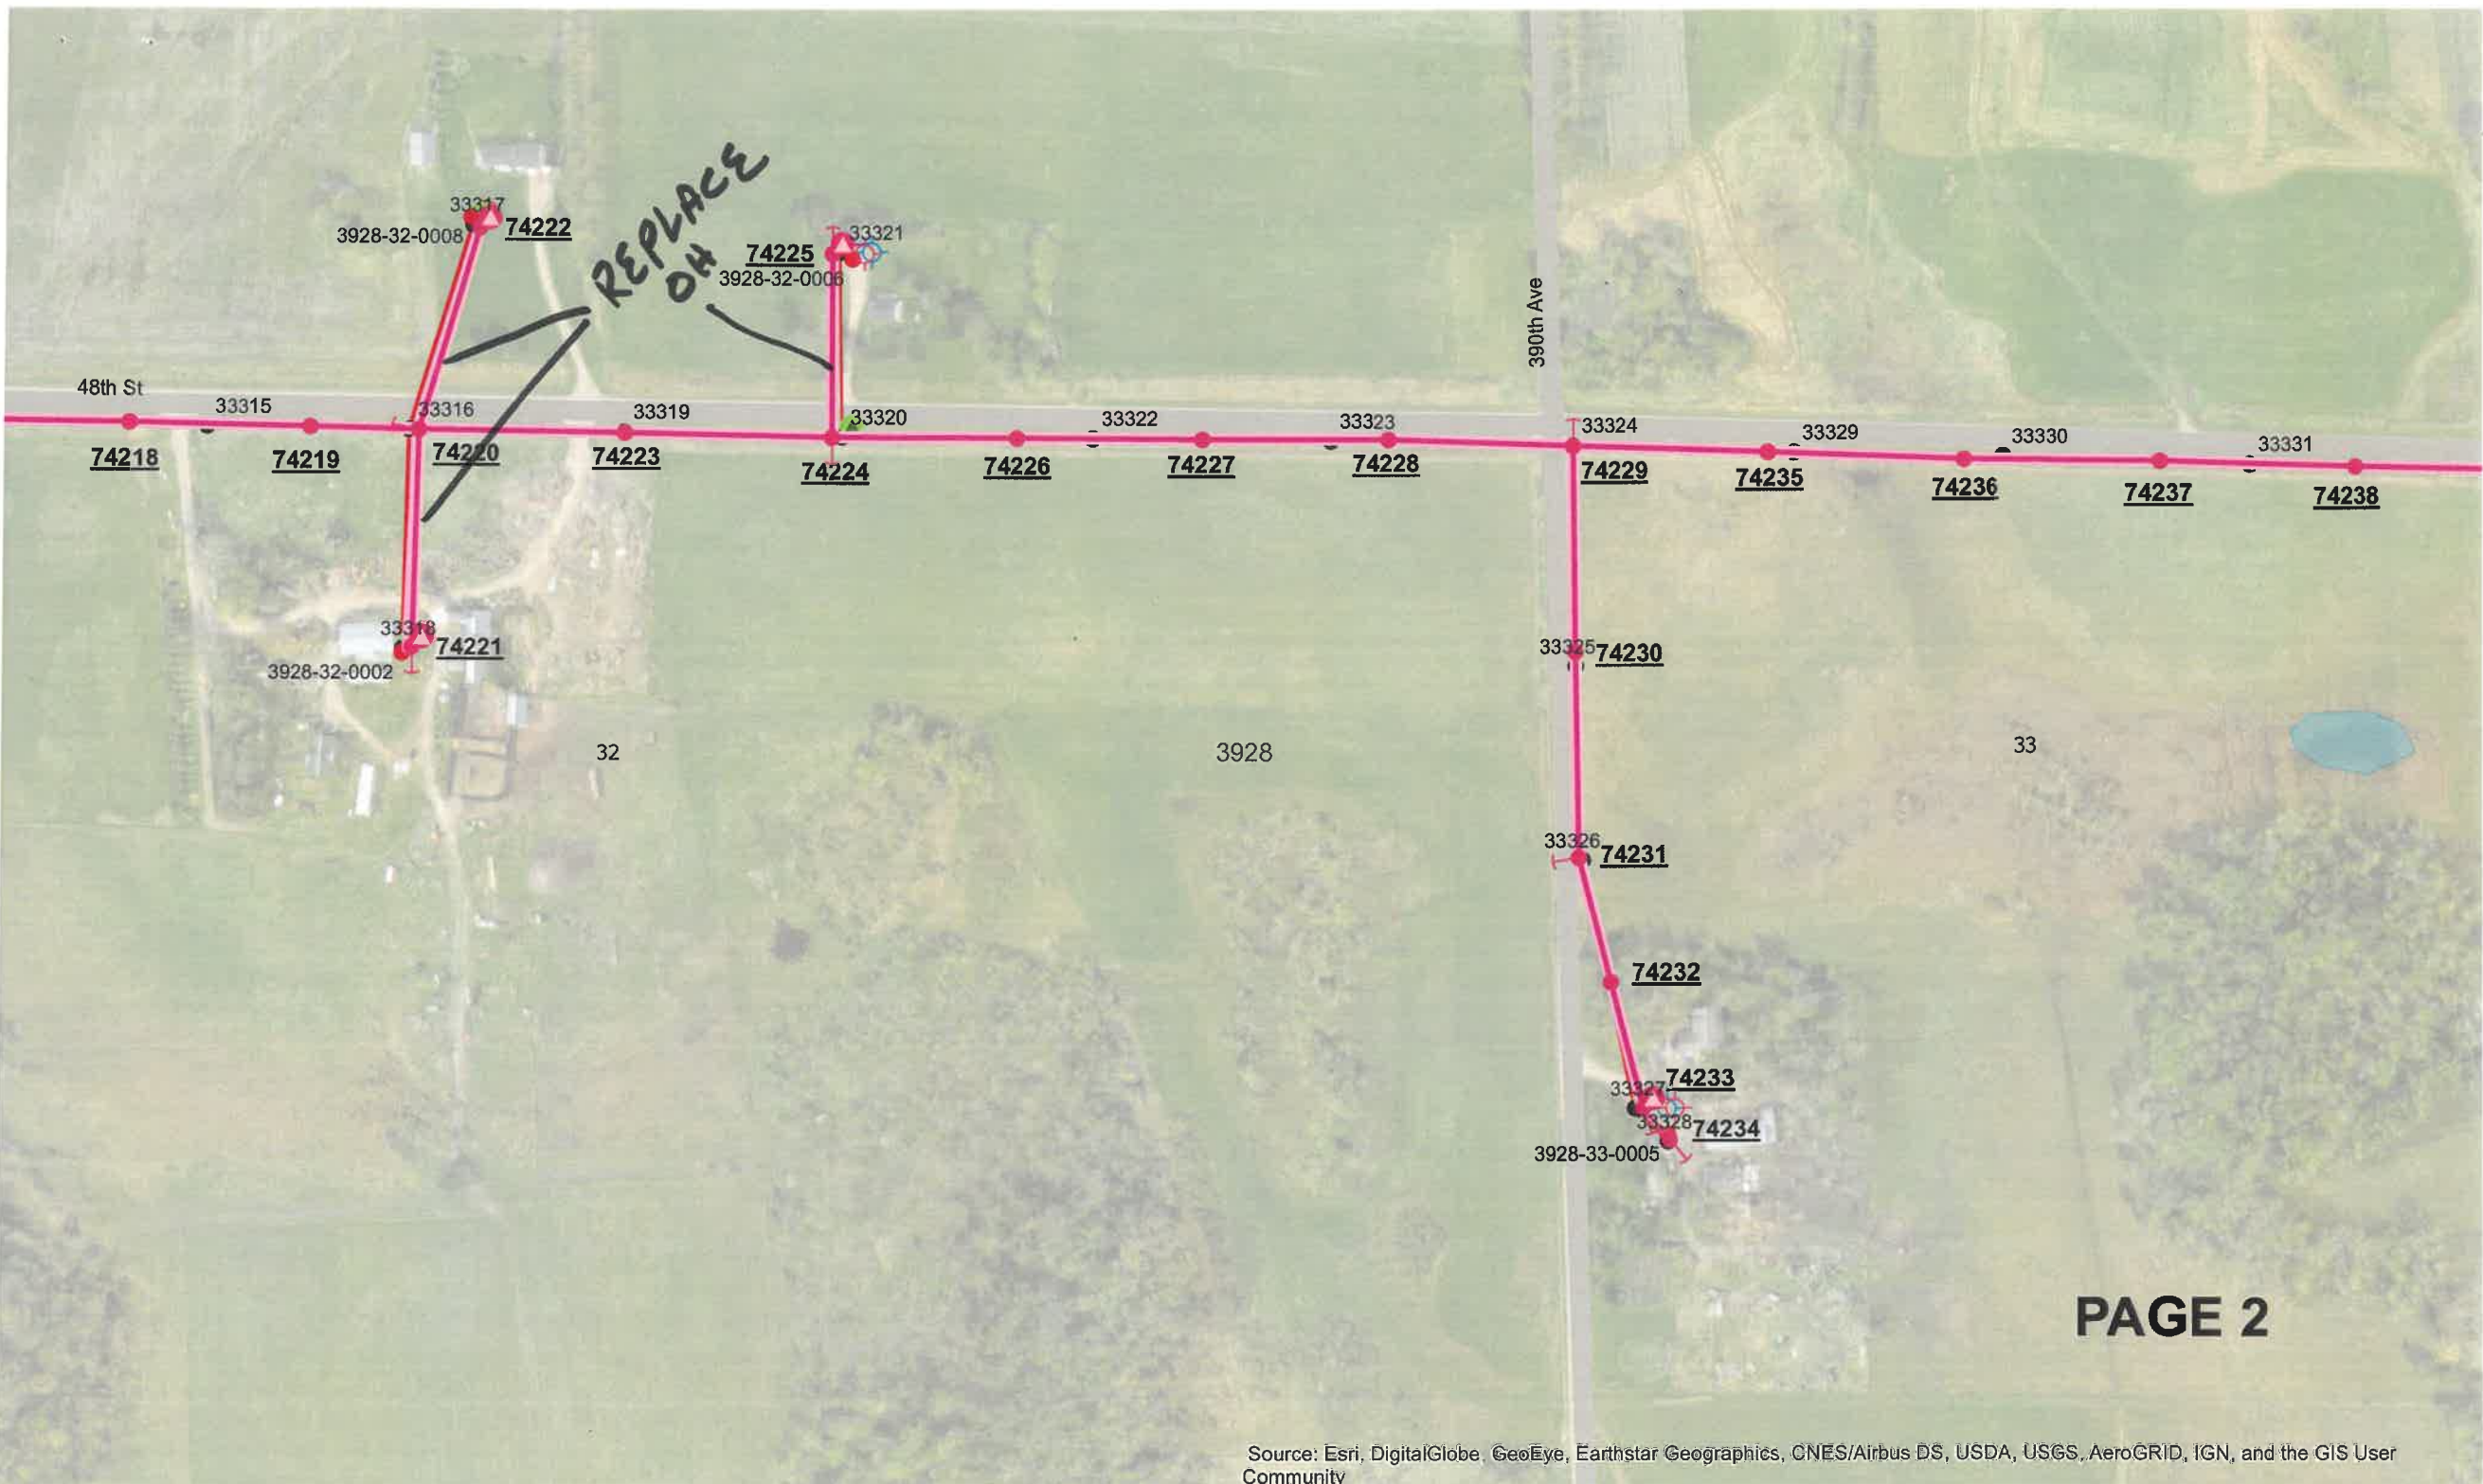



REPLACE
ON

REPLACE
OUT

NEW UNDERGROUND
BORE cable 60"
DEEP

POLE

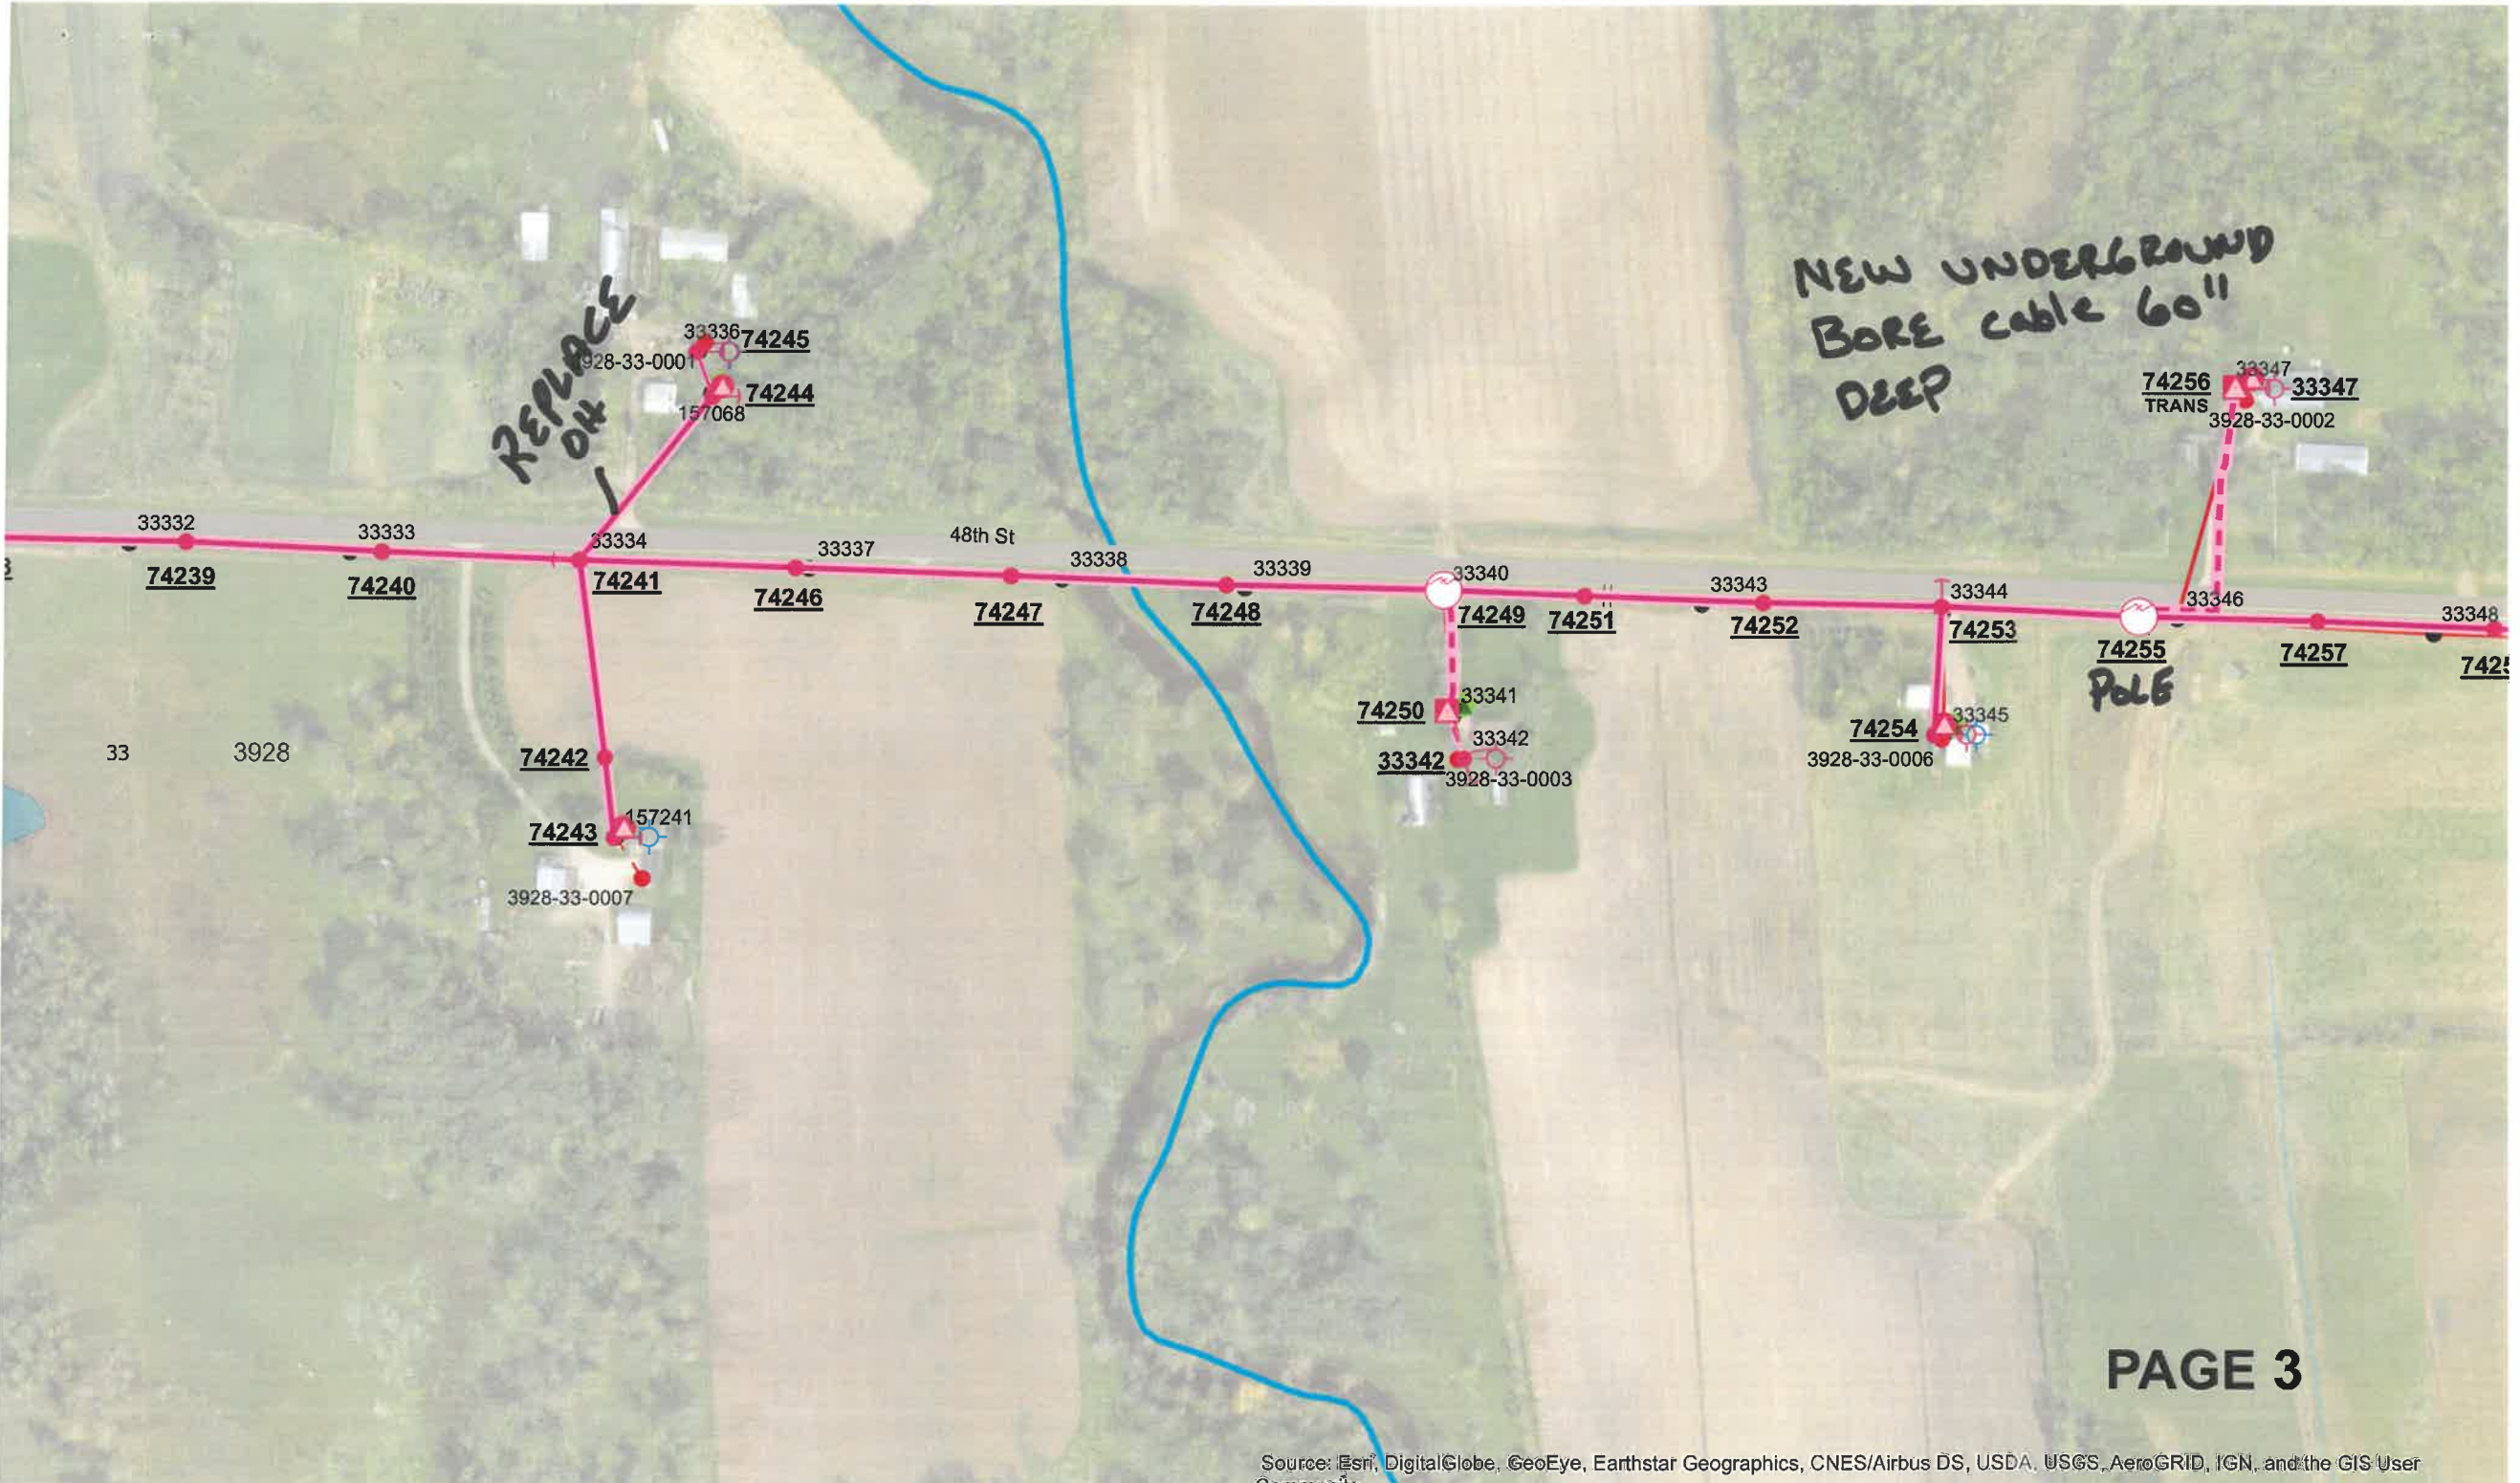

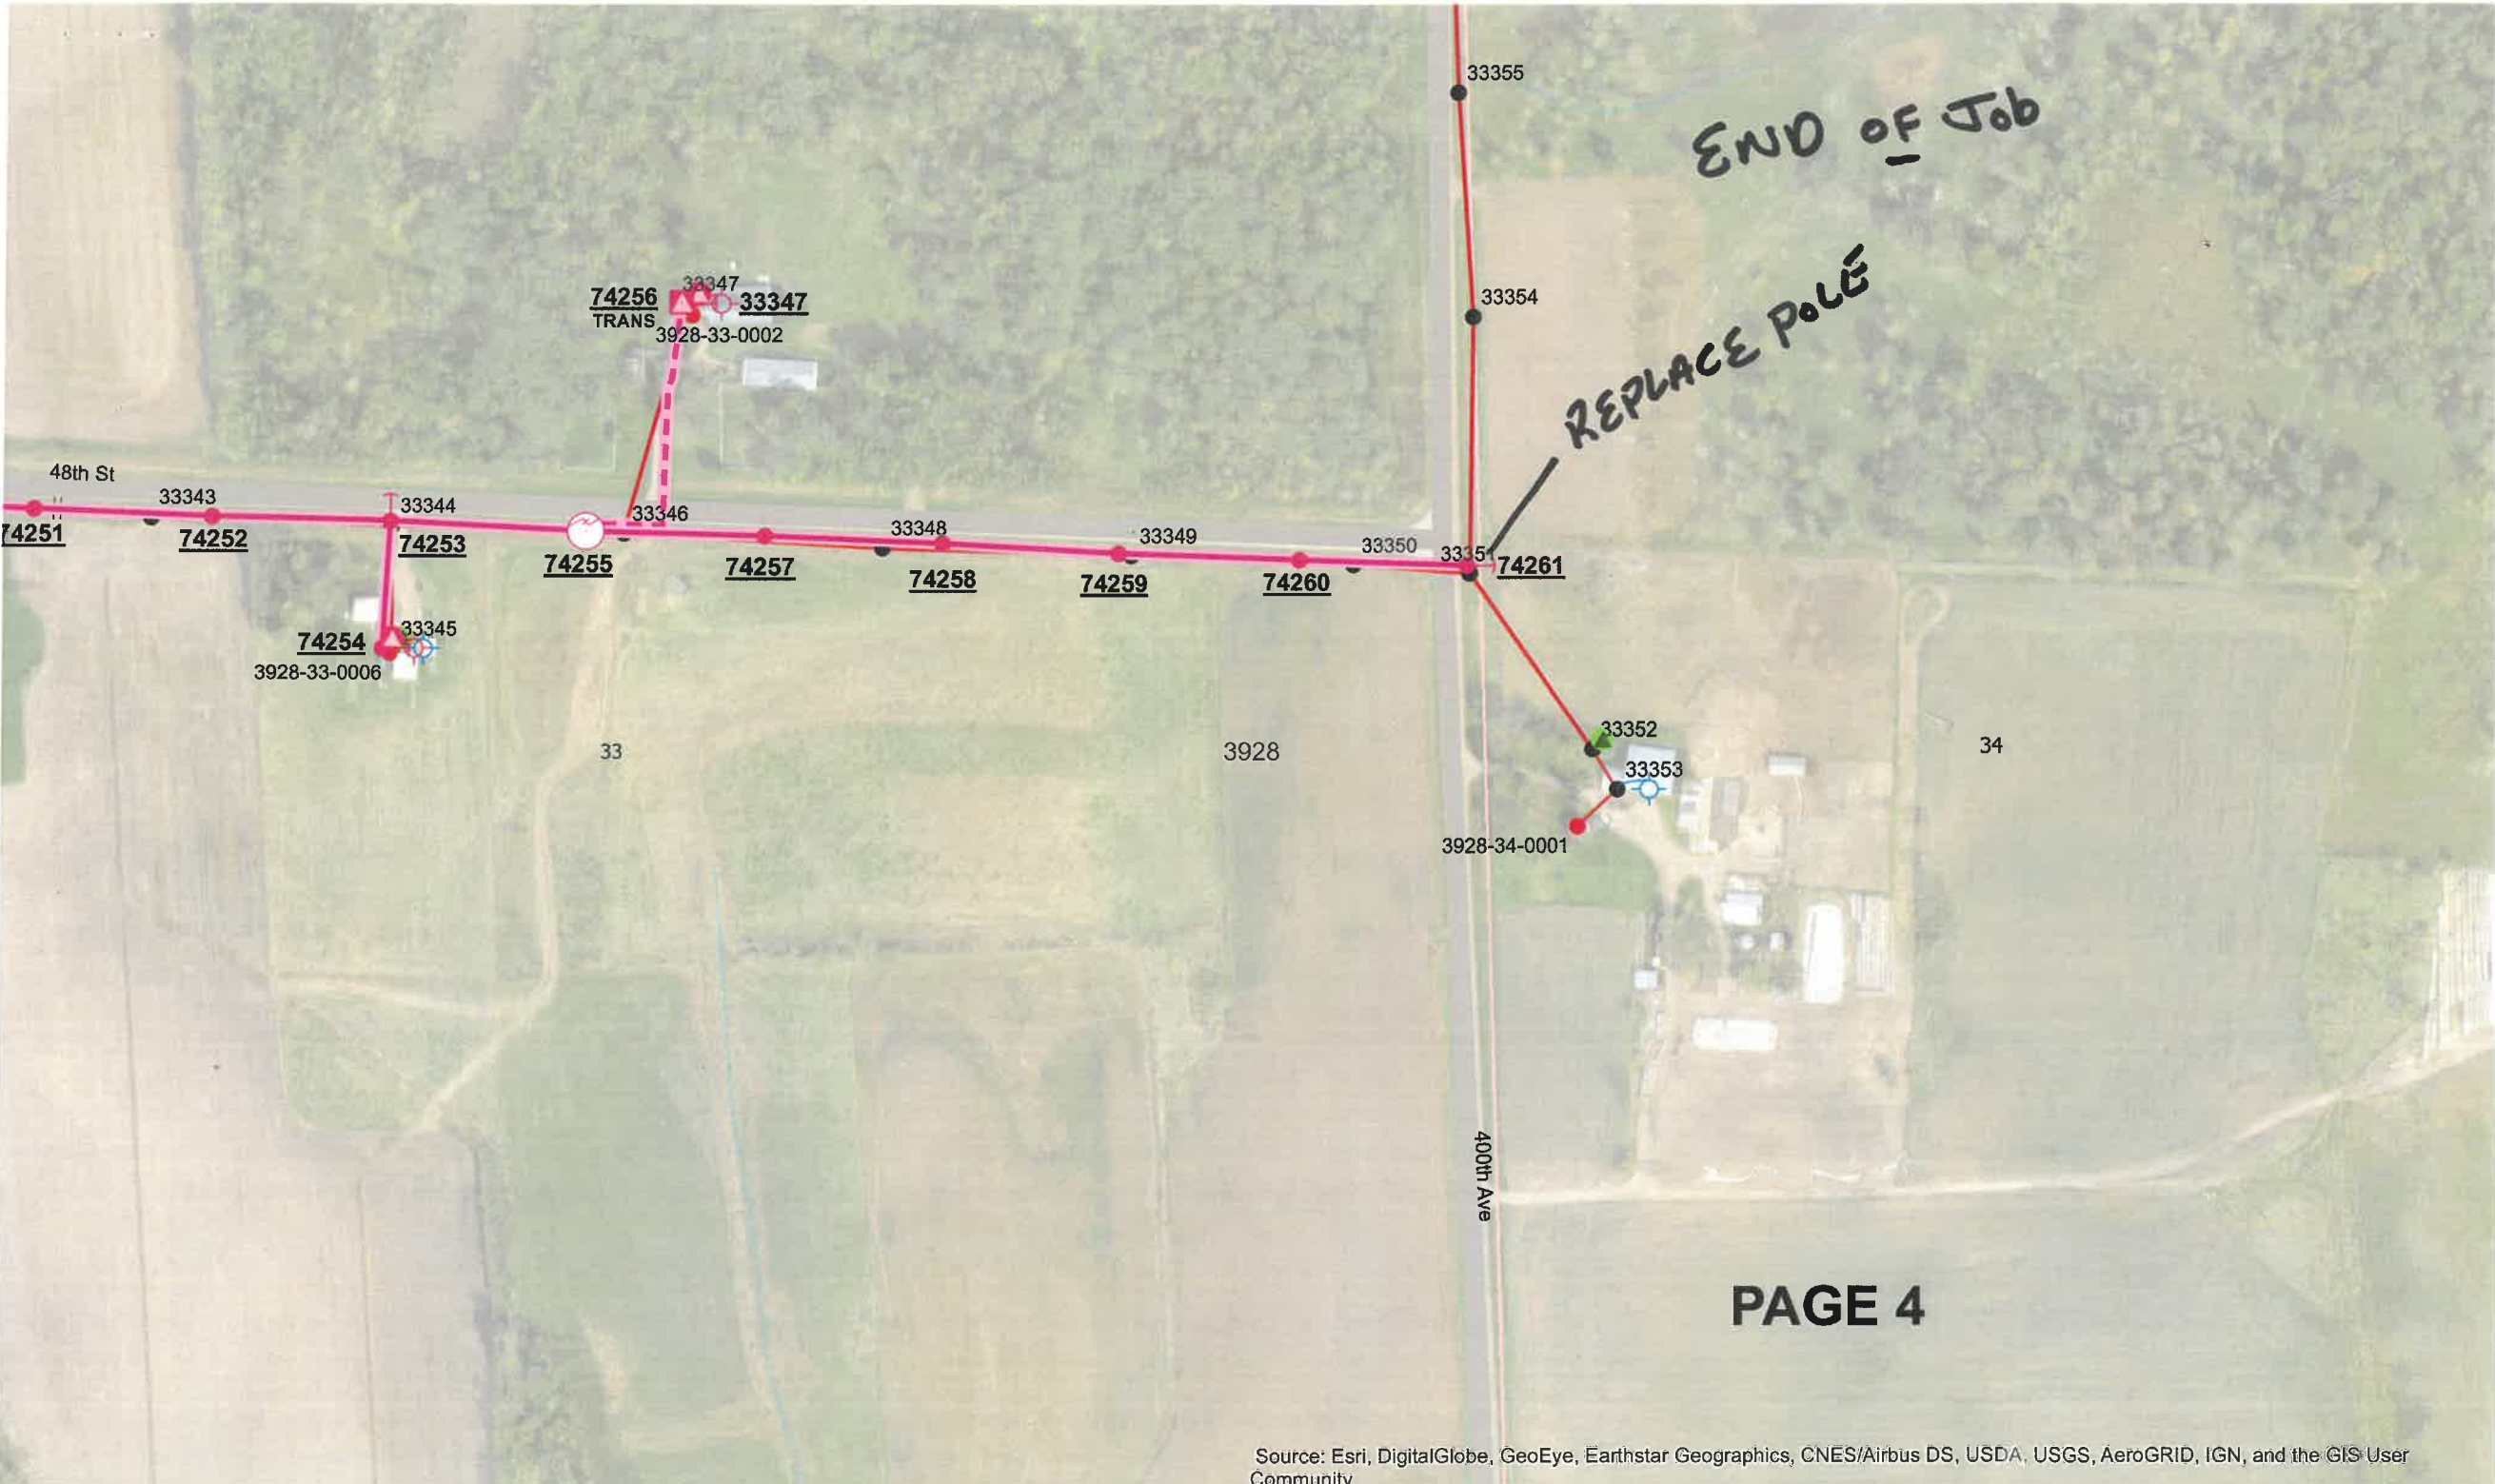

END OF JOB

REPLACE POLE

74256
TRANS
3928-33-0002

74254
3928-33-0006

3928-34-0001

PAGE 4