


1/15/2021 6:30:48 PM DESIGNER EXPRESS DESIGN

Save: 10/30/2020 3:21 PM jgriffin Plot: 10/30/2020 7:05 PM P:\KOMMORR\1504395-final-dsgn\51-drawings\10-Civil\dwg\sheet\MC15043951.dwg

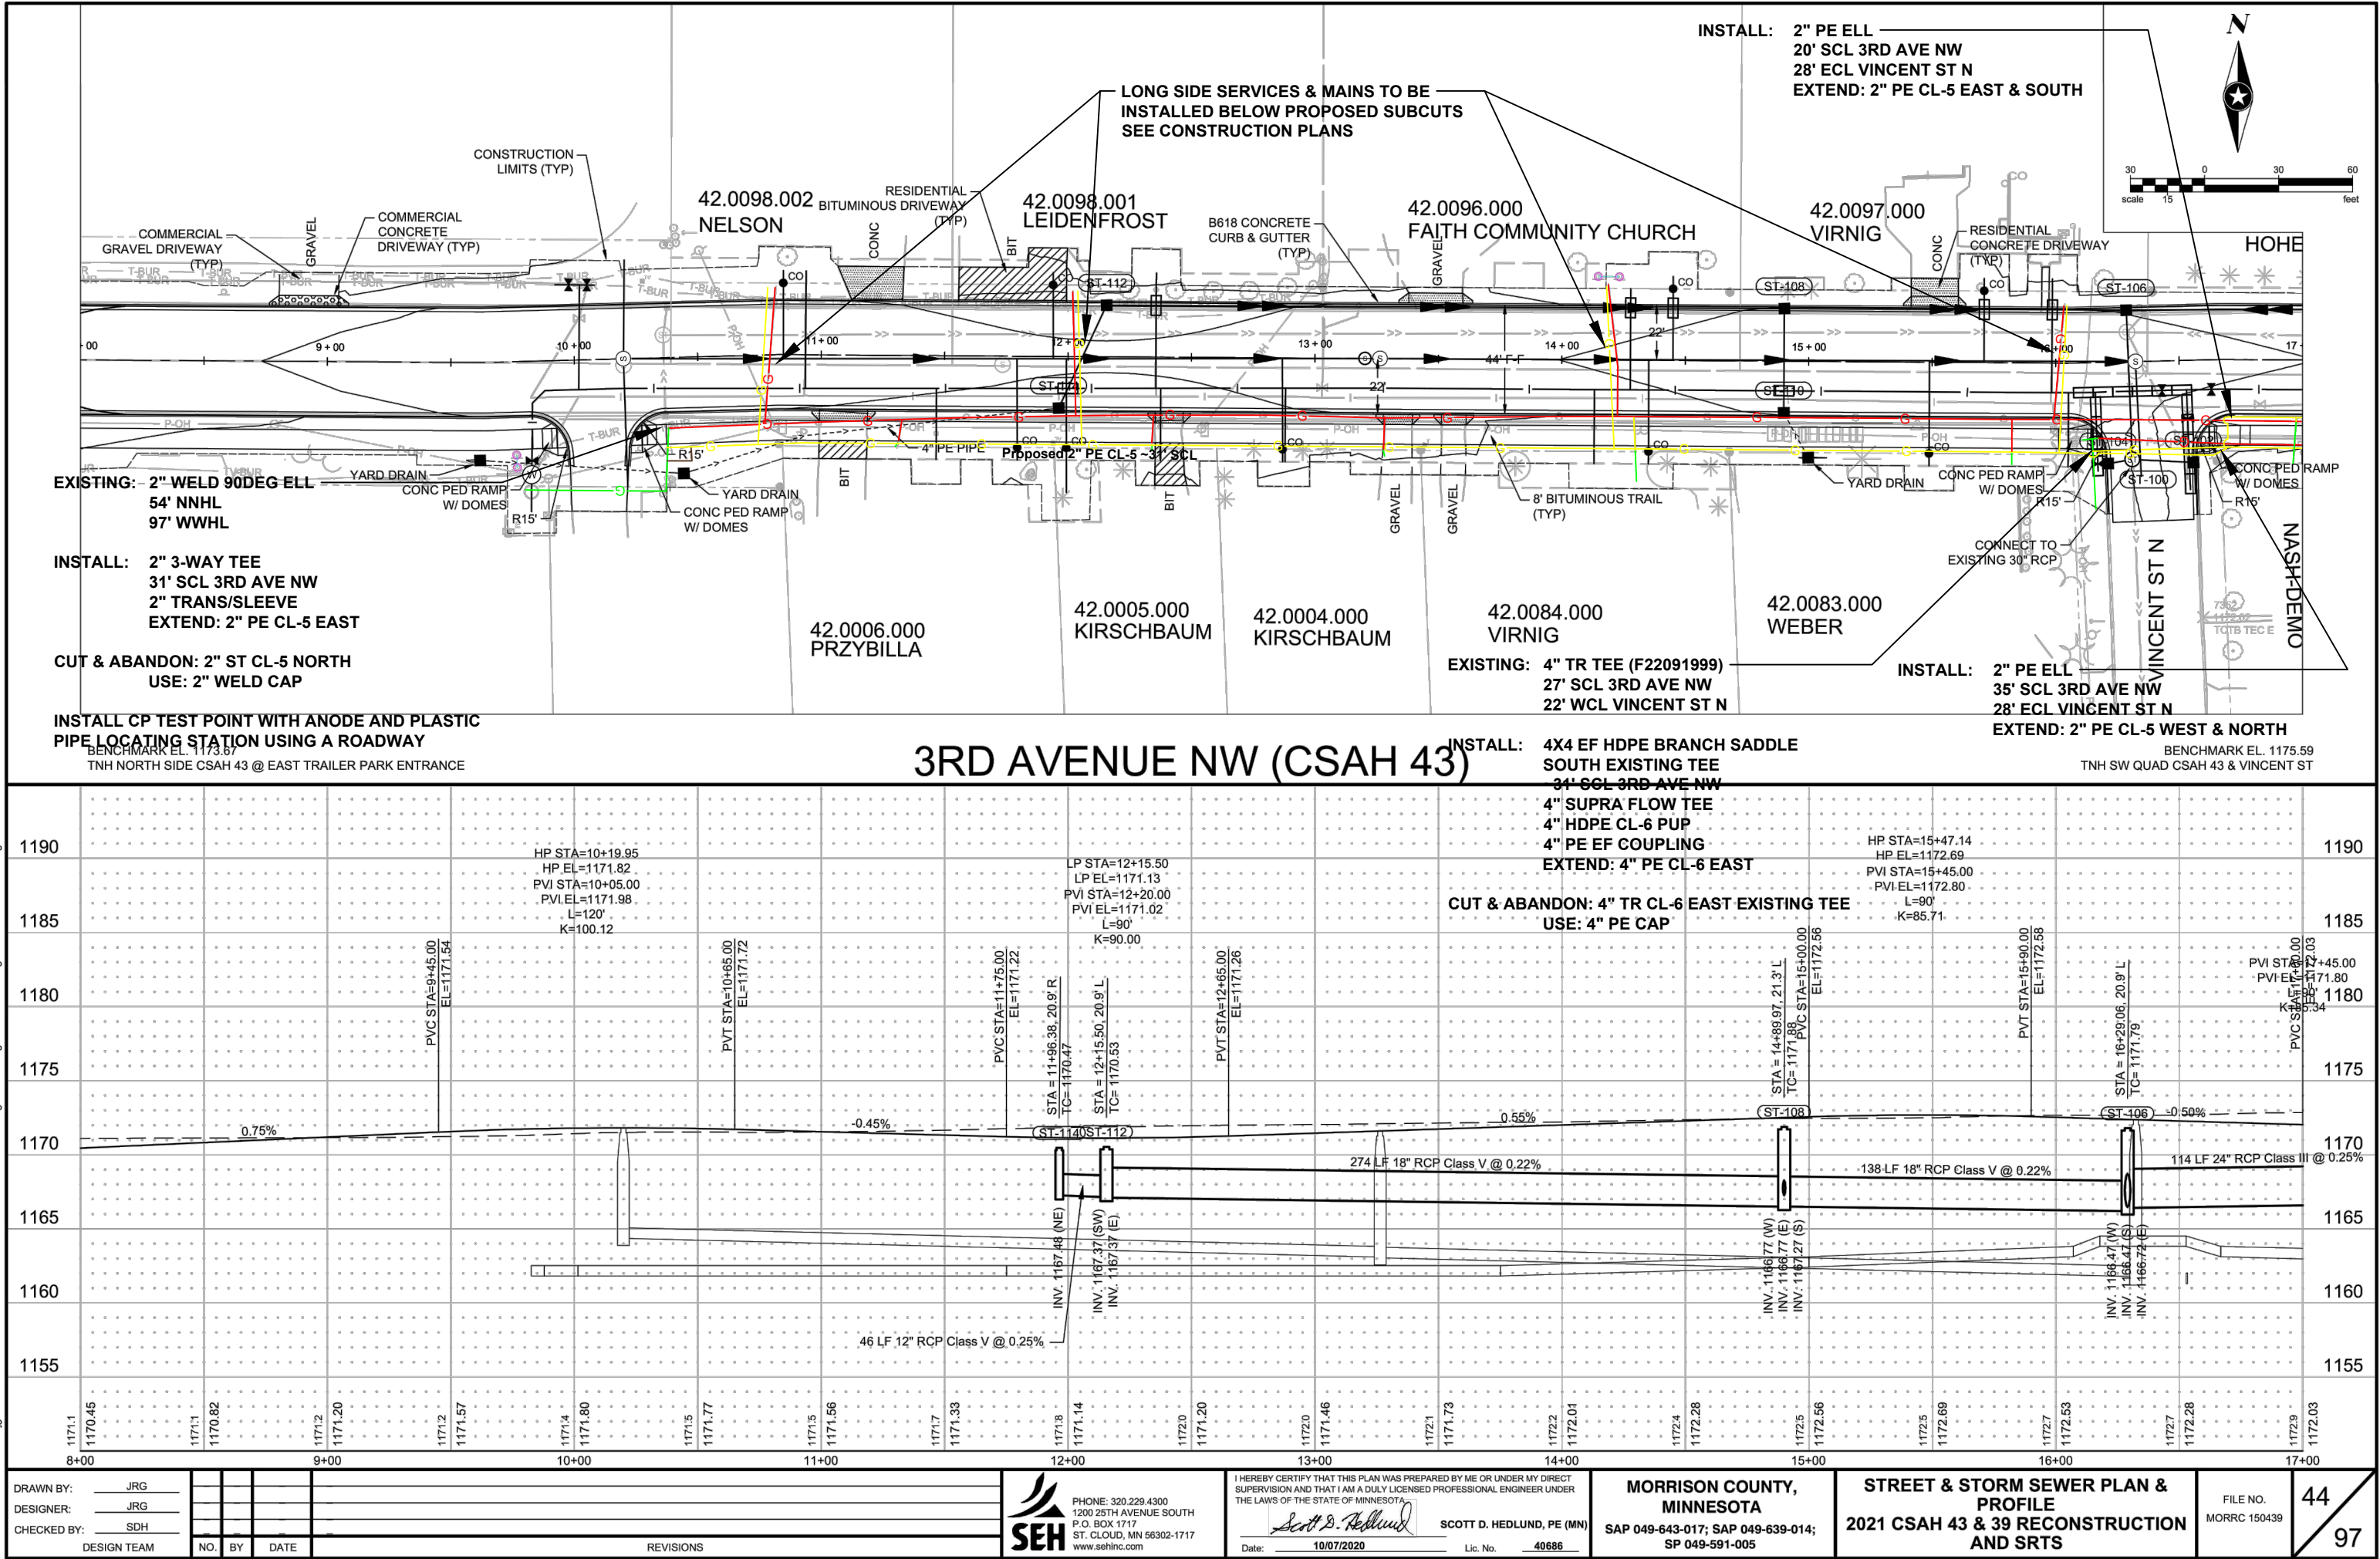

DRAWN BY:	JRG
DESIGNER:	JRG
CHECKED BY:	SDH
DESIGN TEAM	

PHONE: 320.229.4300
1200 25TH AVENUE SOUTH
P.O. BOX 1717
ST. CLOUD, MN 56302-1717
www.sehinc.com

I HEREBY CERTIFY THAT THIS PLAN WAS PREPARED BY ME OR UNDER MY DIRECT SUPERVISION AND THAT I AM A DULY LICENSED PROFESSIONAL ENGINEER UNDER THE LAWS OF THE STATE OF MINNESOTA

SCOTT D. HEDLUND, PE (MN)
Date: 10/07/2020 Lic. No. 40686

MORRISON COUNTY,
MINNESOTA

SAP 049-643-017; SAP 049-639-014;
SP 049-591-005



STREET & STORM SEWER PLAN &
PROFILE
2021 CSAH 43 & 39 RECONSTRUCTION
AND SRTS

FILE NO.
MORRCC 150439

44
97

42.0100.000
STUMPF


05.0313.000
ROTHSTEIN

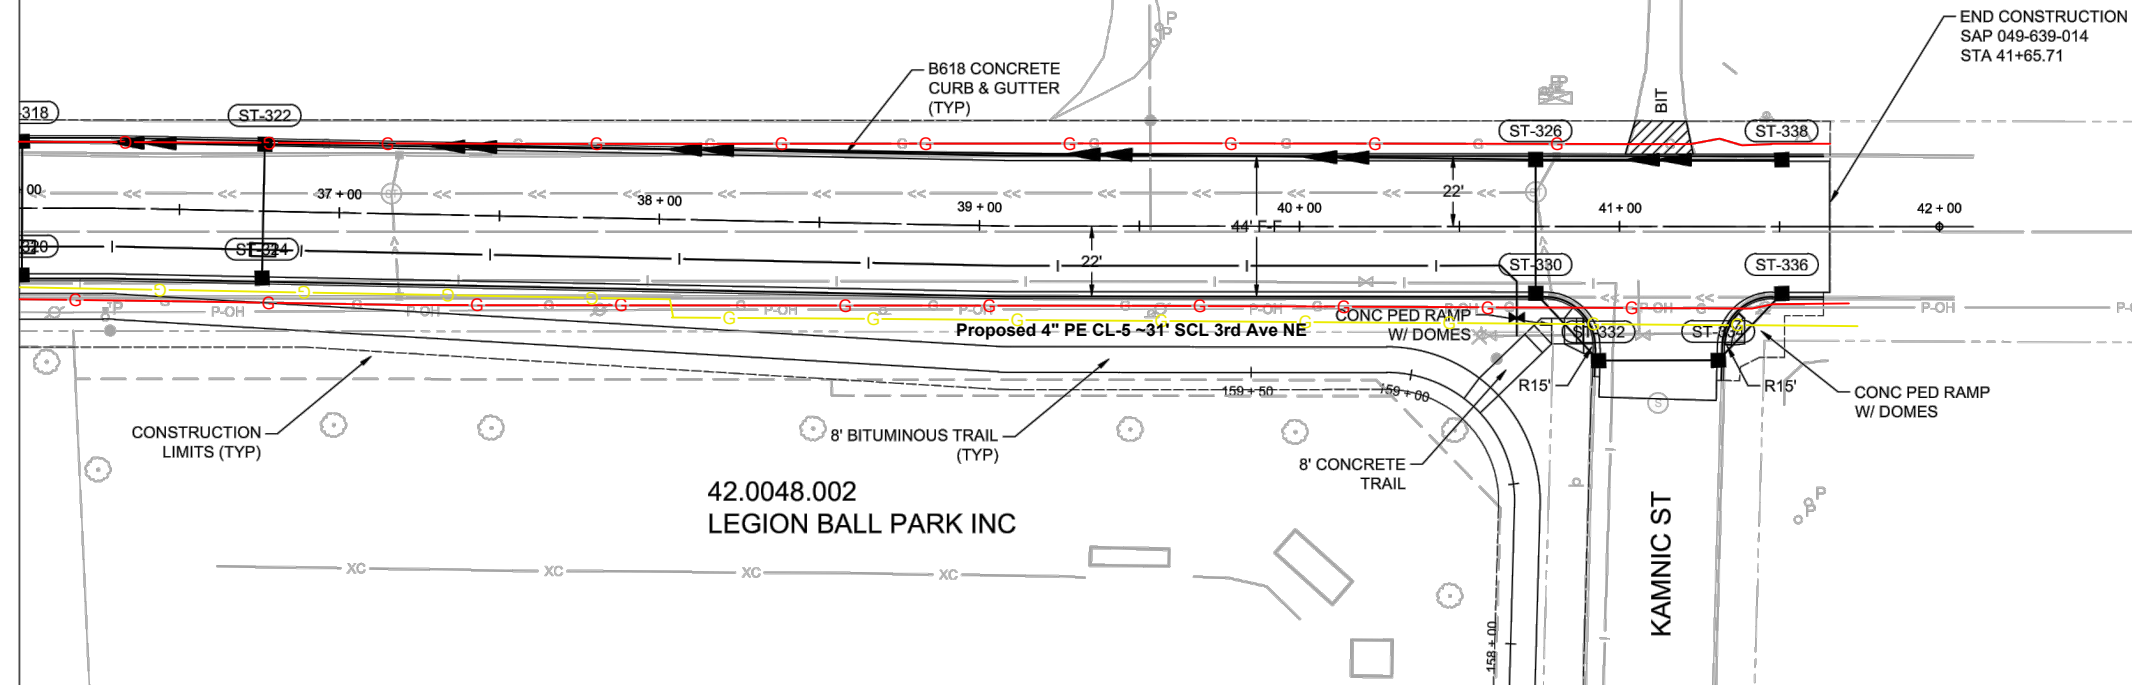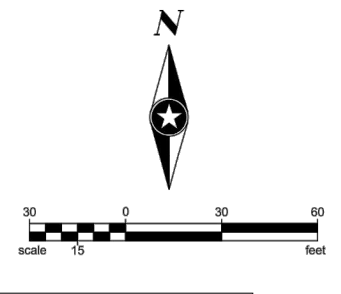

BENCHMARK EL. 1176.83
TNH SOUTH SIDE CSAH 39 @ 226 3RD AVE NE

BENCHMARK EL. 1178.51
TNH SW QUAD CSAH 39 & KAMNIC ST

3RD AVENUE NE (CSAH 39)

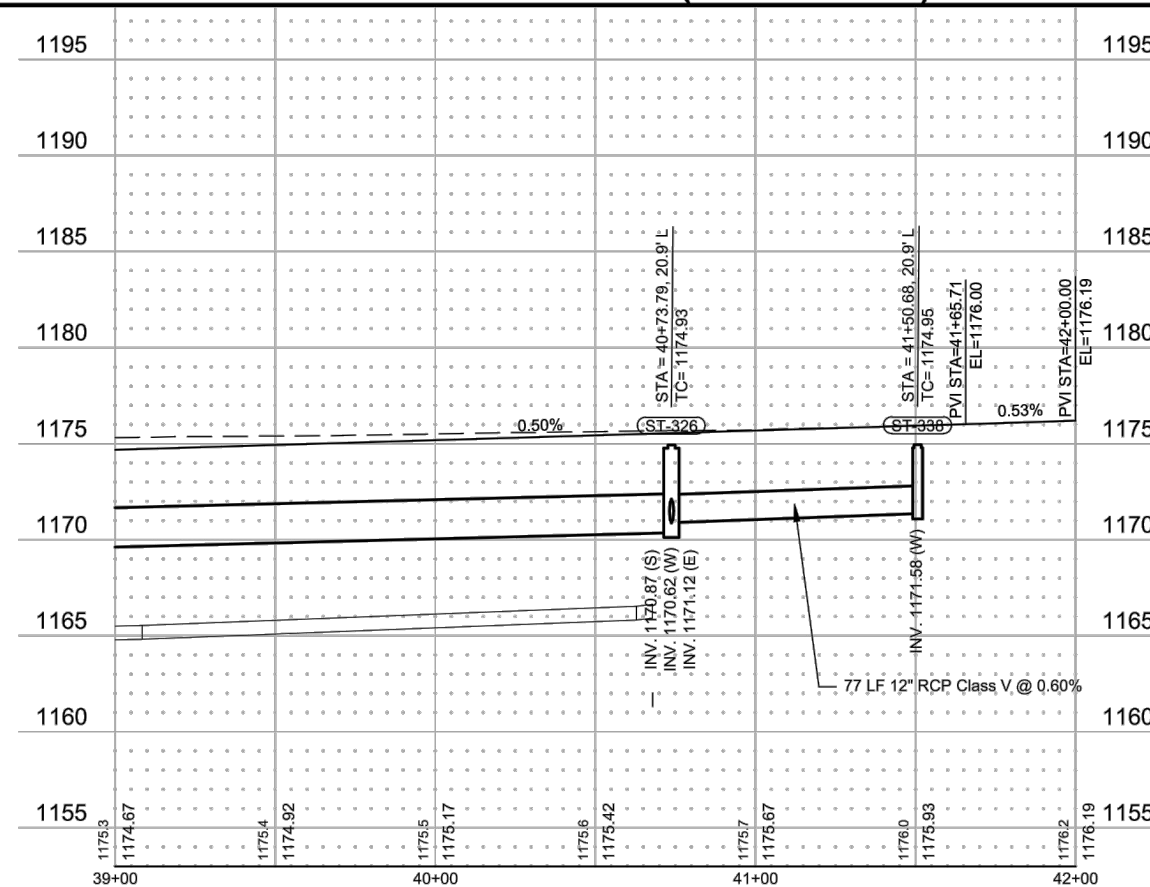

DRAWN BY: JRG
DESIGNER: JRG
CHECKED BY: SDH
DESIGN TEAM

NO.	BY	DATE	REVISIONS



I HEREBY CERTIFY THAT THIS PLAN WAS PREPARED BY ME OR UNDER MY DIRECT SUPERVISION AND THAT I AM A DULY LICENSED PROFESSIONAL ENGINEER UNDER THE LAWS OF THE STATE OF MINNESOTA.

 SCOTT D. HEDLUND, PE (N)

Date: 10/07/2020 Lic. No. 40686

**MORRISON COUNTY,
MINNESOTA**
SAP 049-643-017; SAP 049-639-014;
SP 049-591-005

**STREET & STORM SEWER PLAN &
PROFILE
2021 CSAH 43 & 39 RECONSTRUCTION
AND SRTS**

FILE NO. 4
MORRC 150439

$$\frac{48}{97}$$

Save: 10/30/2020 2:18 PM Igniffith Plot: 10/30/2020 7:13 PM P:\KOIMMORR\15043915-final-dsgm\51-drawings\10-Civil\cad\dwg\sheet\MC150439S2.dwg

11/15/2021 6:35:26 PM DESIGNER EXPRESS DESIGN

1/15/2021 6:35:26 PM