


GENERAL LOCATION ONLY.
DO NOT USE TO LOCATE FOR EXCAVATION.
CALL 1-800-252-1166 FOR ONSITE LOCATIONS AND STAKING.



Scale: 1" : 83'

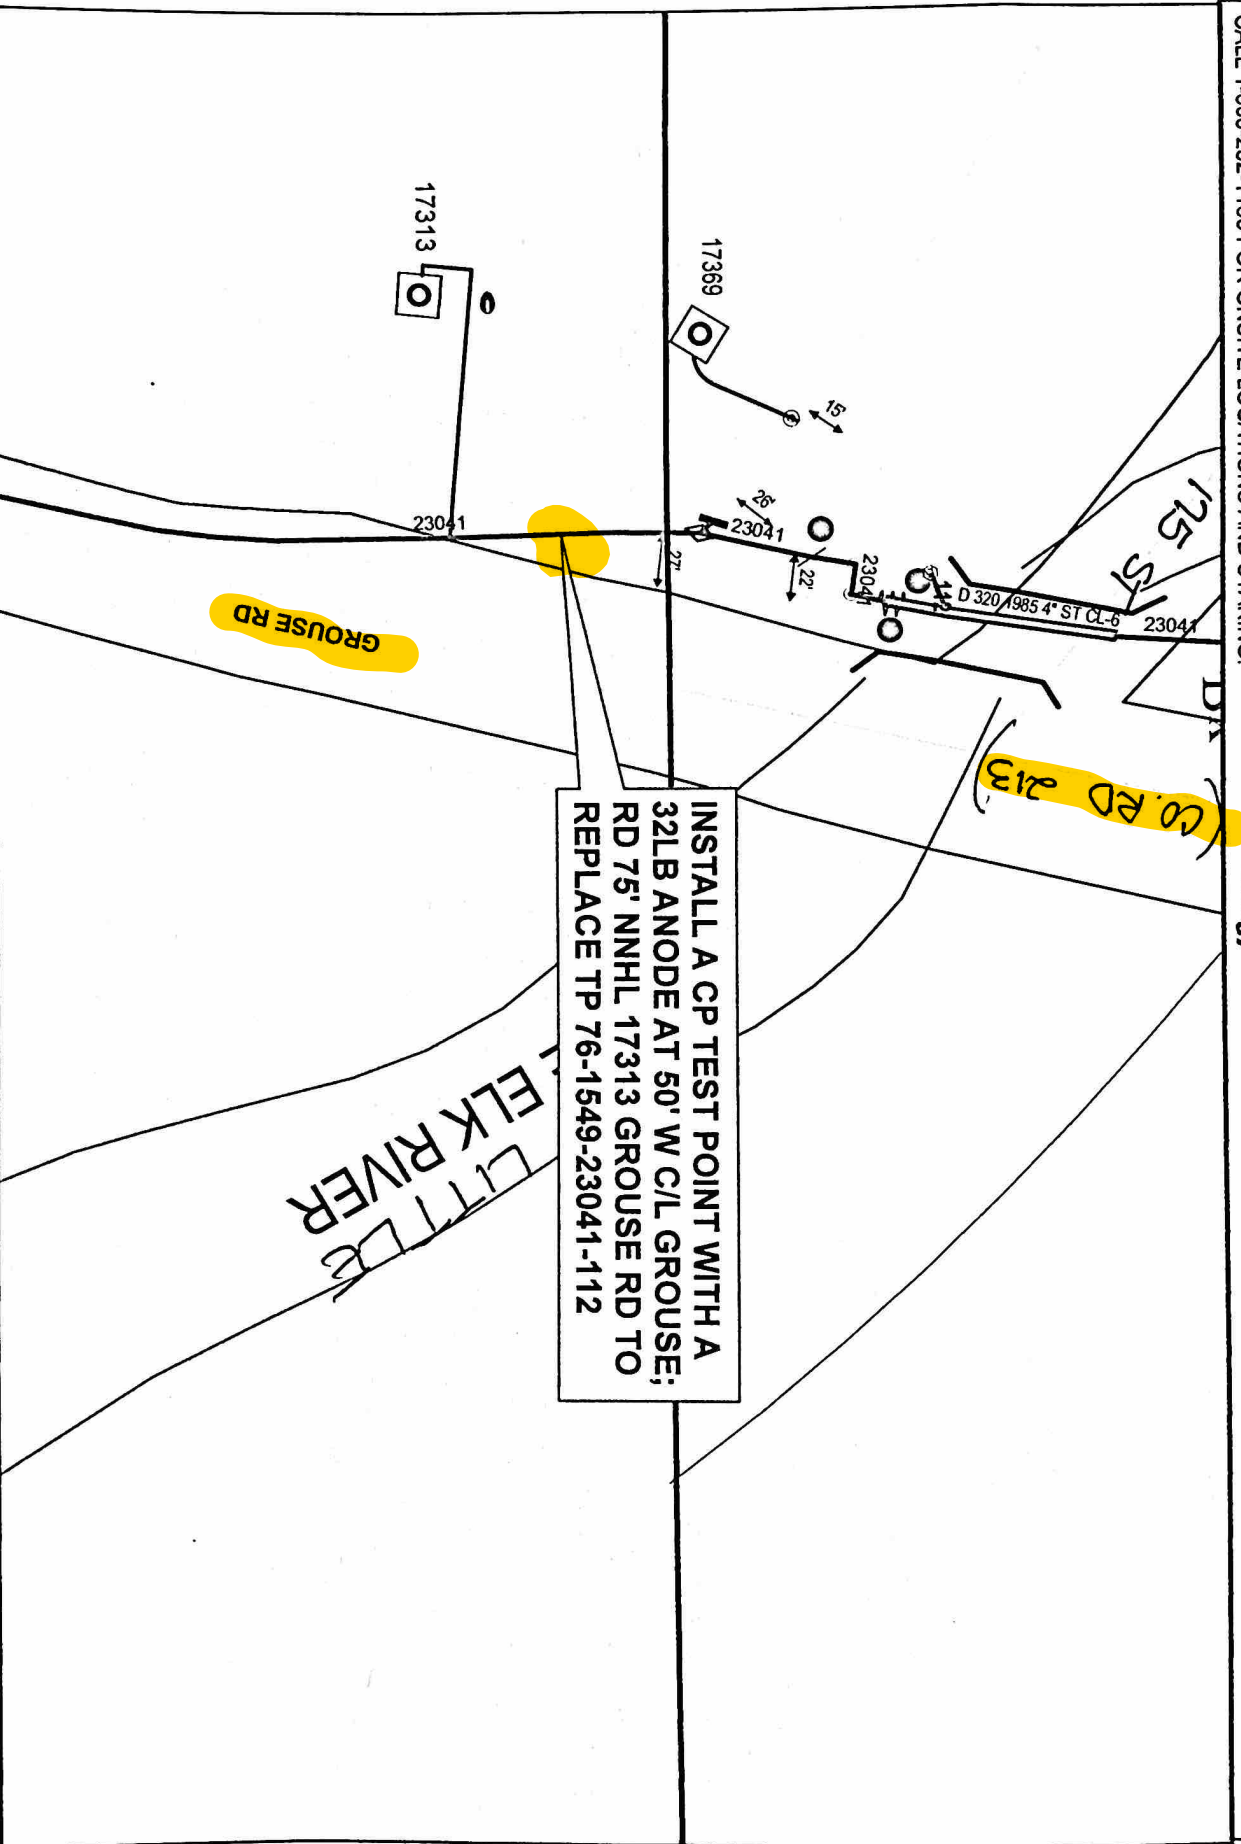

INSTALL A CP TEST POINT WITH A
32LB ANODE AT 50' W C/L GROUSE;
RD 75' NNHL 17313 GROUSE RD TO
REPLACE TP 76-1549-23041-112

Work Order #: 916866282
Design Date: 12-28-2020

City: LITTLE FALLS Greenfield CP Section #: 23041
Quad/Sec/Twp/Rng: SW SEC.5 / T-129 / R-29 CP Area: AL1549-1

Designed By: P TEESELINK
Designer Phone #: 612.910.1378