


GENERAL LOCATION ONLY. DO NOT USE TO LOCATE FOR EXCAVATION. CALL 1-800-252-1166 FOR ONSITE LOCATIONS AND STAKING.

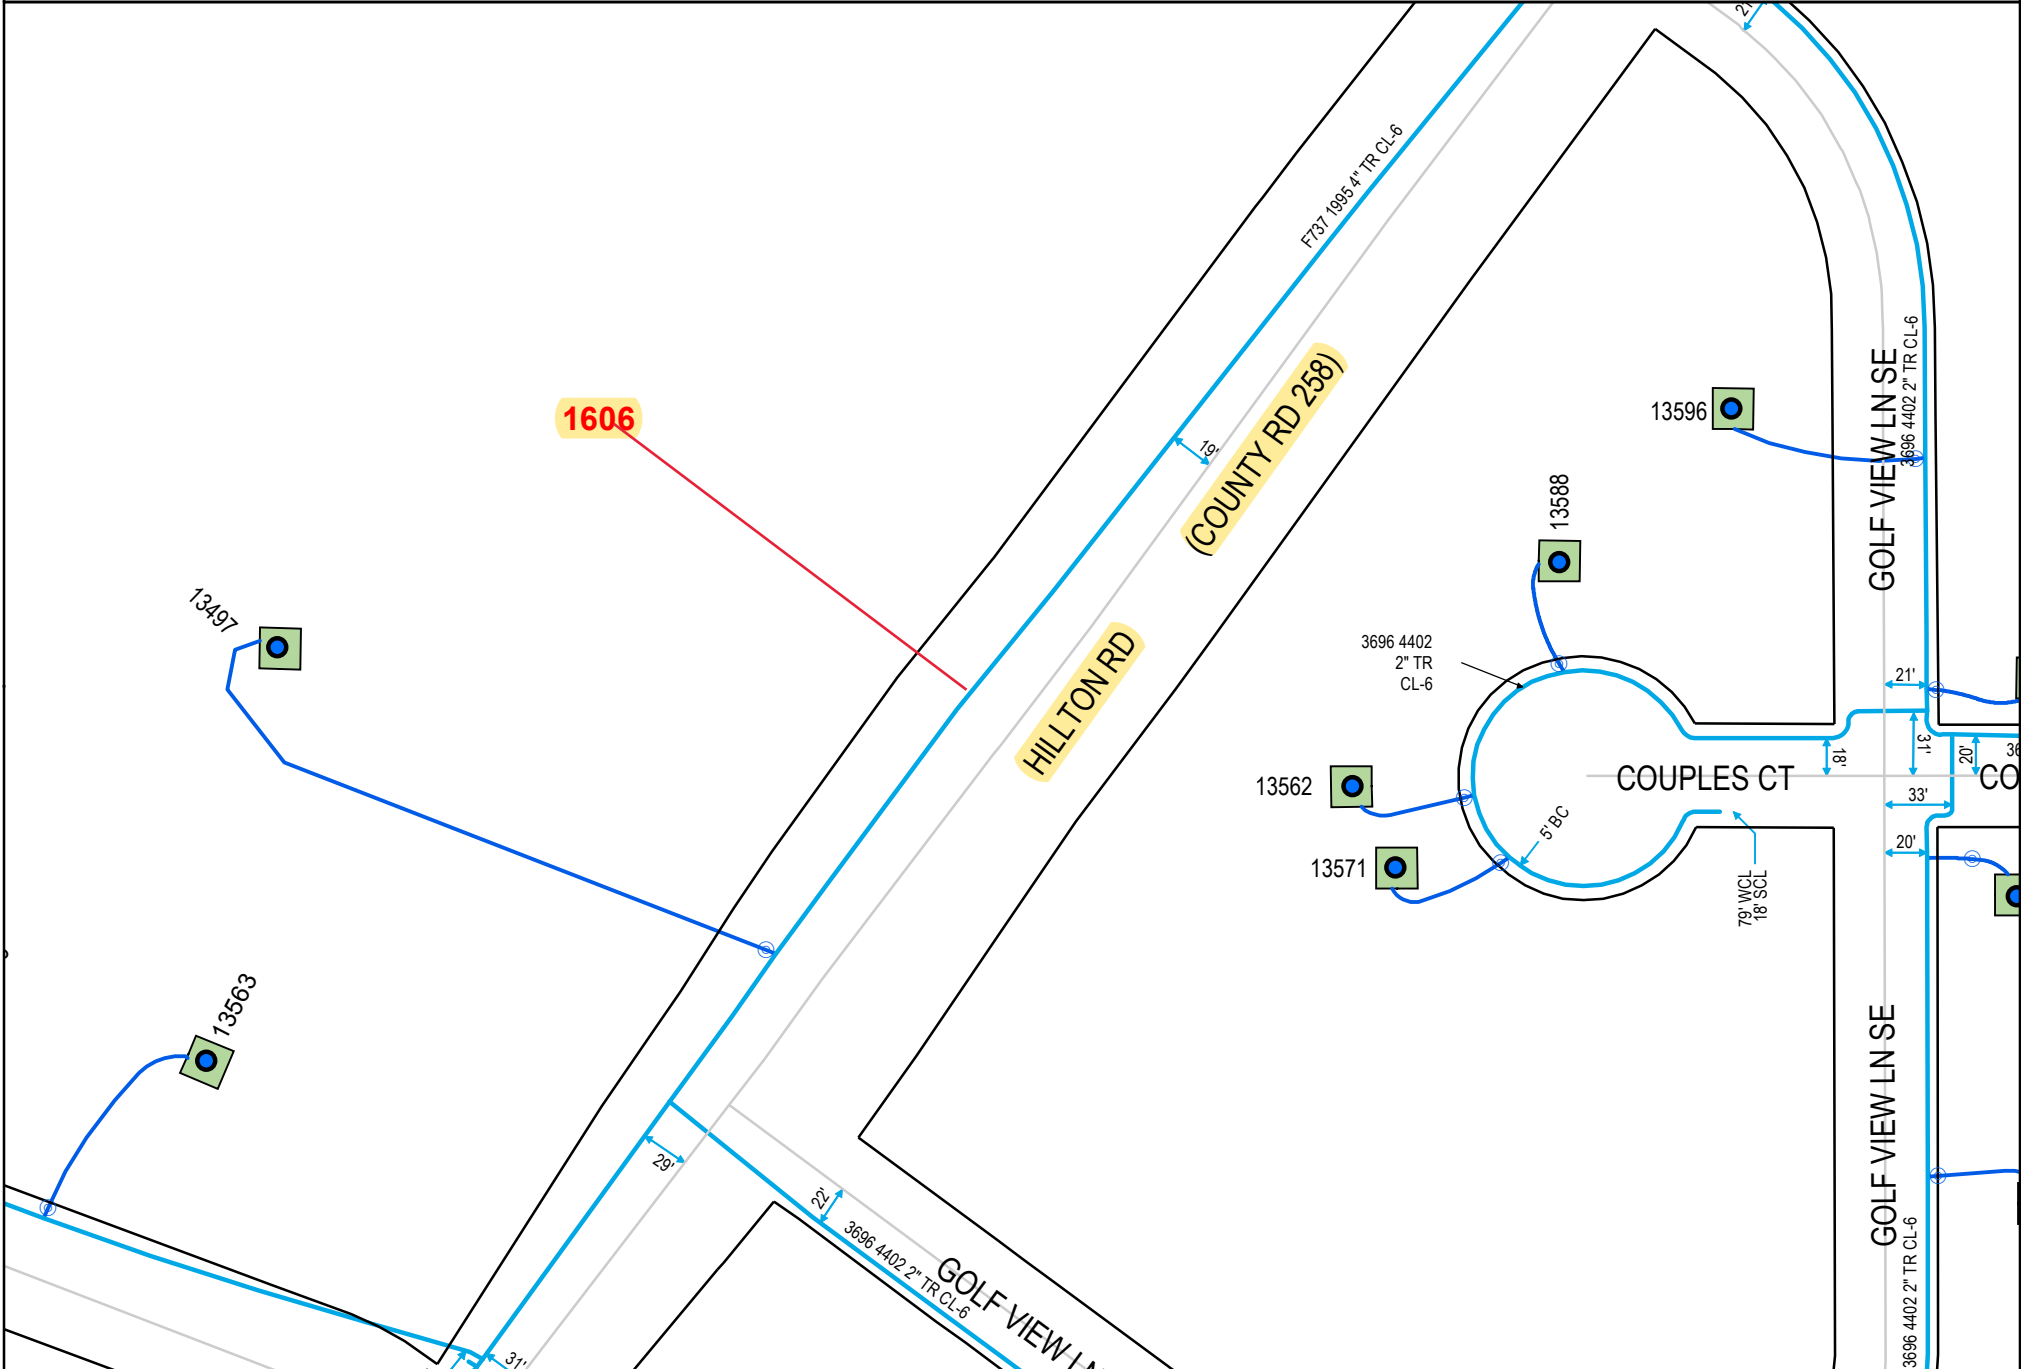

Plotted by: i220277

Plot Date: 5/4/2021

1606 HILLTON RD

LITTLE FALLS MN 56345

MORRISON COUNTY

Scale: 1" : 94'

