

142070-34

26884

st # 1
install new pole & anchor

153rd St (Morrison Cnty Rd 39)

153rd St

T-588971

C

10

T-596312

C

10

MH250W

T-588972

C

15

Lift
Station

st # 2
install pm tx

15

Ball
Field

143070-12

Kaminic St

26889

42


C.O.



AN ALLETE COMPANY

dwitt

1/13/2021

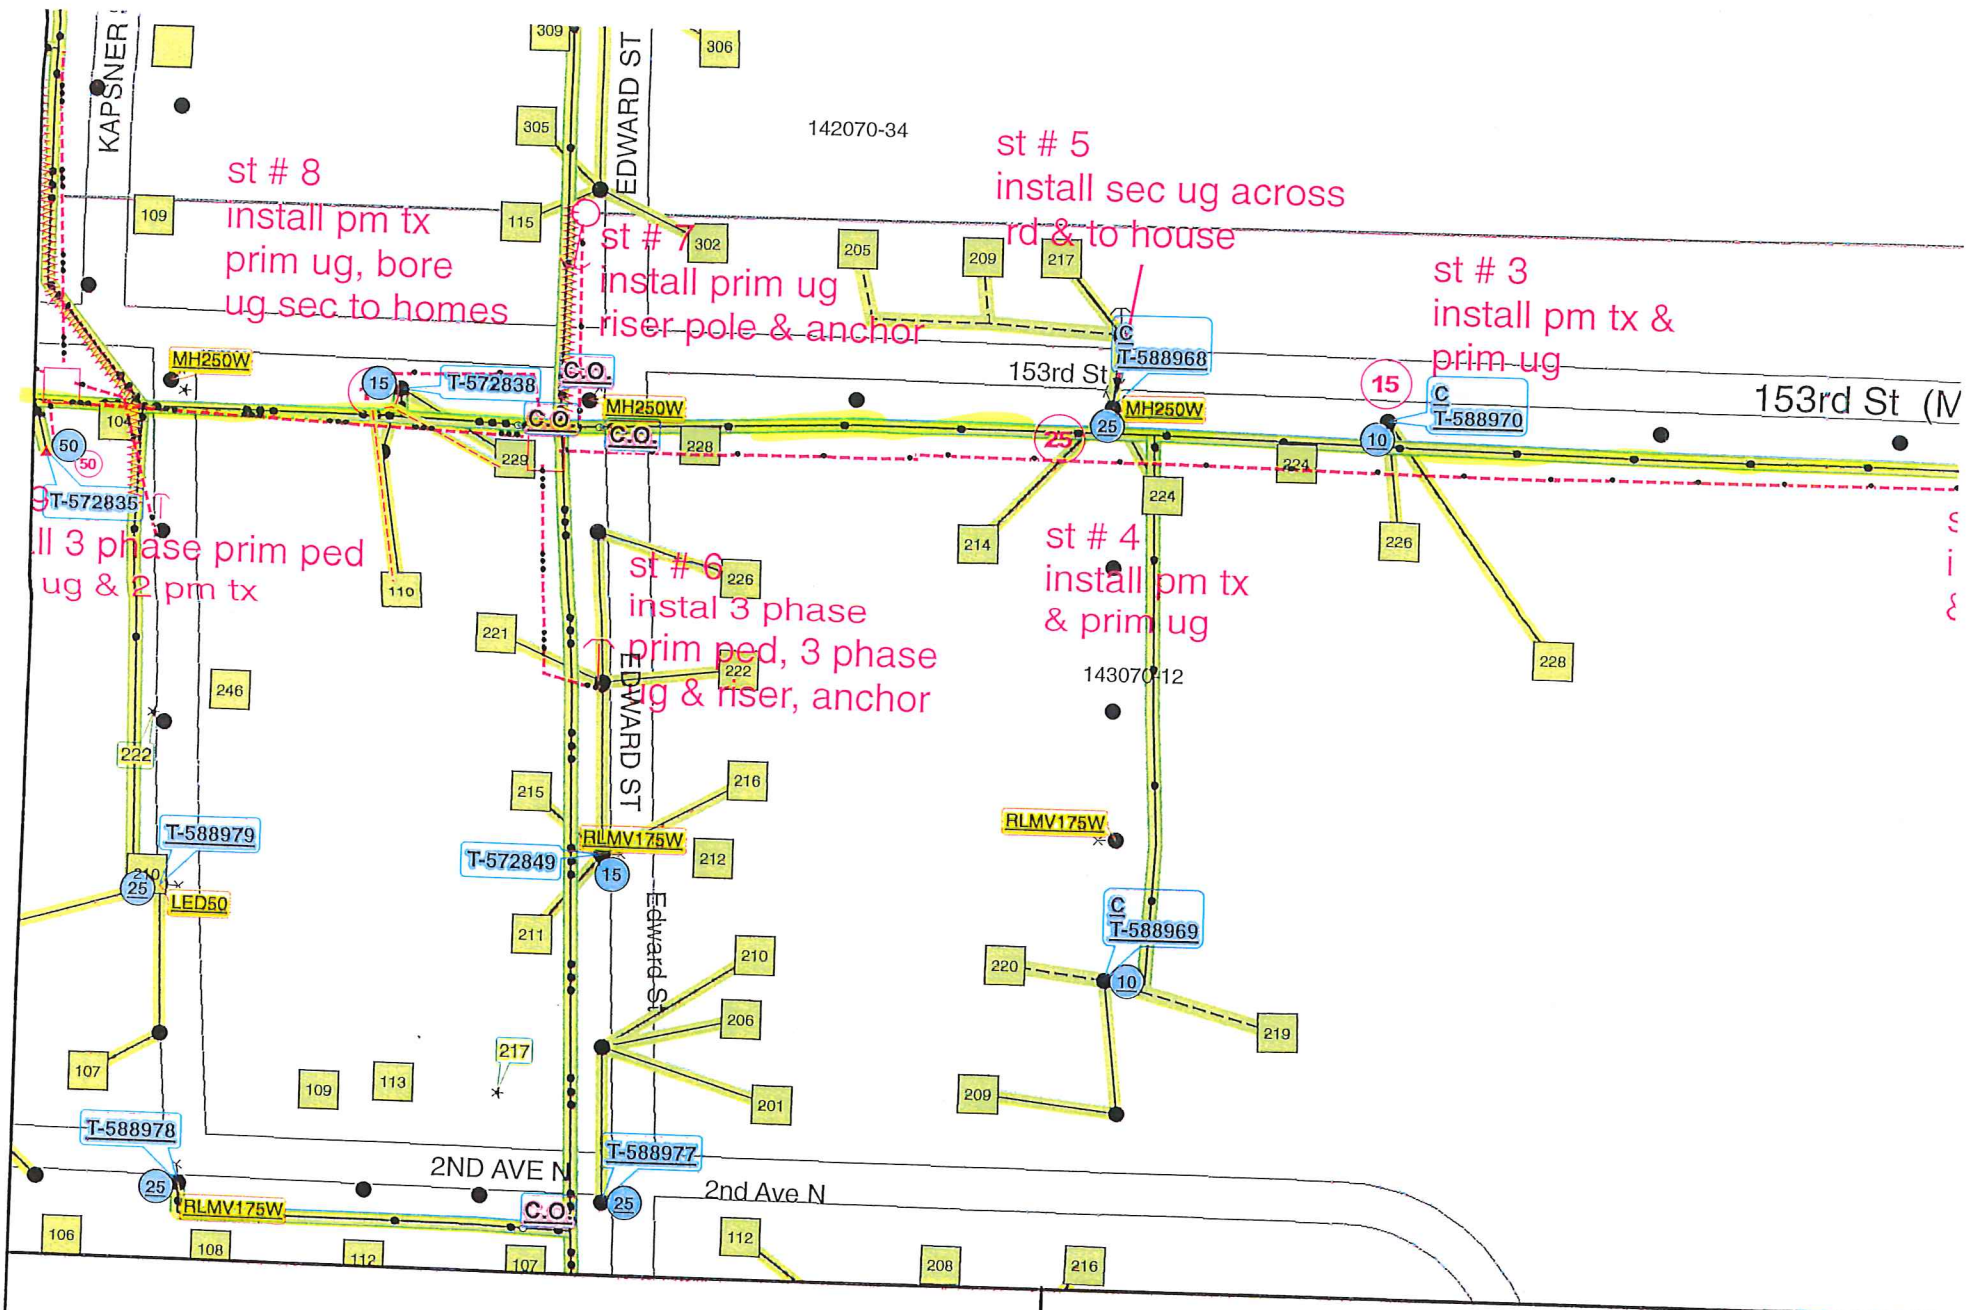

st # 8
install pm tx
prim ug, bore
ug sec to homes

st # 7
install prim ug
riser pole & anchor

st # 5
install sec ug across
rd & to house

st # 3
install pm tx &
prim ug


ll 3 phase prim ped
ug & 2 pm tx

st # 6
instal 3 phase
prim ped, 3 phase
ug & riser, anchor

st # 4
install pm tx
& prim ug

dwitt

12/23/2020

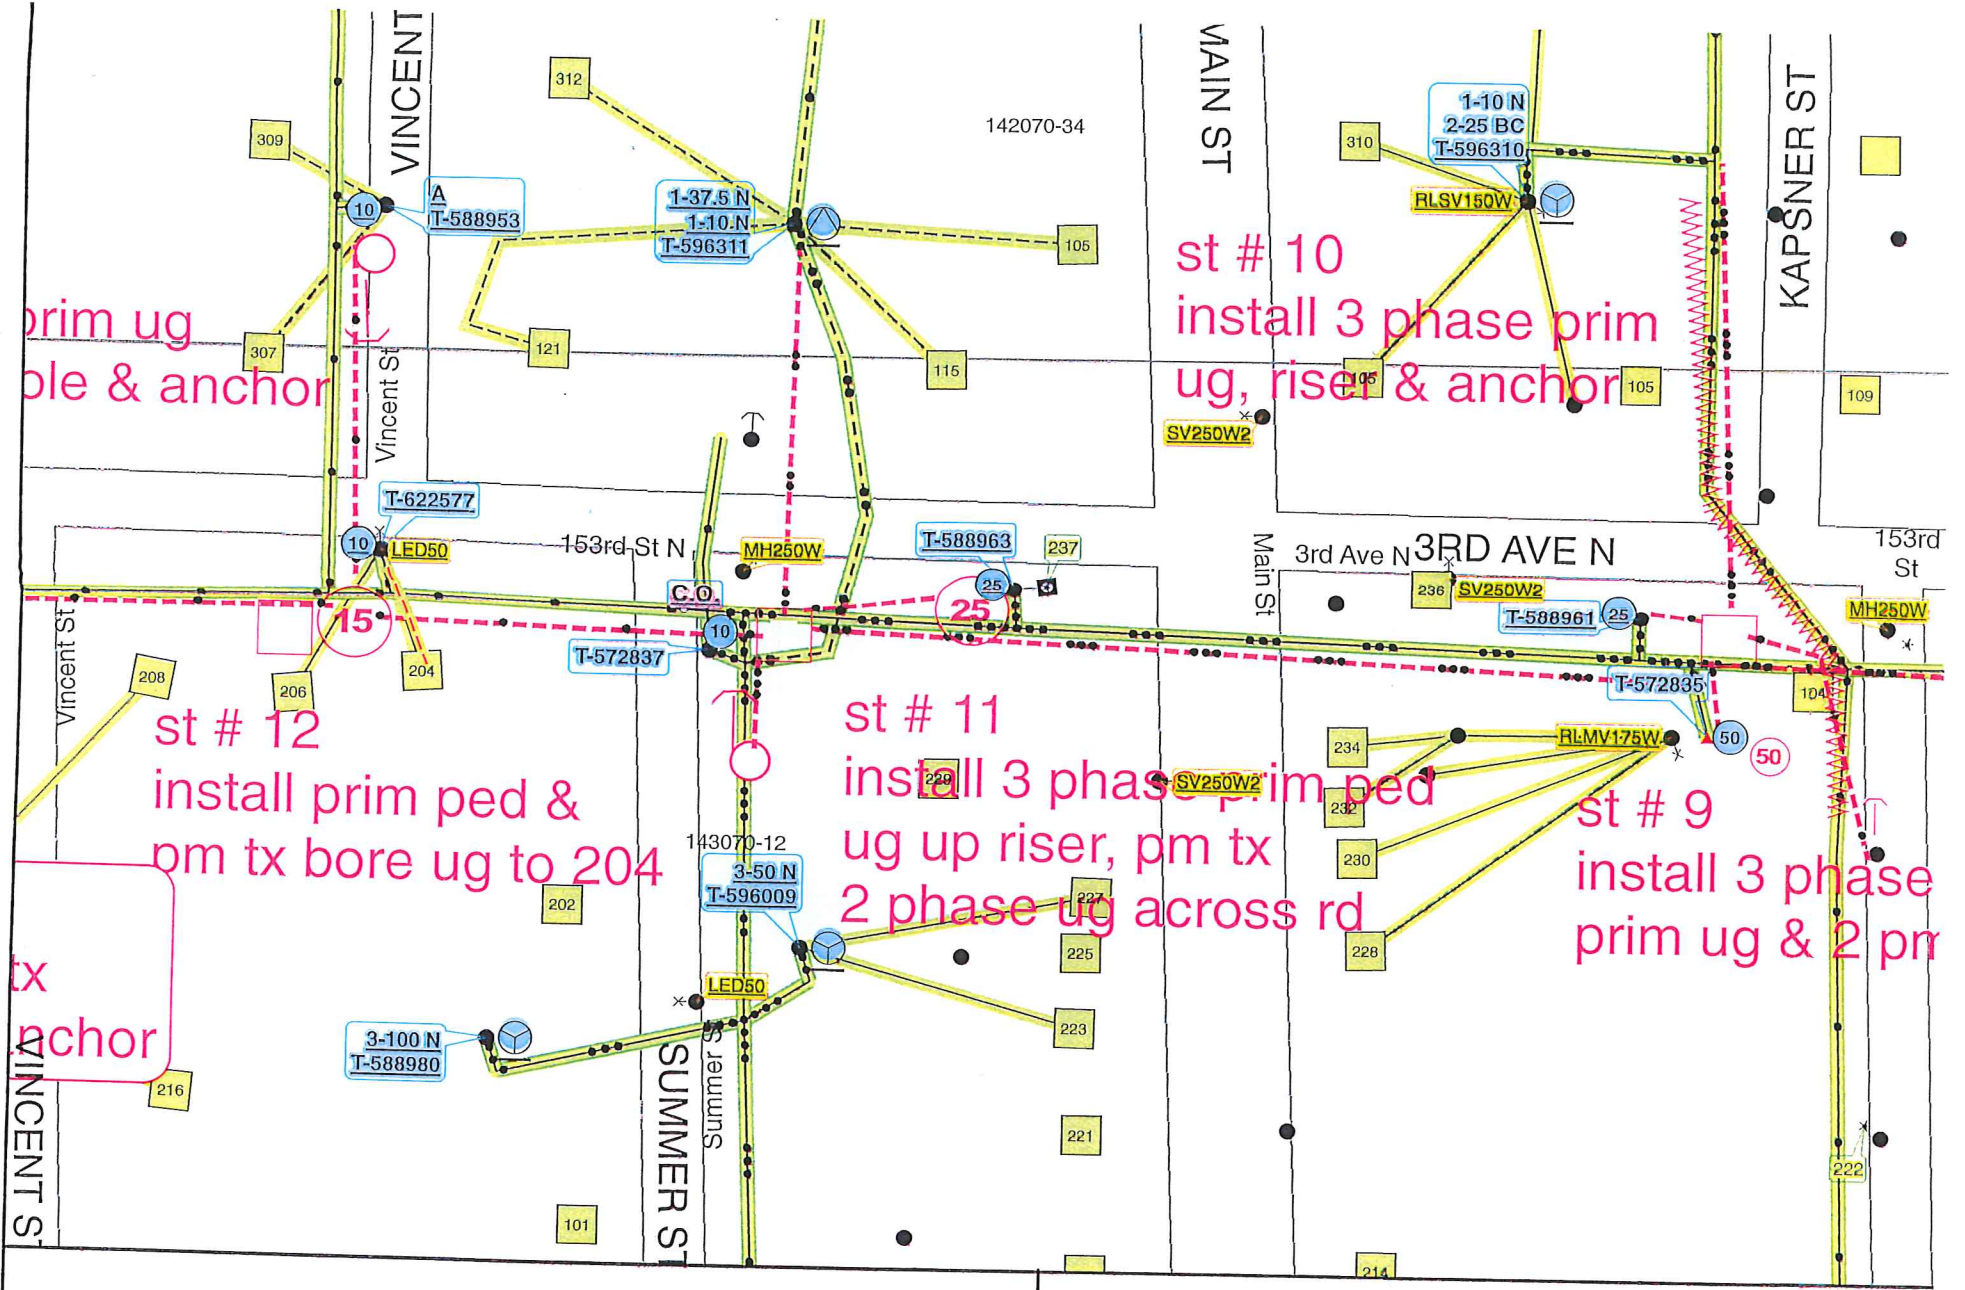

prim ug
ble & anchor


st # 10
install 3 phase prim
ug, riser & anchor

st # 12
install prim ped &
pm tx bore ug to 204

st # 11
install 3 phase prim ped
ug up riser, pm tx
2 phase ug across rd

st # 9
install 3 phase
prim ug & 2 pr

tx
anchor

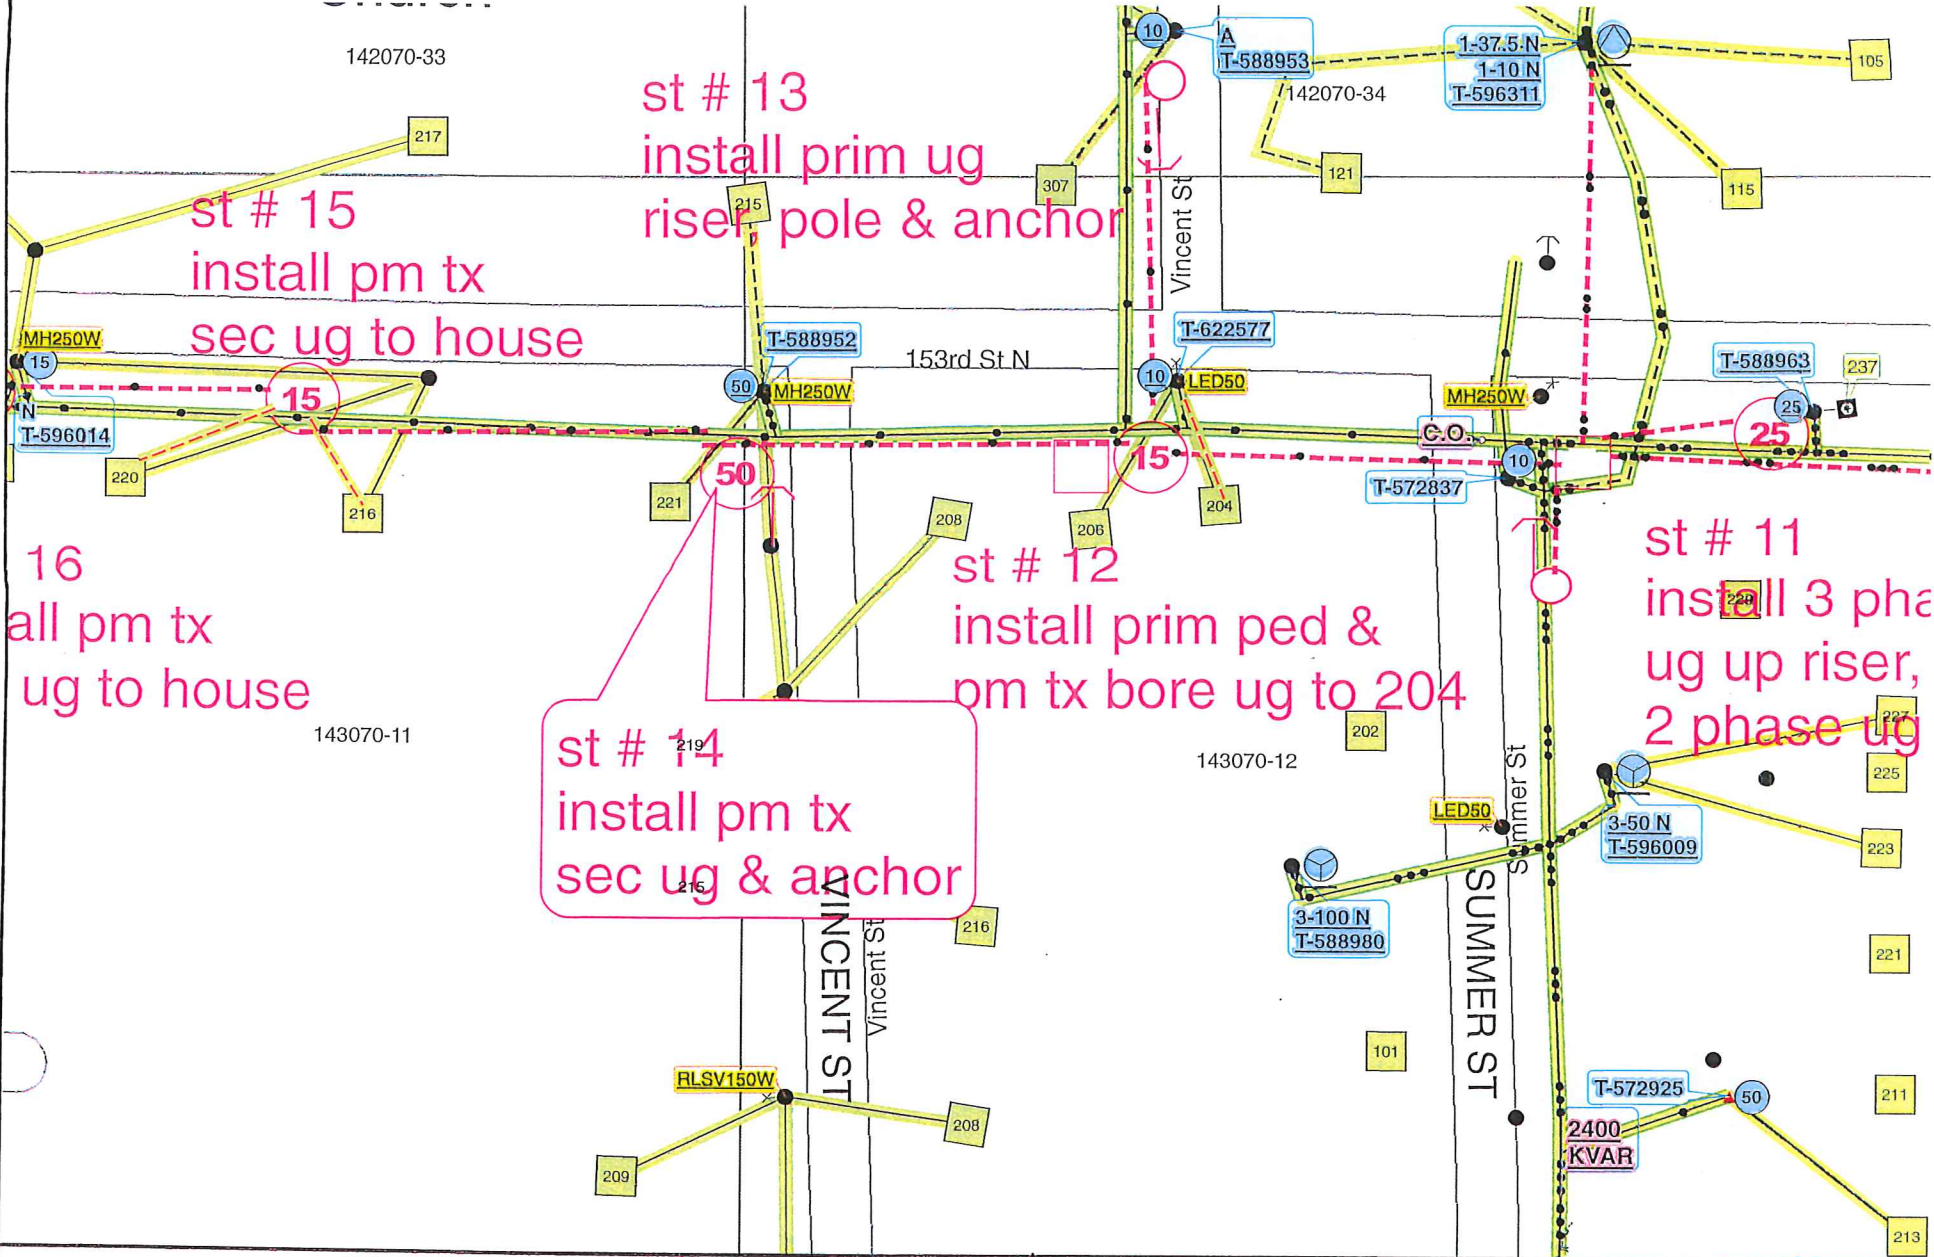

st # 13
install prim ug
riser, pole & anchor

st # 15
install pm tx
sec ug to house


16
all pm tx
ug to house

st # 12
install prim ped &
pm tx bore ug to 204

st # 11
install 3 pha
ug up riser,
2 phase ug

st # 14
install pm tx
sec ug & anchor

142070-33

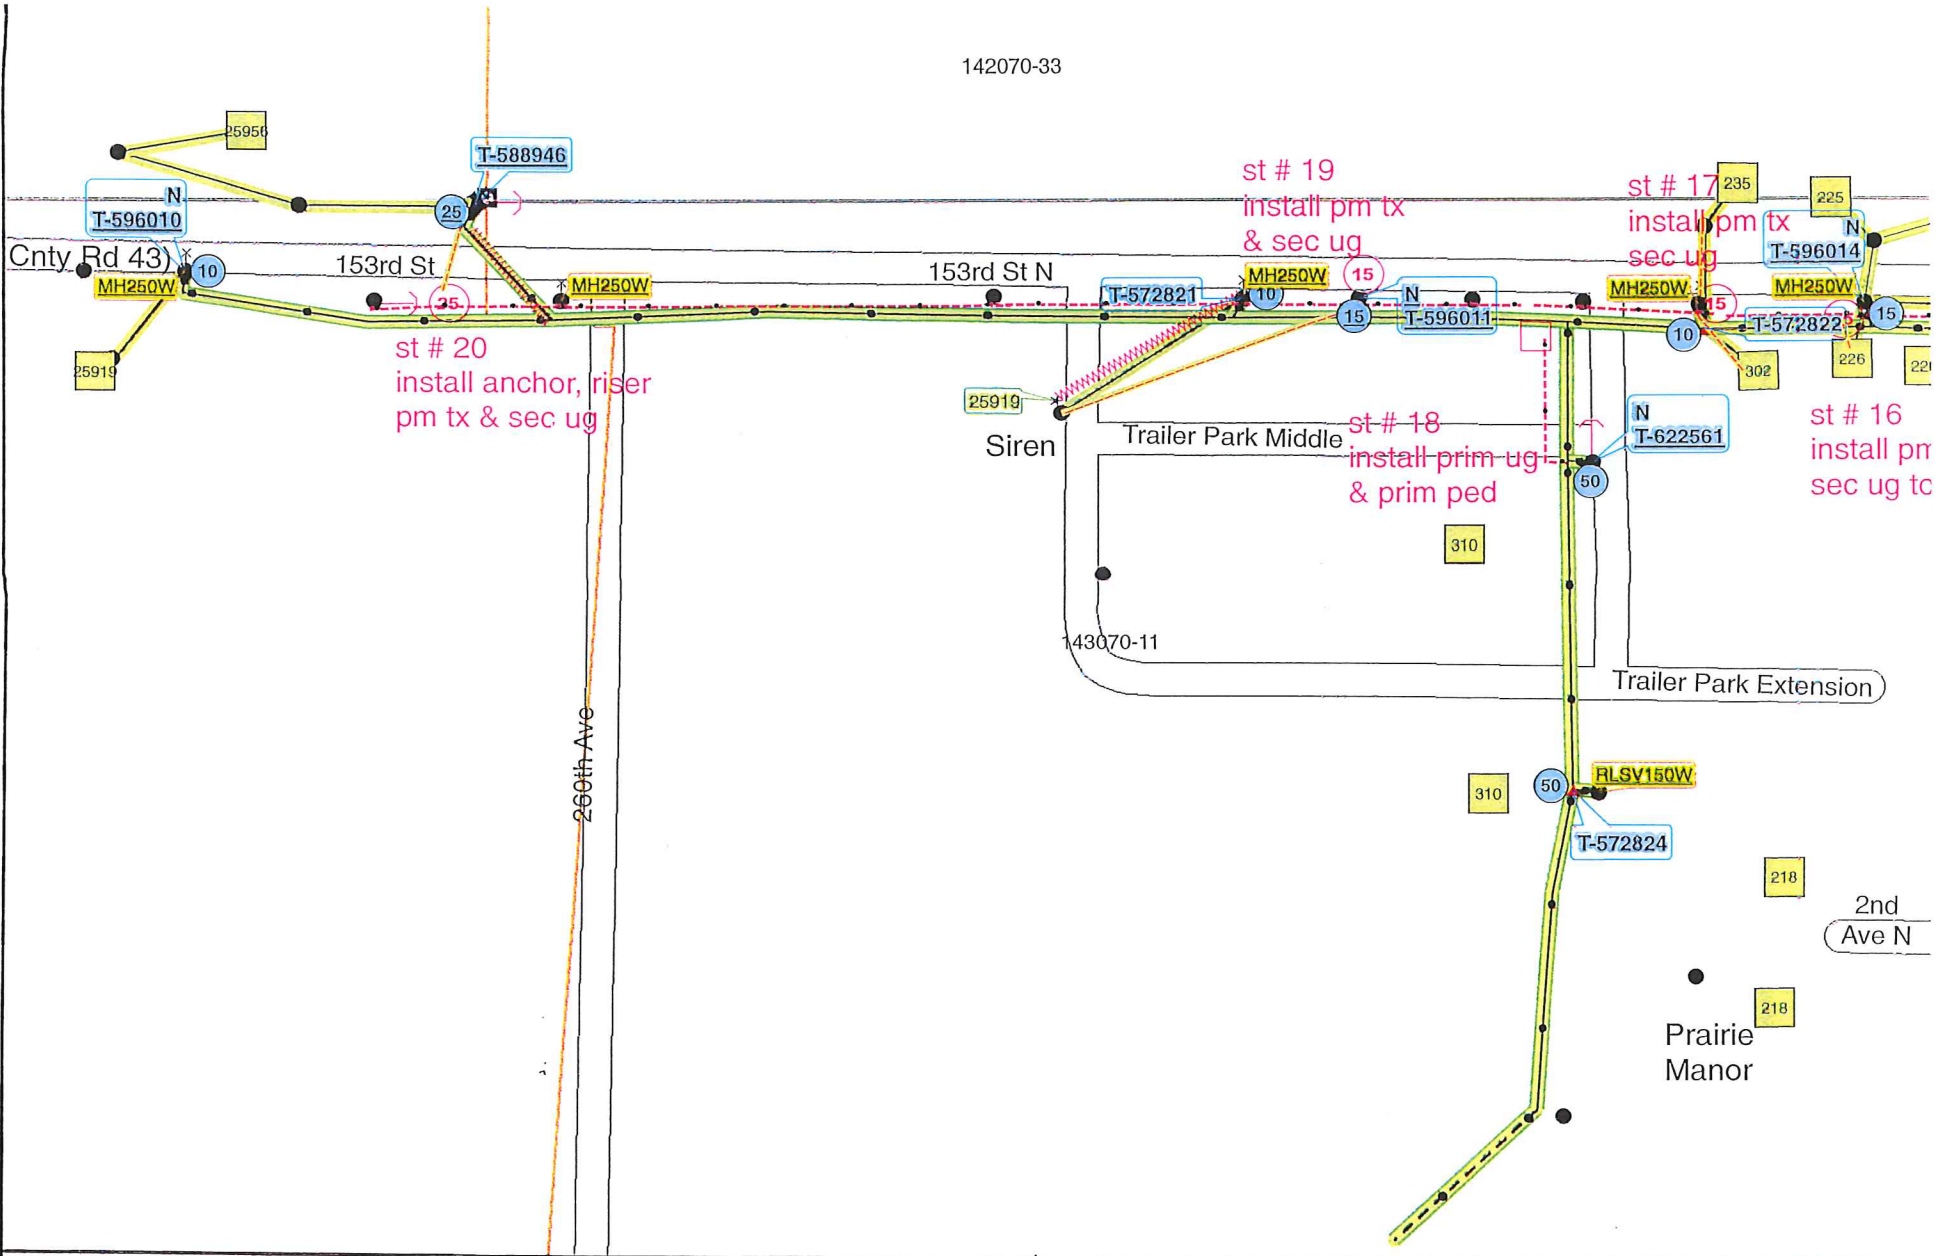

dwitt	12/23/2020
-------	------------

--