


GENERAL LOCATION ONLY. DO NOT USE TO LOCATE FOR EXCAVATION. CALL 1-800-252-1166 FOR ONSITE LOCATIONS AND STAKING.

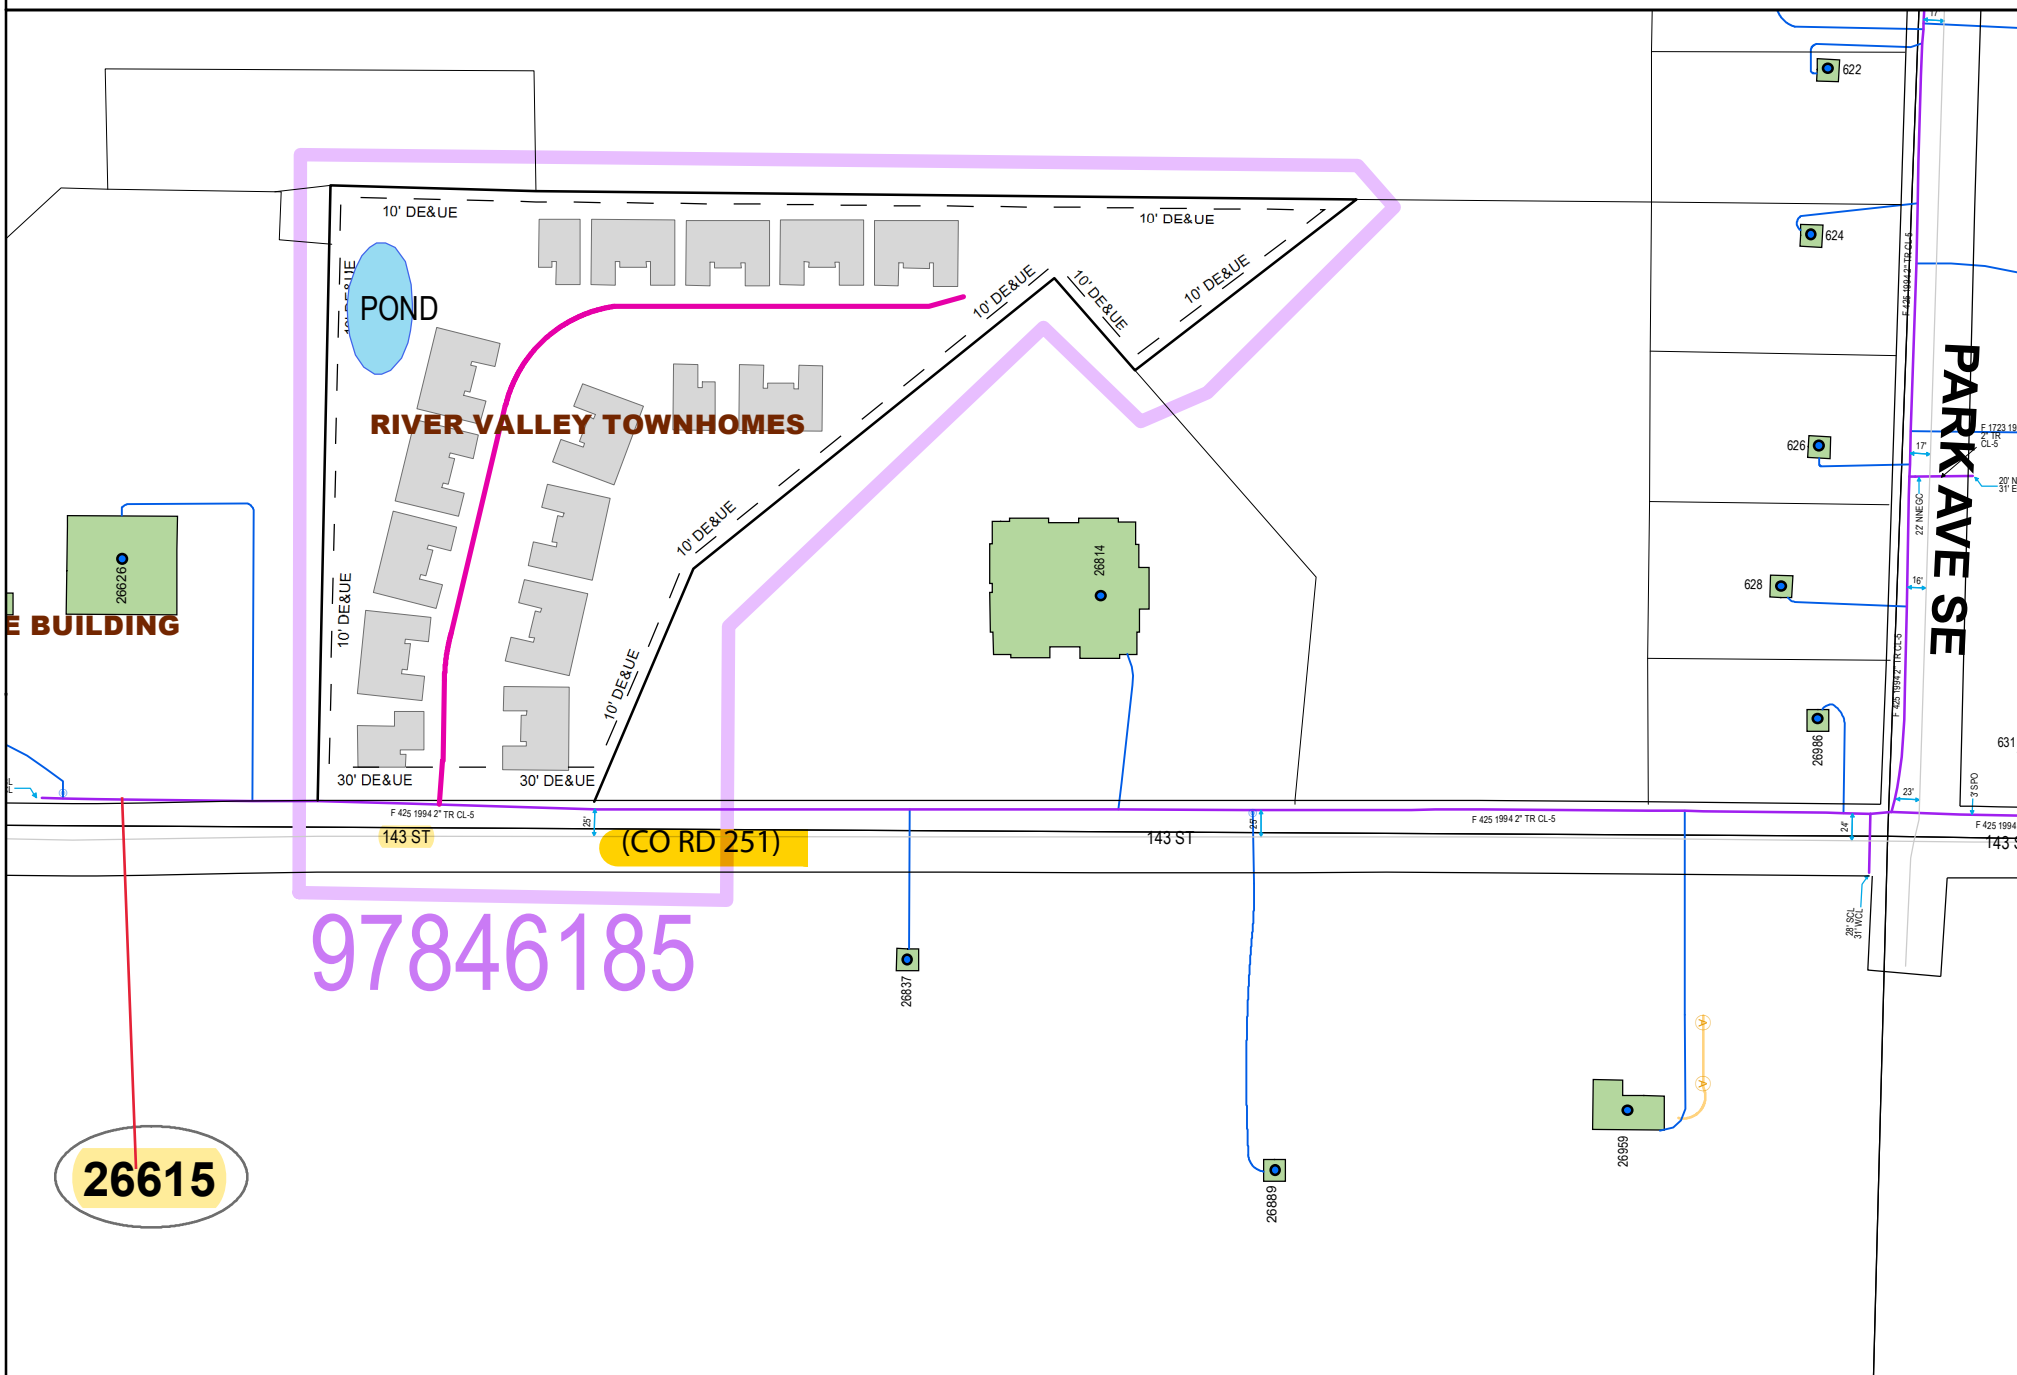

Plotted by: i221539

Plot Date: 7/27/2021

26615 143RD ST (CO RD 251)

PIERZ (MORRISON CO.)

Scale: 1" : 175'

