


1		
Ext	616	6-8 ACWC
Ext	1	F2.8
New	1	35-5
New	1	A5.1
New	1	E1.1
New	1	G10-15
New	1	H1.1
New	1	M8-10-CWP
New	1	UA1 10T FUSE
Ret	1	35-6
Ret	1	A5.1
Ret	1	E1.1
Ret	1	H1.1
Ret	1	UA1

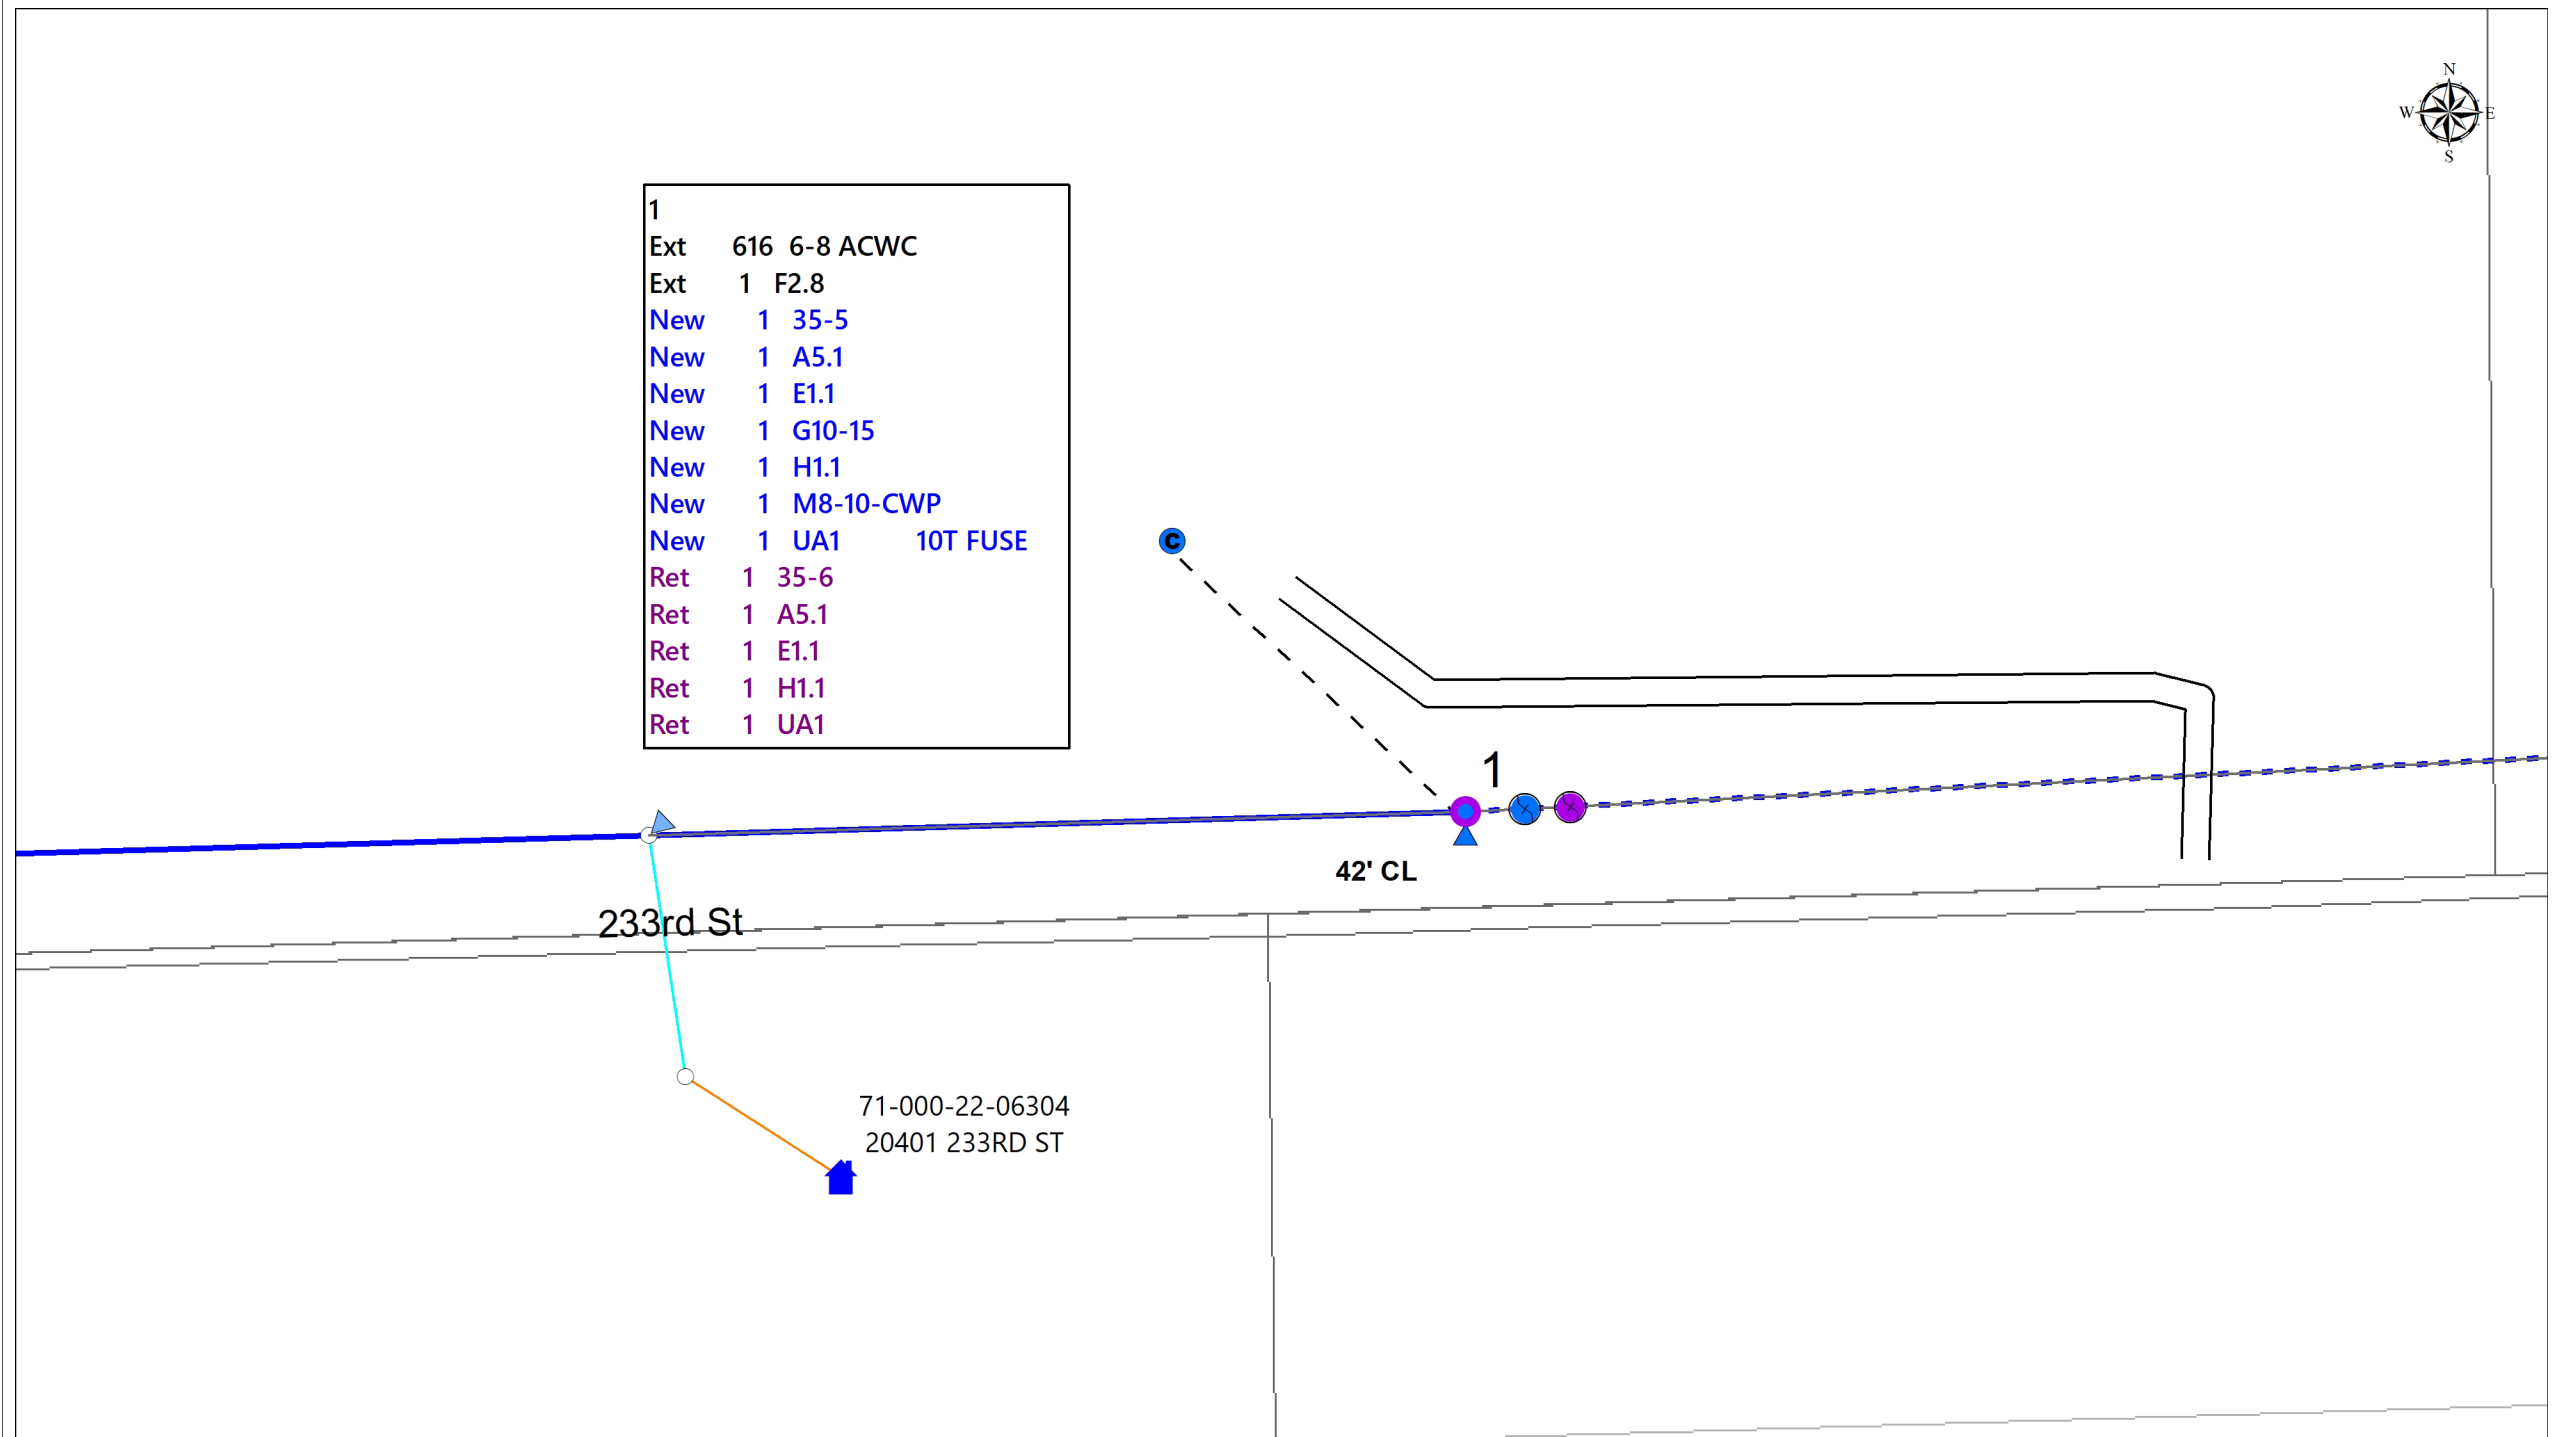

233rd St

42' CL

71-000-22-06304
20401 233RD ST