




LOCATION	BA	BDO	BHF	BDO	BM											HBFO					HO	NID	W			XZ	COMMENTS					
	3	4	TYPE	TYPE	(3)	2	21	53	53	61(3)	72	73	81	83	24	48	72	60	144	192	288	1	12R	TYPE	BDO	BHF	HBFO					
Total	0	0	0	0	0	0	0	0	0	0	0	0	0	0	0	0	0	0	0	0	0	0	0	0	0	0	0	0	0	0	0	0

Project: Reconnect II

Staked By: ED & JP Date:  
 Revised By: Date:  
 As Built By: Date:  
 ROW Width:

0 180 360 Feet

Prepared by: CTC 218-454-1234 12/29/2021

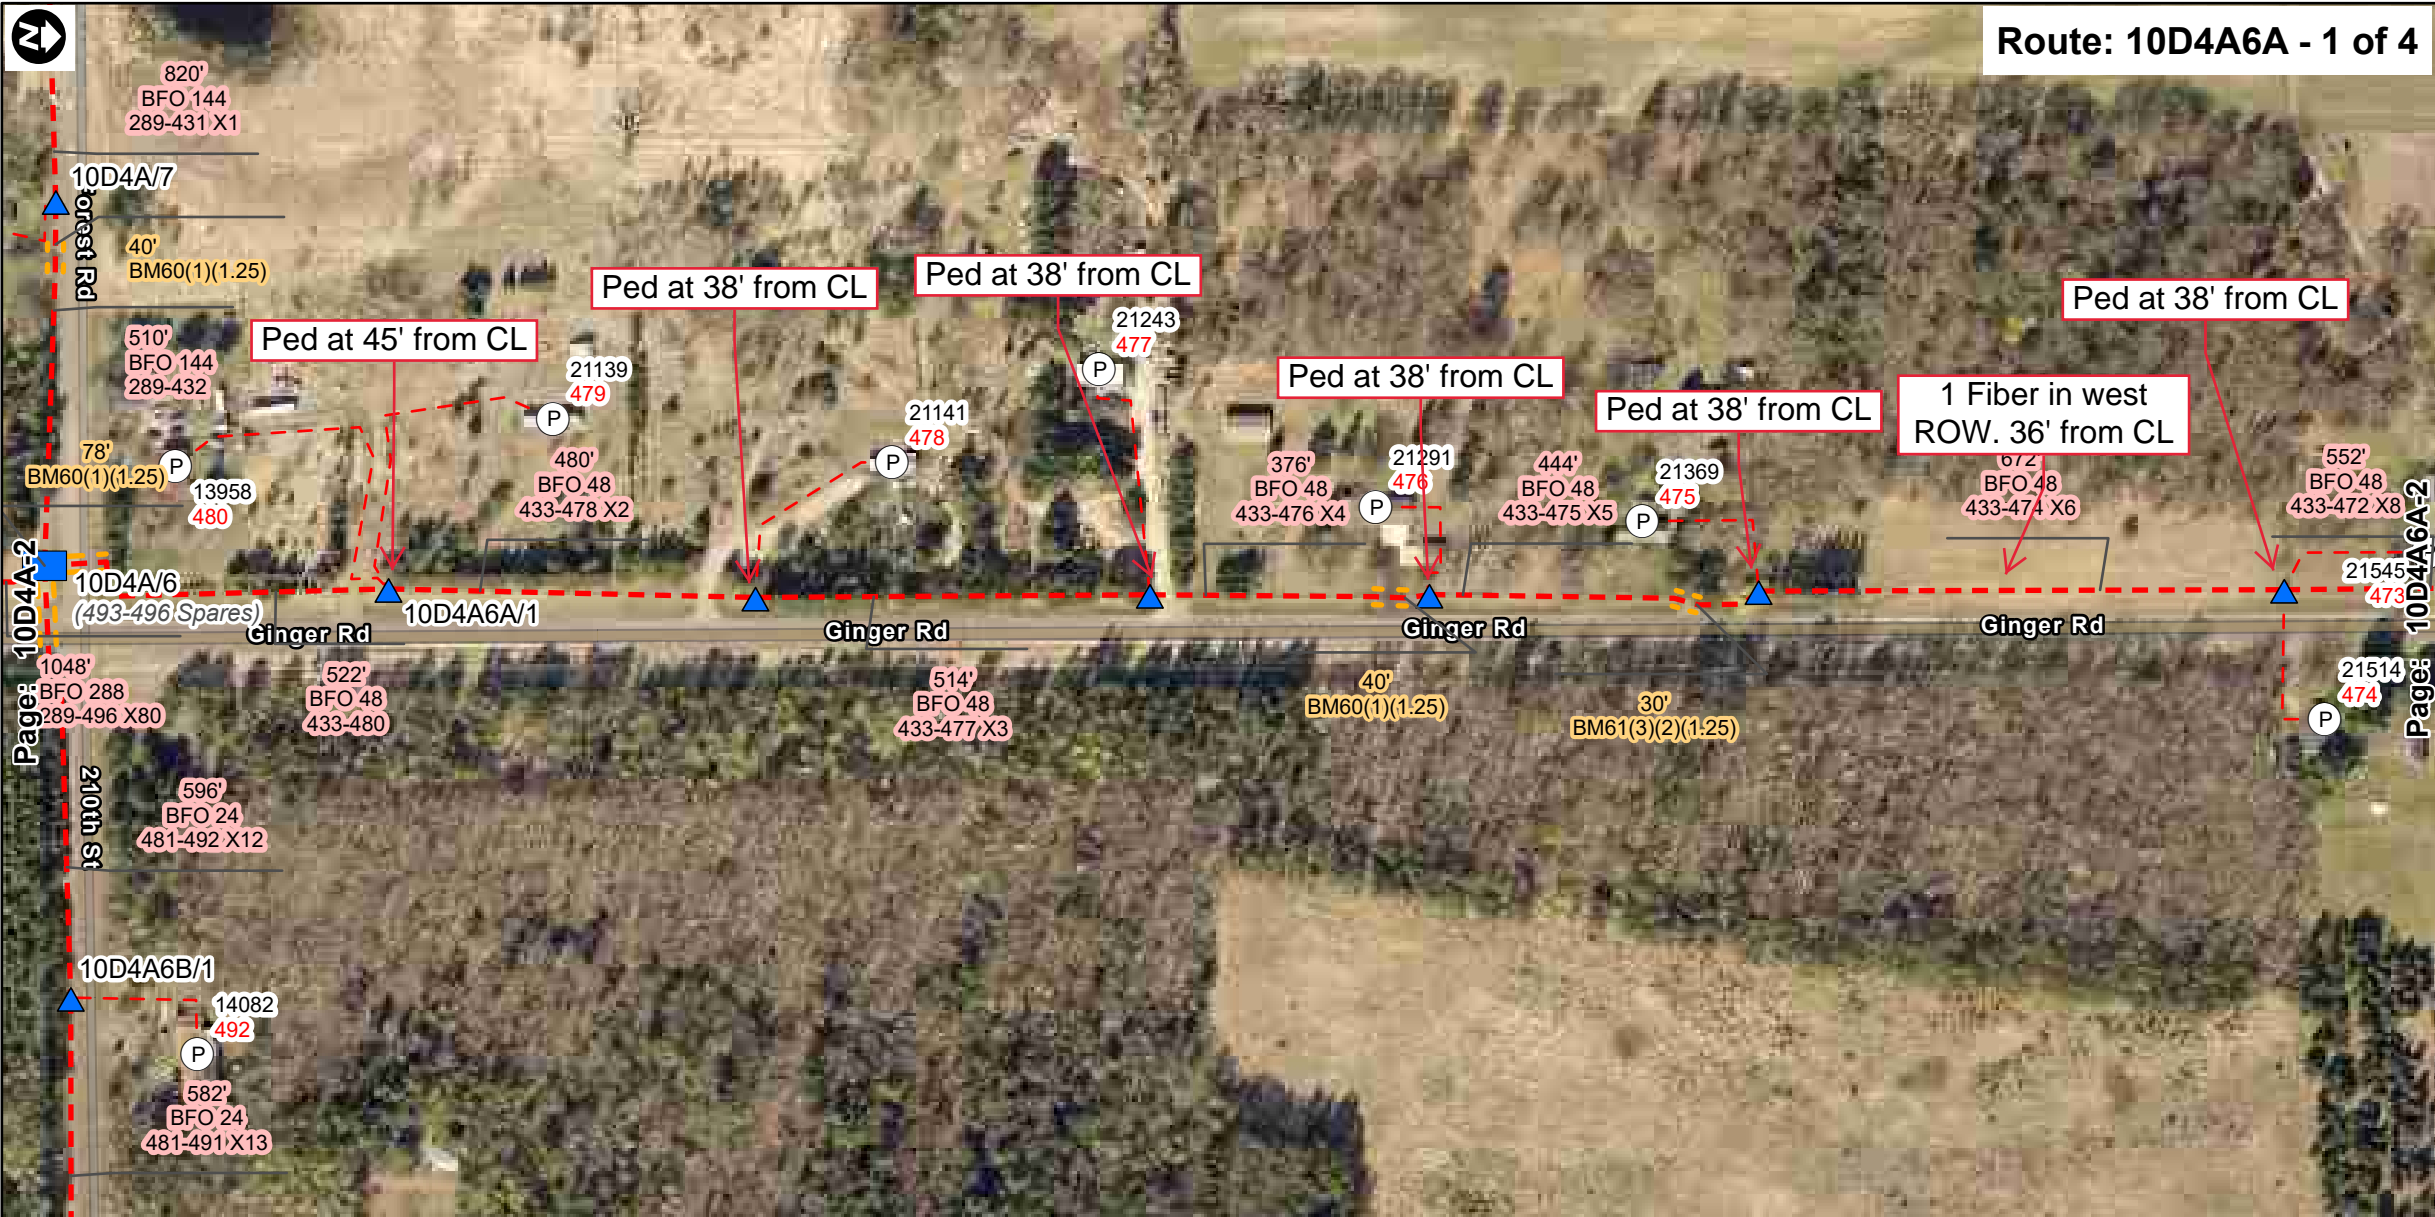

LOCATION	BA	BDO	BHF	BDO	BM										HBFO					HO	NID	W			XZ	COMMENTS					
	3	4	TYPE	TYPE	(3)	2	21	53	53	61(3)	72	73	81	83	24	48	72	96	144	192	288	1	12R	TYPE	BDO	BHF	HBFO				
Total	0	0	0	0	0	0	0	0	0	0	0	0	0	0	0	0	0	0	0	0	0	0	0	0	0	0	0	0	0	0	0

**Project: Reconnect II**

Staked By: ED & JP    Date:  
 Revised By:            Date:  
 As Built By:            Date:  
 ROW Width:

0    160    320  
 Feet

Prepared by:  
 CTC 218-454-1234  
 12/29/2021

Page: 10D4A-2

Page: 10D4A6A-2



LOCATION	BA	BDO	BHF	BDO	BM										HBFO					HO	NID	W			XZ	COMMENTS						
	3	4	TYPE	TYPE	(3)	2	21	53	53	61(3)	72	73	81	83	24	48	72	96	144	192	288	1	12R	TYPE	BDO	BHF	HBFO					
Total	0	0	0	0	0	0	0	0	0	0	0	0	0	0	0	0	0	0	0	0	0	0	0	0	0	0	0	0	0	0	0	0

**Project: Reconnect II**

Staked By: ED & JP    Date:  
 Revised By:                      Date:  
 As Built By:                      Date:  
 ROW Width:

0    200    400  
 Feet

Prepared by:  
 CTC 218-454-1234  
 12/29/2021



LOCATION	BA	BDO	BHF	BDO	BM										HBFO					HO	NID	W			XZ	COMMENTS						
	3	4	TYPE	TYPE	(3)	2	21	53	53	61(3)	72	73	81	83	24	48	72	90	144	192	288	1	12R	TYPE	BDO	BHF	HBFO					
Total	0	0	0	0	0	0	0	0	0	0	0	0	0	0	0	0	0	0	0	0	0	0	0	0	0	0	0	0	0	0	0	0

**Project: Reconnect II**

Staked By: ED & JP    Date:  
 Revised By:                      Date:  
 As Built By:                      Date:  
 ROW Width:


0    140    280  
 Feet

Prepared by:  
 CTC 218-454-1234  
 12/29/2021



LOCATION	BA	BDO	BHF	BDO	BM										HBFO					HO	NID	W			XZ	COMMENTS						
	3	4	TYPE	TYPE	(3)	2	21	53	53	61(3)	72	73	81	83	24	48	72	60	144	192	288	1	12R	TYPE	BDO	BHF	HBFO					
Total	0	0	0	0	0	0	0	0	0	0	0	0	0	0	0	0	0	0	0	0	0	0	0	0	0	0	0	0	0	0	0	0

**Project: Reconnect II**



Staked By: ED & JP    Date:  
 Revised By:            Date:  
 As Built By:            Date:  
 ROW Width:

0    180    360  
 Feet

Prepared by:  
 CTC 218-454-1234  
 12/29/2021



Page: 10D-2

Page: 10D-4

Page: 10D8D-1

LOCATION	BA	BDO	BHF	BDO	BM										HBFO					HO	NID	W			XZ	COMMENTS					
	3	4	TYPE	TYPE	(3)	2	21	53	53	61(3)	72	73	81	83	24	48	72	90	144	192	288	1	12R	TYPE	BDO	BHF	HBFO				
Total	0	0	0	0	0	0	0	0	0	0	0	0	0	0	0	0	0	0	0	0	0	0	0	0	0	0	0	0	0	0	0

**Project: Reconnect II**

Staked By: ED & JP    Date:  
 Revised By:                      Date:  
 As Built By:                      Date:  
 ROW Width:

0    260    520  
 Feet

Prepared by:  
 CTC 218-454-1234  
 12/29/2021



Page: 10D-3

Page: 10D-5

Page: 10D10D-1

LOCATION	BA	BDO	BHF	BDO	BM										HBFO					HO	NID	W			XZ	COMMENTS						
	3	4	TYPE	TYPE	(3)	2	21	53	53	61(3)	72	73	81	83	24	48	72	96	144	192	288	1	12R	TYPE	BDO	BHF	HBFO					
Total	0	0	0	0	0	0	0	0	0	0	0	0	0	0	0	0	0	0	0	0	0	0	0	0	0	0	0	0	0	0	0	0

**Project: Reconnect II**

Staked By: ED & JP    Date:  
 Revised By:            Date:  
 As Built By:            Date:  
 ROW Width:

0    160    320  
 Feet

Prepared by:  
 CTC 218-454-1234  
 12/29/2021



LOCATION	BA	BDO	BHF	BDO	BM										HBFO				HO	NID	W			XZ	COMMENTS							
	3	4	TYPE	TYPE	(3)	2	21	53	53	61(3)	72	73	81	83	24	48	72	90	144	192	288	1	12R	TYPE	BDO	BHF	HBFO					
Total	0	0	0	0	0	0	0	0	0	0	0	0	0	0	0	0	0	0	0	0	0	0	0	0	0	0	0	0	0	0	0	0

**Project: Reconnect II**

Staked By: ED & JP    Date:  
 Revised By:                      Date:  
 As Built By:                      Date:  
 ROW Width:

0    300    600  
 Feet

Prepared by: CTC 218-454-1234  
 12/29/2021

Page: 10D-4

Page: 10D-6





LOCATION	BA	BDO	BHF	BDO	BM																			HO	NID	W			XZ	COMMENTS		
	3	4	TYPE	TYPE	(3)	2	21	53	53	61(3)	72	73	81	83	24	48	72	60	144	192	288	1	12R	TYPE	BDO	BHF	HBFO					
Total	0	0	0	0	0	0	0	0	0	0	0	0	0	0	0	0	0	0	0	0	0	0	0	0	0	0	0	0	0	0	0	0

Project: Reconnect II

Staked By: ED & JP Date:  
 Revised By: Date:  
 As Built By: Date:  
 ROW Width:

0 180 360 Feet

Prepared by: CTC 218-454-1234 12/29/2021



LOCATION	BA	BDO	BHF	BDO	BM										HBFO					HO	NID	W			XZ	COMMENTS					
	3	4	TYPE	TYPE	(3)	2	21	53	53	61(3)	72	73	81	83	24	48	72	96	144	192	288	1	12R	TYPE	BDO	BHF	HBFO				
Total	0	0	0	0	0	0	0	0	0	0	0	0	0	0	0	0	0	0	0	0	0	0	0	0	0	0	0	0	0	0	0

**Project: Reconnect II**

Staked By: ED & JP    Date:  
 Revised By:            Date:  
 As Built By:            Date:  
 ROW Width:

0    140    280  
 Feet

Prepared by:  
 CTC 218-454-1234  
 12/29/2021

Page: 10D-6

Page: 10D-8



LOCATION	BA	BDO	BHF	BDO	BM										HBFO					HO	NID	W			XZ	COMMENTS					
	3	4	TYPE	TYPE	(3)	2	21	53	53	61(3)	72	73	81	83	24	48	72	96	144	192	288	1	12R	TYPE	BDO	BHF	HBFO				
Total	0	0	0	0	0	0	0	0	0	0	0	0	0	0	0	0	0	0	0	0	0	0	0	0	0	0	0	0	0	0	0

**Project: Reconnect II**

Staked By: ED & JP    Date:  
 Revised By:            Date:  
 As Built By:            Date:  
 ROW Width:

0    140    280  
 Feet

Prepared by:  
 CTC 218-454-1234  
 12/29/2021