




1
Ext 297 1/0 ACSR
Ext 891 4/0 ACSR
Ext 1 40-5
Ext 1 C1.11P
Ext 1 H1.1
Ext 1 S1.01
Ext 1 A5.21
Ext 1 E1.1

2
Ext 532 4 ACSR
Ext 1 F2.8
New 1 40-5
New 1 A4.1
New 2 E1.1
New 1 F2.8
New 1 H1.1
Ret 1 40-5
Ret 1 A4.1
Ret 2 E1.1
Ret 1 F2.8
Ret 1 H1.1

3A
New 162 2 GOPHER PIPE
New 162 4/0 USE
New 1 OWNER PED
Ret 1 30-6
Ret 133 4 TX
Ret 1 E1.1
Ret 1 F2.8
Ret 1 H1.1
Ret 1 K15L
Ret 1 OWNER LOOP

3
Ext 472 4 ACSR
Ext 1 G10-10 P9141
New 1 35-5
New 1 A5.1
New 1 E1.1
New 1 F2.8
New 1 H1.1
New 1 UM5

3.1
Ret 1 35-5
Ret 122 4 ACSR
Ret 1 A5.1
Ret 2 E1.1
Ret 2 F2.8
Ret 1 H1.1

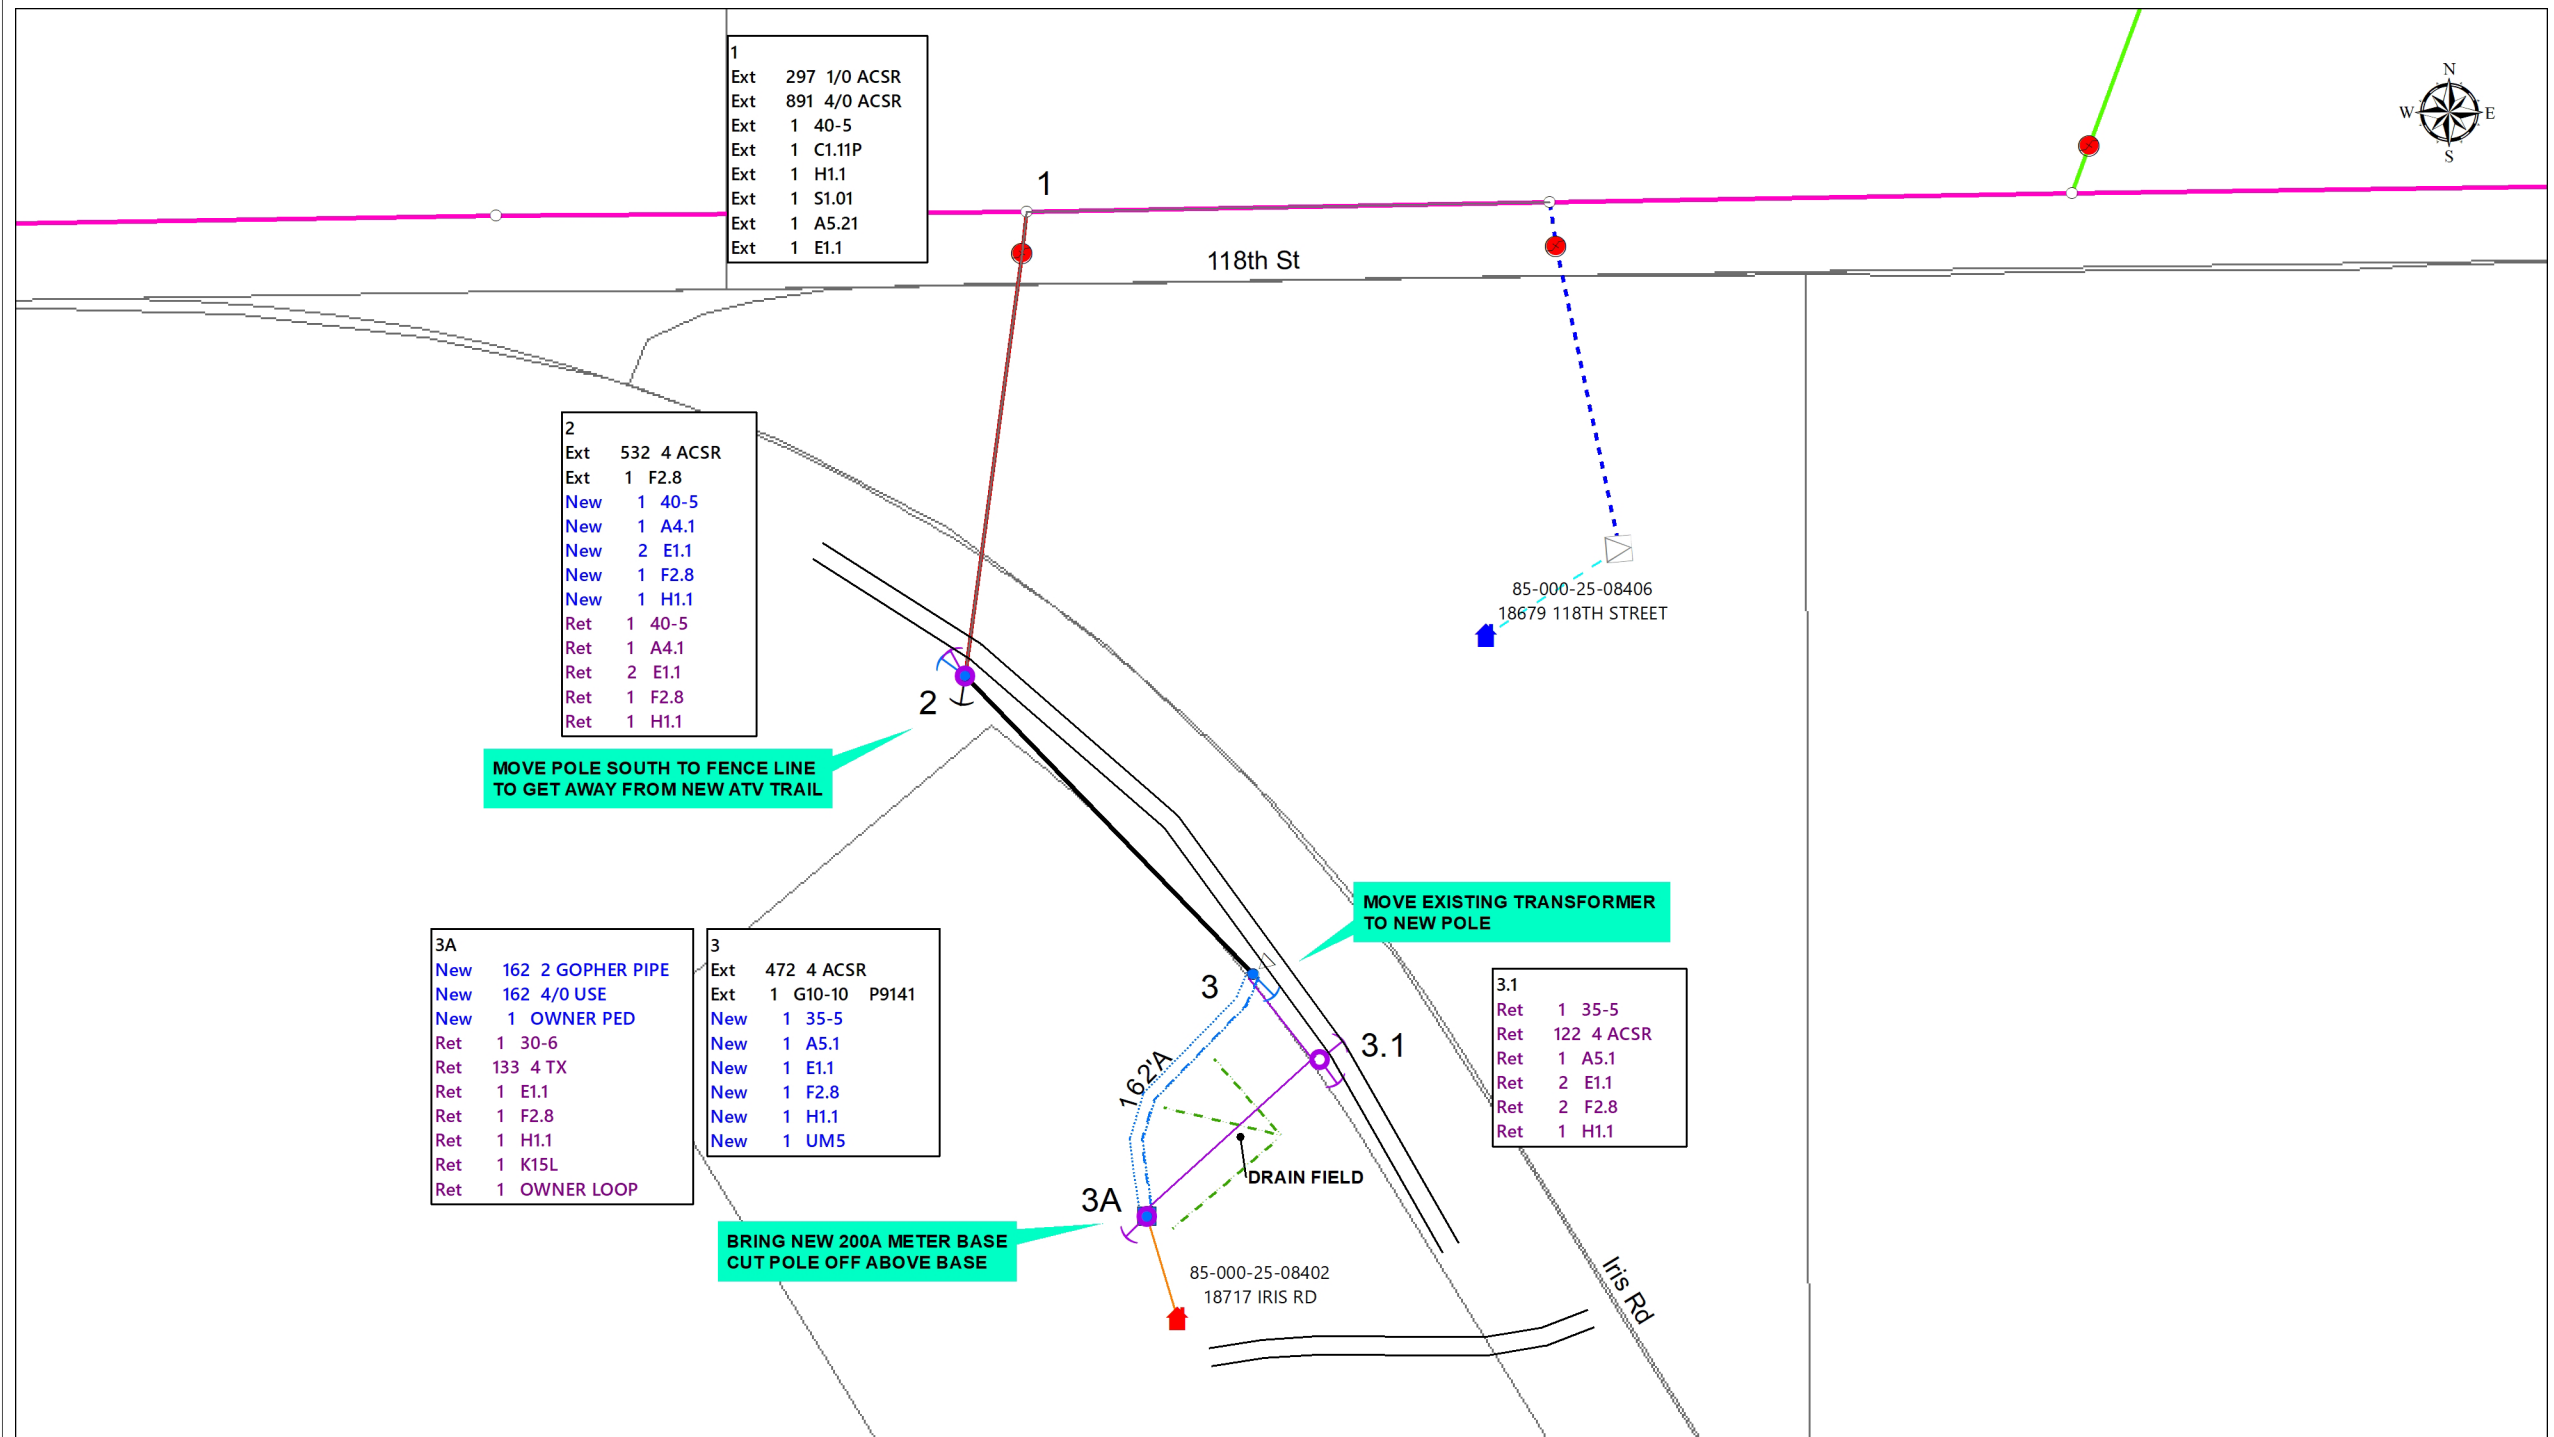

MOVE POLE SOUTH TO FENCE LINE TO GET AWAY FROM NEW ATV TRAIL

MOVE EXISTING TRANSFORMER TO NEW POLE

BRING NEW 200A METER BASE CUT POLE OFF ABOVE BASE

85-000-25-08406
18679 118TH STREET

85-000-25-08402
18717 IRIS RD

118th St

Iris Rd

DRAIN FIELD