


CenturyLink BSW Order/Maintenance Work Authorization

Company	Exchange Name LTFLMNLF	Service Order#	120630
Work Activity	Drop-Buried Copper	Capital	Y
Customer Name	Denny Skoglund	Phone#	
Address	9925 Cable Rd	One Call Ticket#	
City & Zip	Little Falls 56345		
Location/Directions			
Description of Work or Special Instructions	plow bsw		

Held Order	Y	N	Permit:	Y	N	Bore:	Y	N	CBR#	320-412-0687	
Tech Name and Tech #	Robert 343					Employee Contact#	320-291-9640				

Sketch <small>(Include Cntr Line & Pedestal)</small>	Material/Labor Units		Footage/Quantity	Comments
	Description	Notes		
Cntr Line foot	SEB3-22	BSW-3 & plow plcmt	325	
	SEB3-22T	BSW-3 & hand dig plcmt		
Ped#	SEPCUTOVER	CUTOVER BSW		
Parish/County	BM83	BSW guard at house		
	XXSEB-GL	Remove temp drop	325	Footage when temp can't be re-used
Township:	BM61(1.25)SEB	BSW Bore footage		
Section	SEBO PER FT LBR	Fiber & plow plcmt		
Range	SEBO PER FT LBR T	Fiber & hand dig plcmt		
	SEB6-22	BSW-6 & plow plcmt		
	BM2(5/8)(8)	Ground Rod		
	SEBO-COIL	Fiber Coil		Coil excess on Fiber drop add 1 unit
	Permit	Permit		Any placement within the ROW requires a permit
Nearest cross st.	Mud Lake ave		Plat Page	Map#

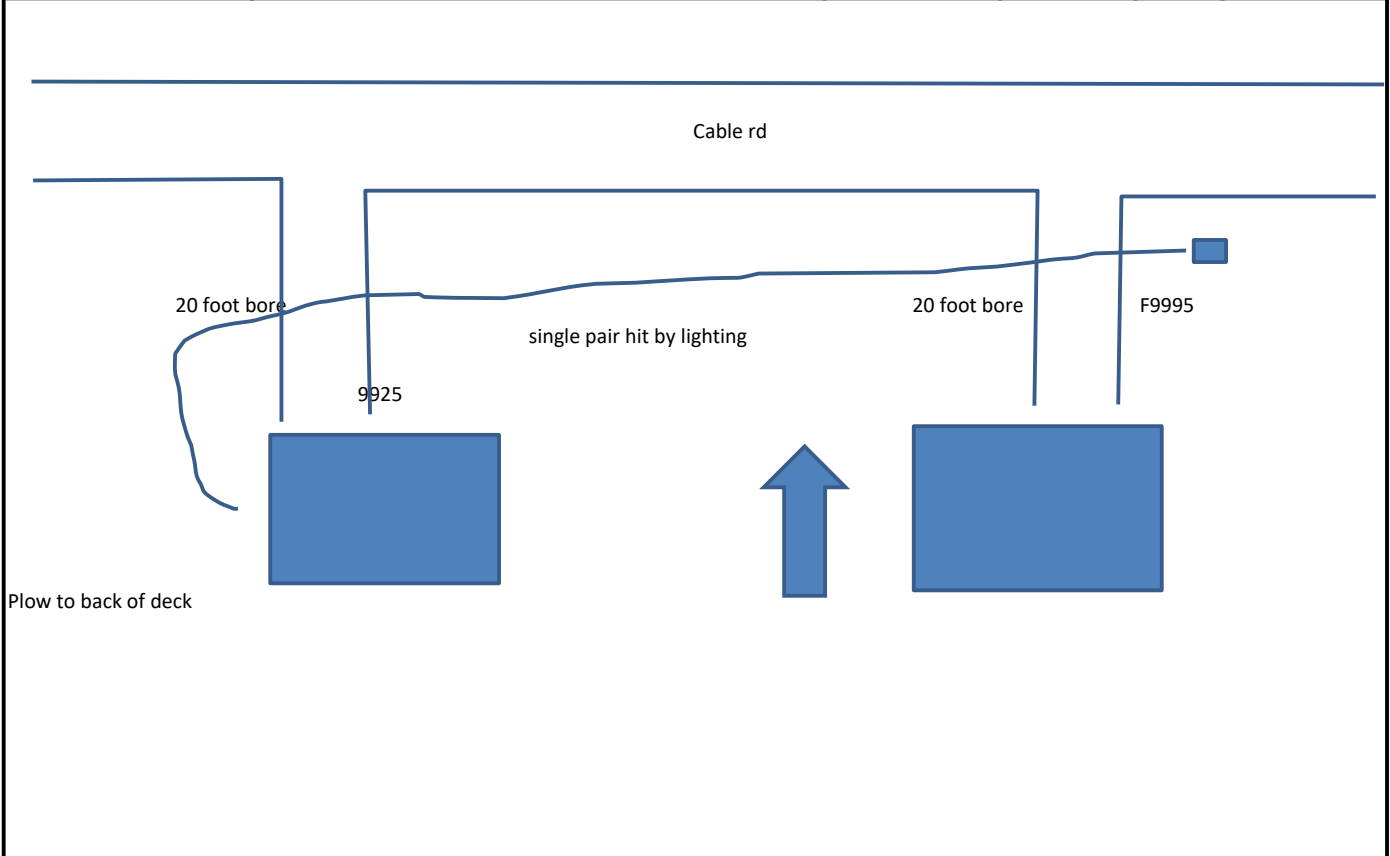

Originated By:	Robert	Date:	8/19/22	Completed By:		Date:	
Authorized By: (SRO)	Angel Mankowski	Date:		Inspected By:		Date:	
Authorized By: (MRO)		Date:					

1. Distance of the bury in Right-of-Way	3. Distance to the nearest intersection
2. Distance from the terminal to the centerline	4. Nearest State Hwy mile marker