


GENERAL LOCATION ONLY. DO NOT USE TO LOCATE FOR EXCAVATION. CALL 1-800-252-1166 FOR ONSITE LOCATIONS AND STAKING.

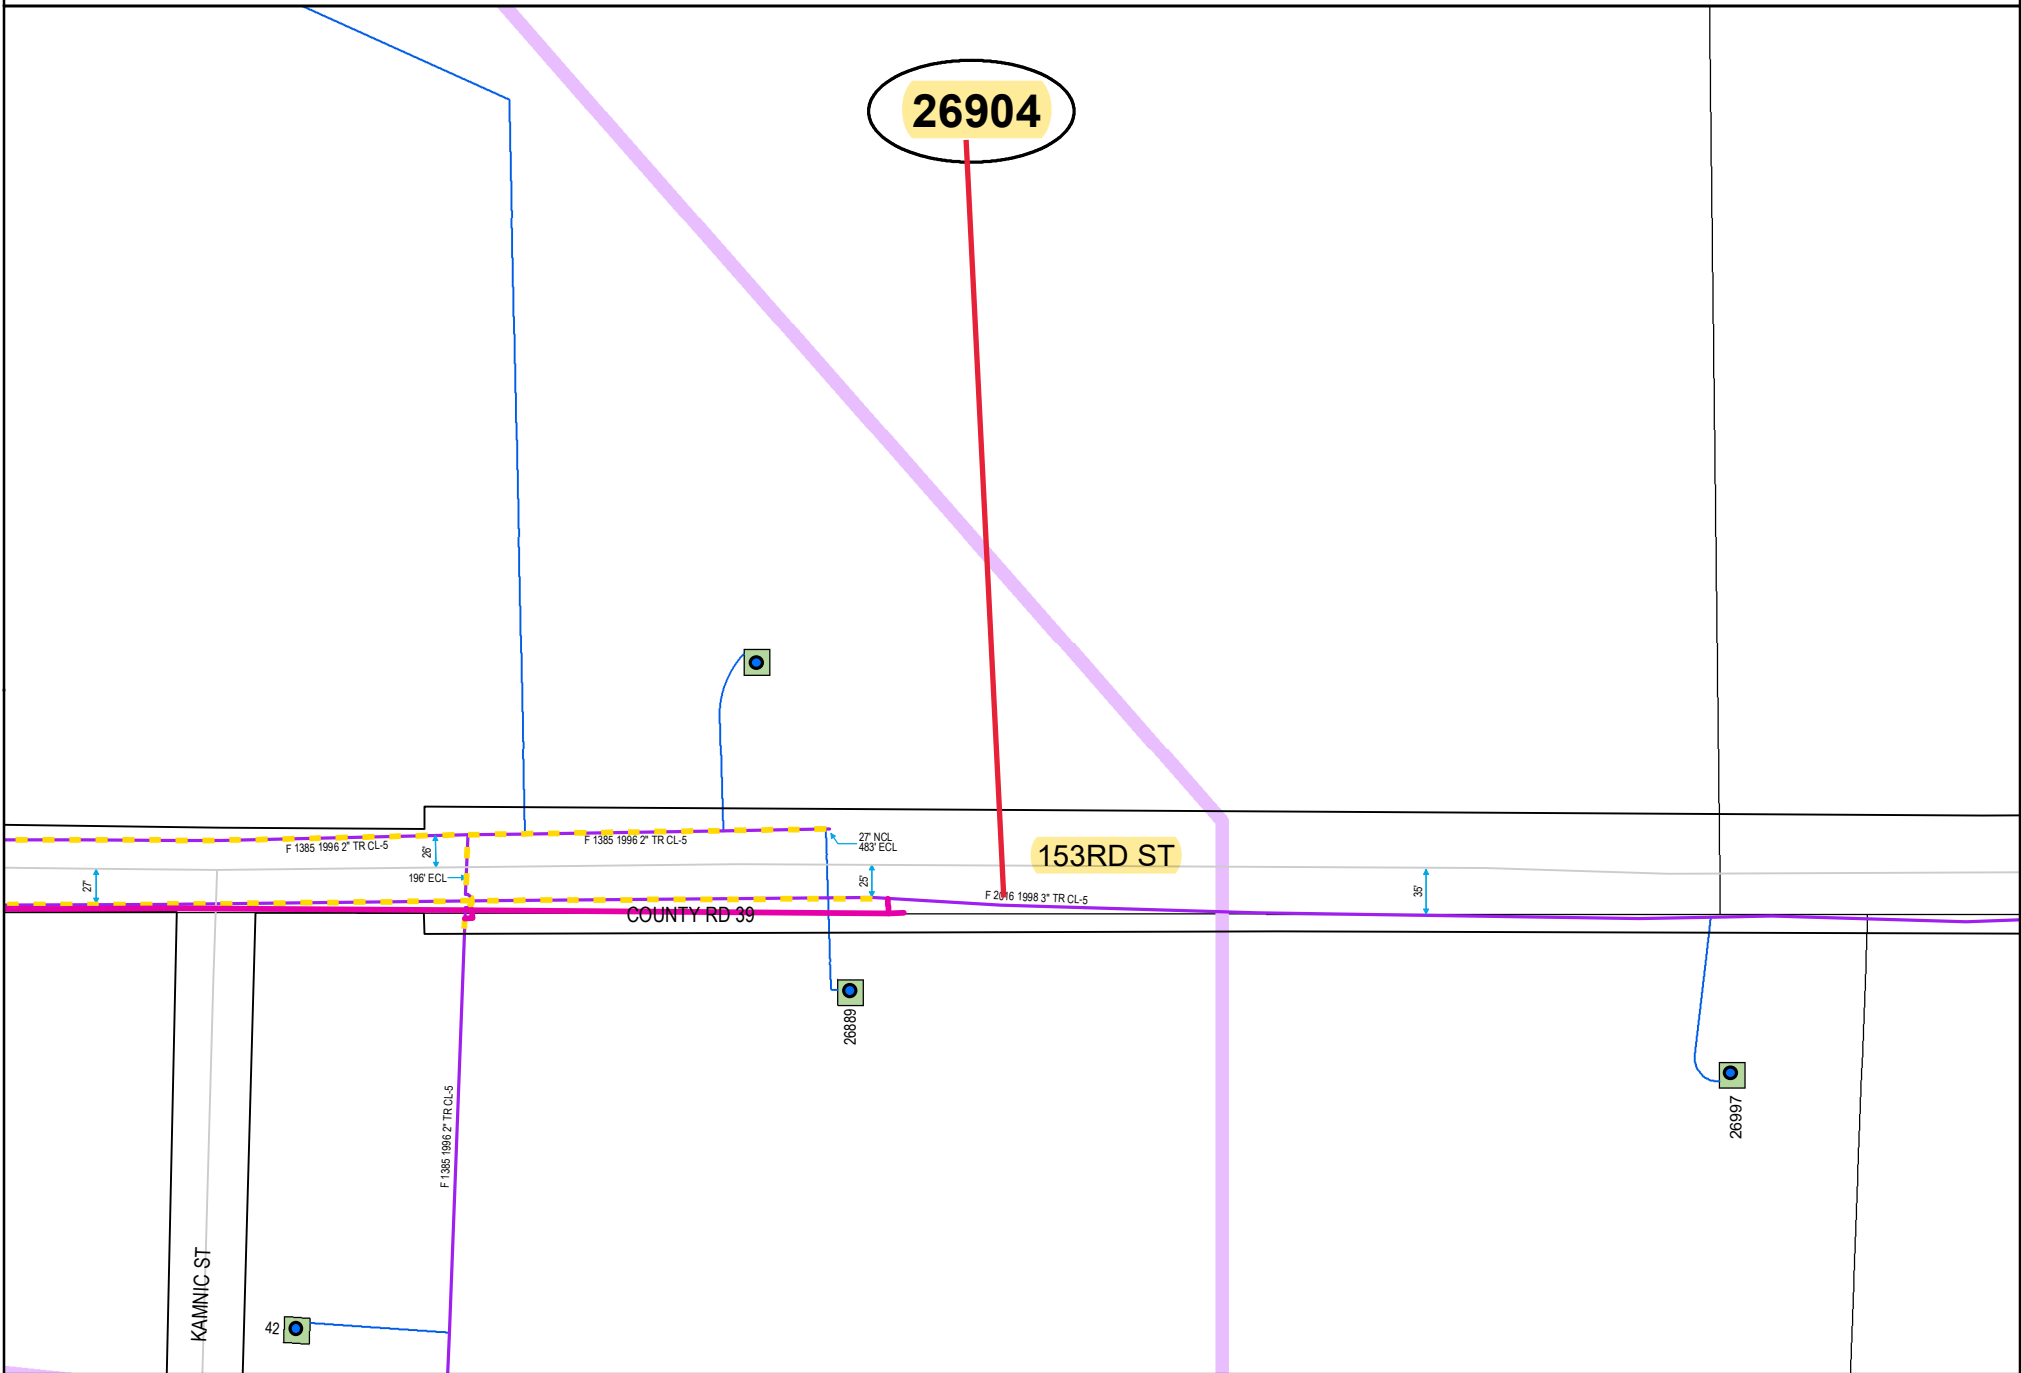

Plotted by: i228736

Plot Date: 10/3/2022

26904 153RD ST
PIERZ, MORRISON COUNTY

Scale: 1" : 150'

