


18" X 62' C.S. PIPE CULV.

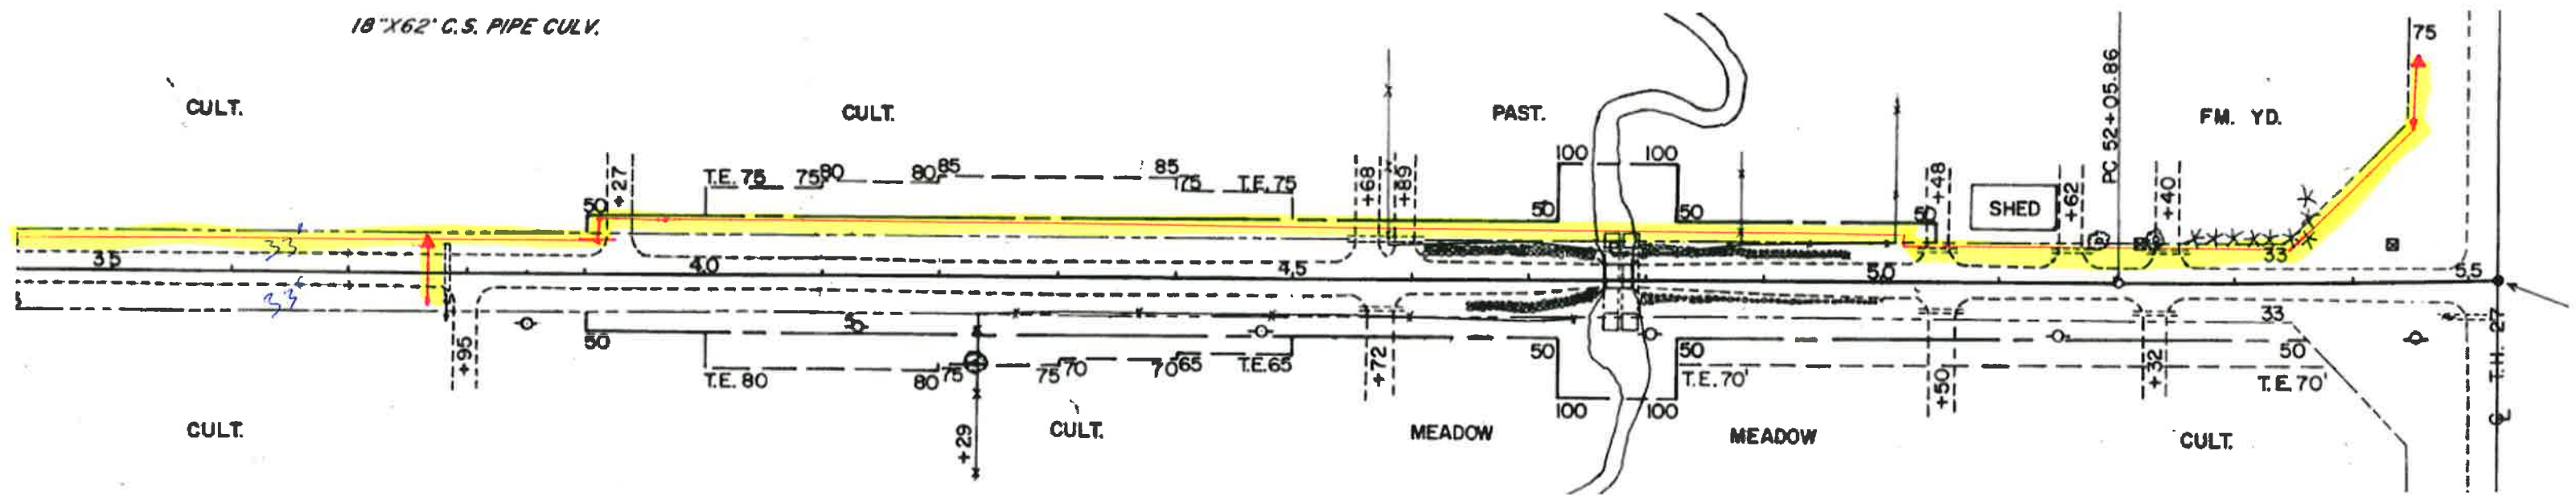

CULT.

CULT.

PAST.

FM. YD.

CULT.

CULT.

MEADOW

MEADOW

CULT.

T.E. 75 75 80 80 85 85 75 T.E. 75

T.E. 80 80 75 75 70 70 65 T.E. 65

T.E. 70

T.E. 70

PC 52+05.96

SHED

75

+95

+27

+68

+89

+72

+48

+62

+40

+32

+29

35

33

40

4.5

100

100

50

50

50

33

50

5.5

