


GENERAL LOCATION ONLY.
DO NOT USE TO LOCATE FOR EXCAVATION.
CALL 1-800-252-1166 FOR ONSITE LOCATIONS AND STAKING.

MGC# 23-69928

Scale: 1" = 39'

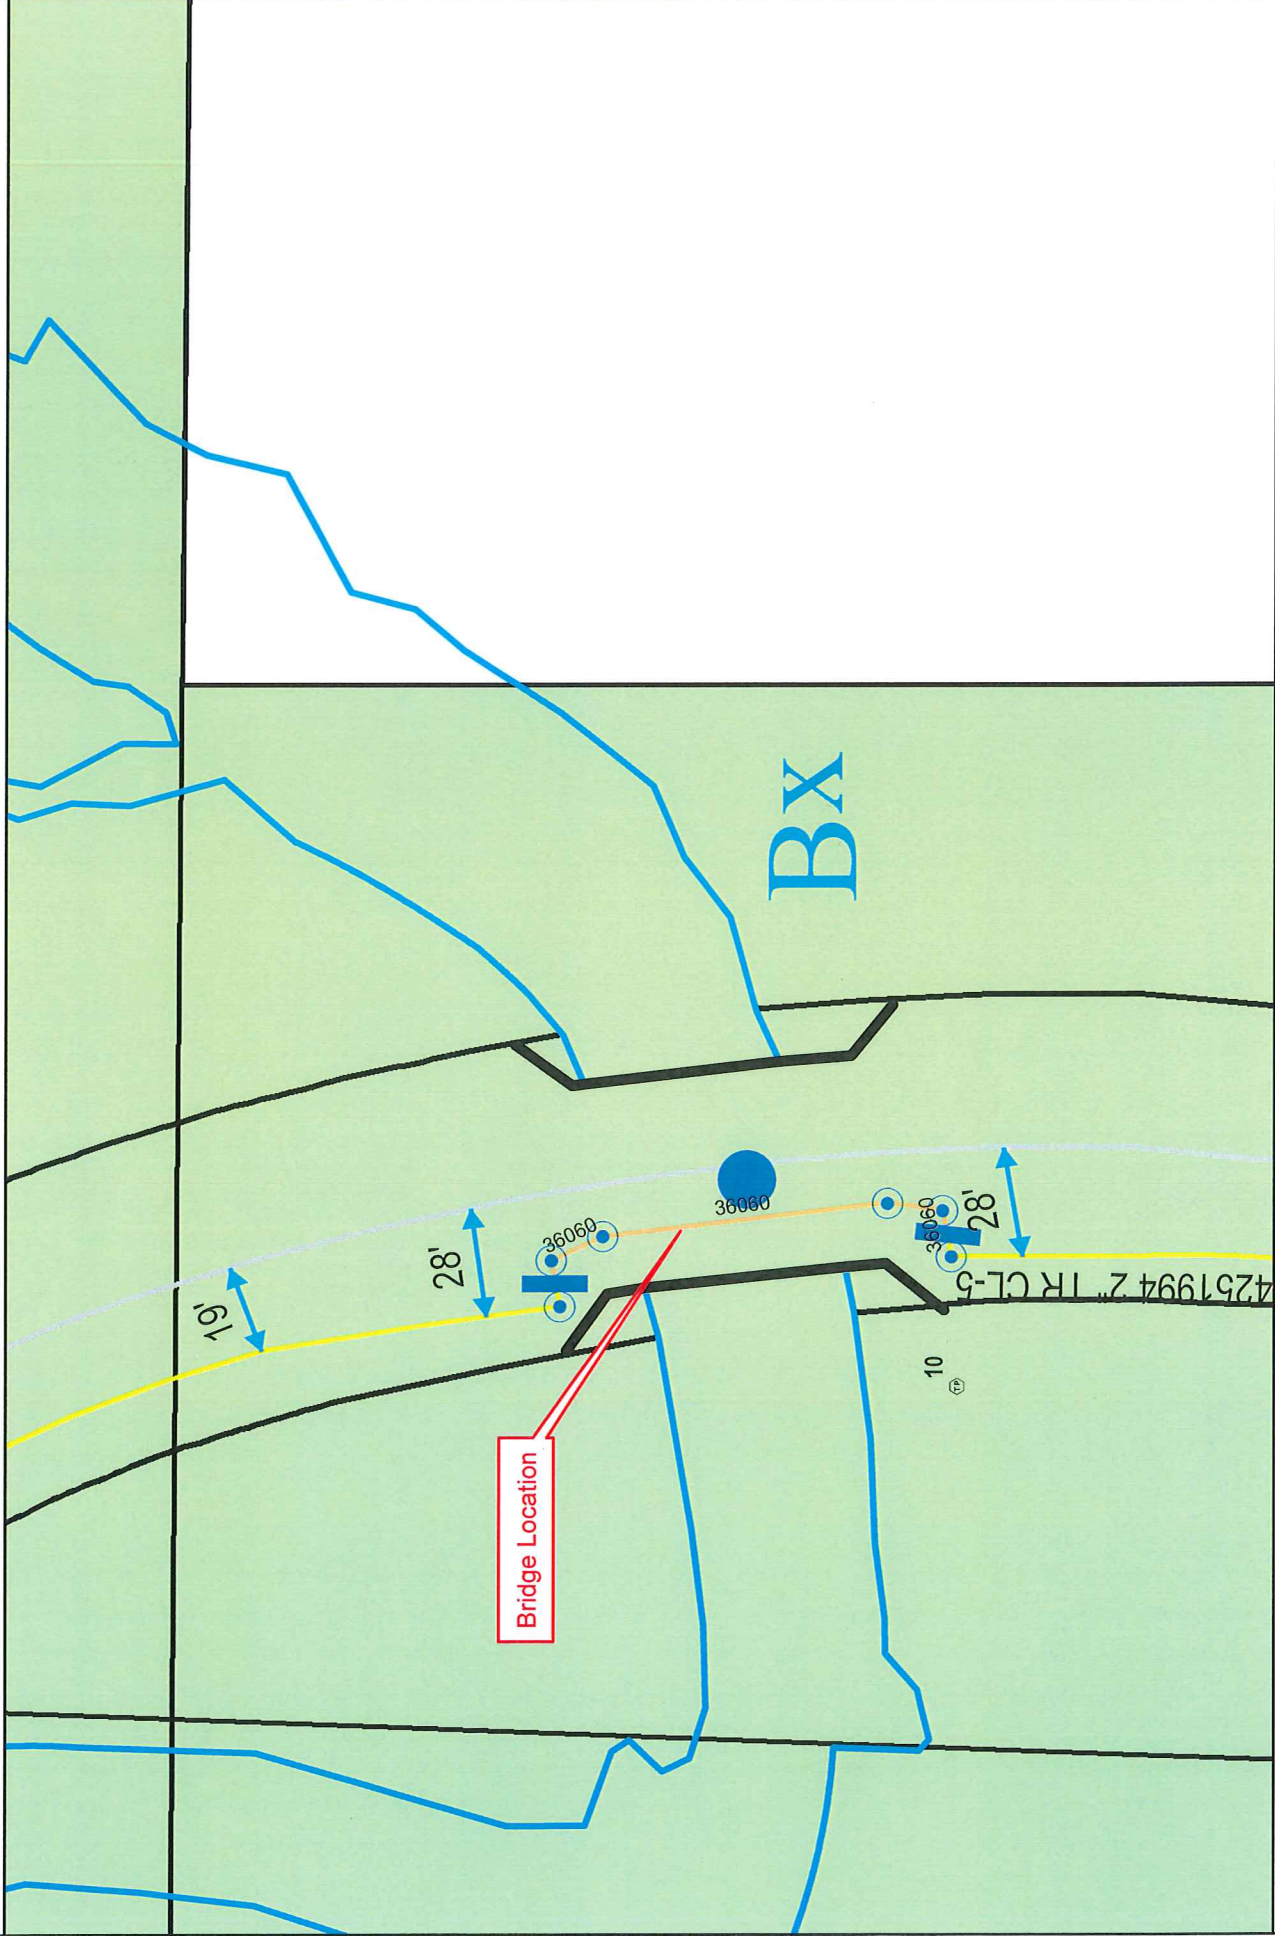

Work Order #: 105479418

Design Date: 1/17/2023

City: Pierz

Quad/Sec/Twp/Rng: SWQtr/S9/T40/R30

CP Section #: 36060

CP Area: 1569

Designed By: Darin Mindrup

Designer Phone #: 612-476-4795