



# Gas Operations C&M Completion Form



W.O. #	S000107277633	Completed By	00068995	Date	4/25/2023
Address	1208 W RIVER RD WAREHOUSE	City	LITTLE FALLS		

## Remarks:

SAP# 107277633 MGC# 23-70325

**ABANDON 1 1/4" PE SERVICE PER CUSTOMER REQUEST DEMO BUILDING BECAUSE OF A FIRE**

Field Contact: CenterPoint Energy Crew Leader David EDBLAD (320) 983 - 6479

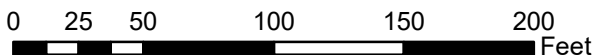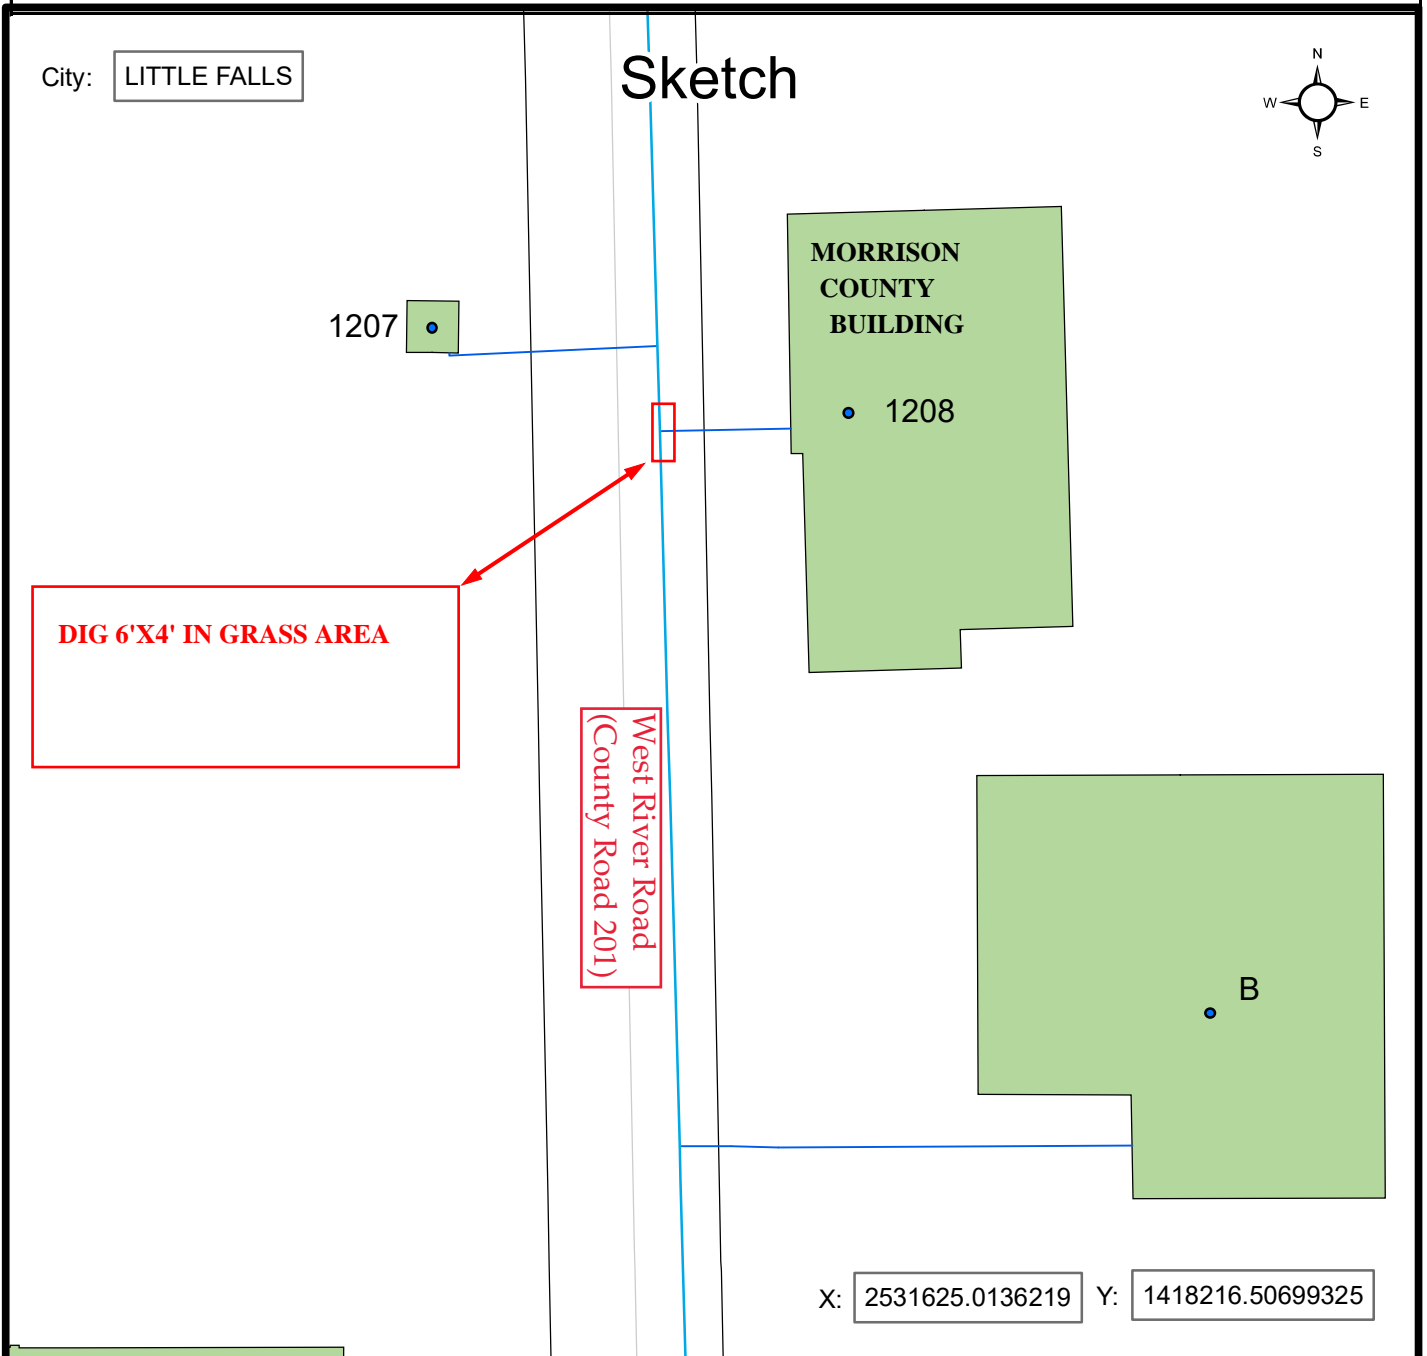

For Informational Use Only