



Gas Operations C&M Completion Form



W.O. #	S000107513701	Completed By	00068995	Date	5/4/2023
Address	11208 HILLTON RD	City	LITTLE FALLS		

Remarks:

ABANDONED SERVICE AT THE MAIN 26' OF C/L OF COUNTY RD 258 SAME AS HILLTON RD. DIG 6'X4' AT THE TEE IN THE GRASS.

SAP# 107513701 MGC# 23-70469

Field Contact: CenterPoint Energy Crew Leader David EDBLAD (320) 983 - 6479

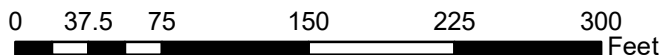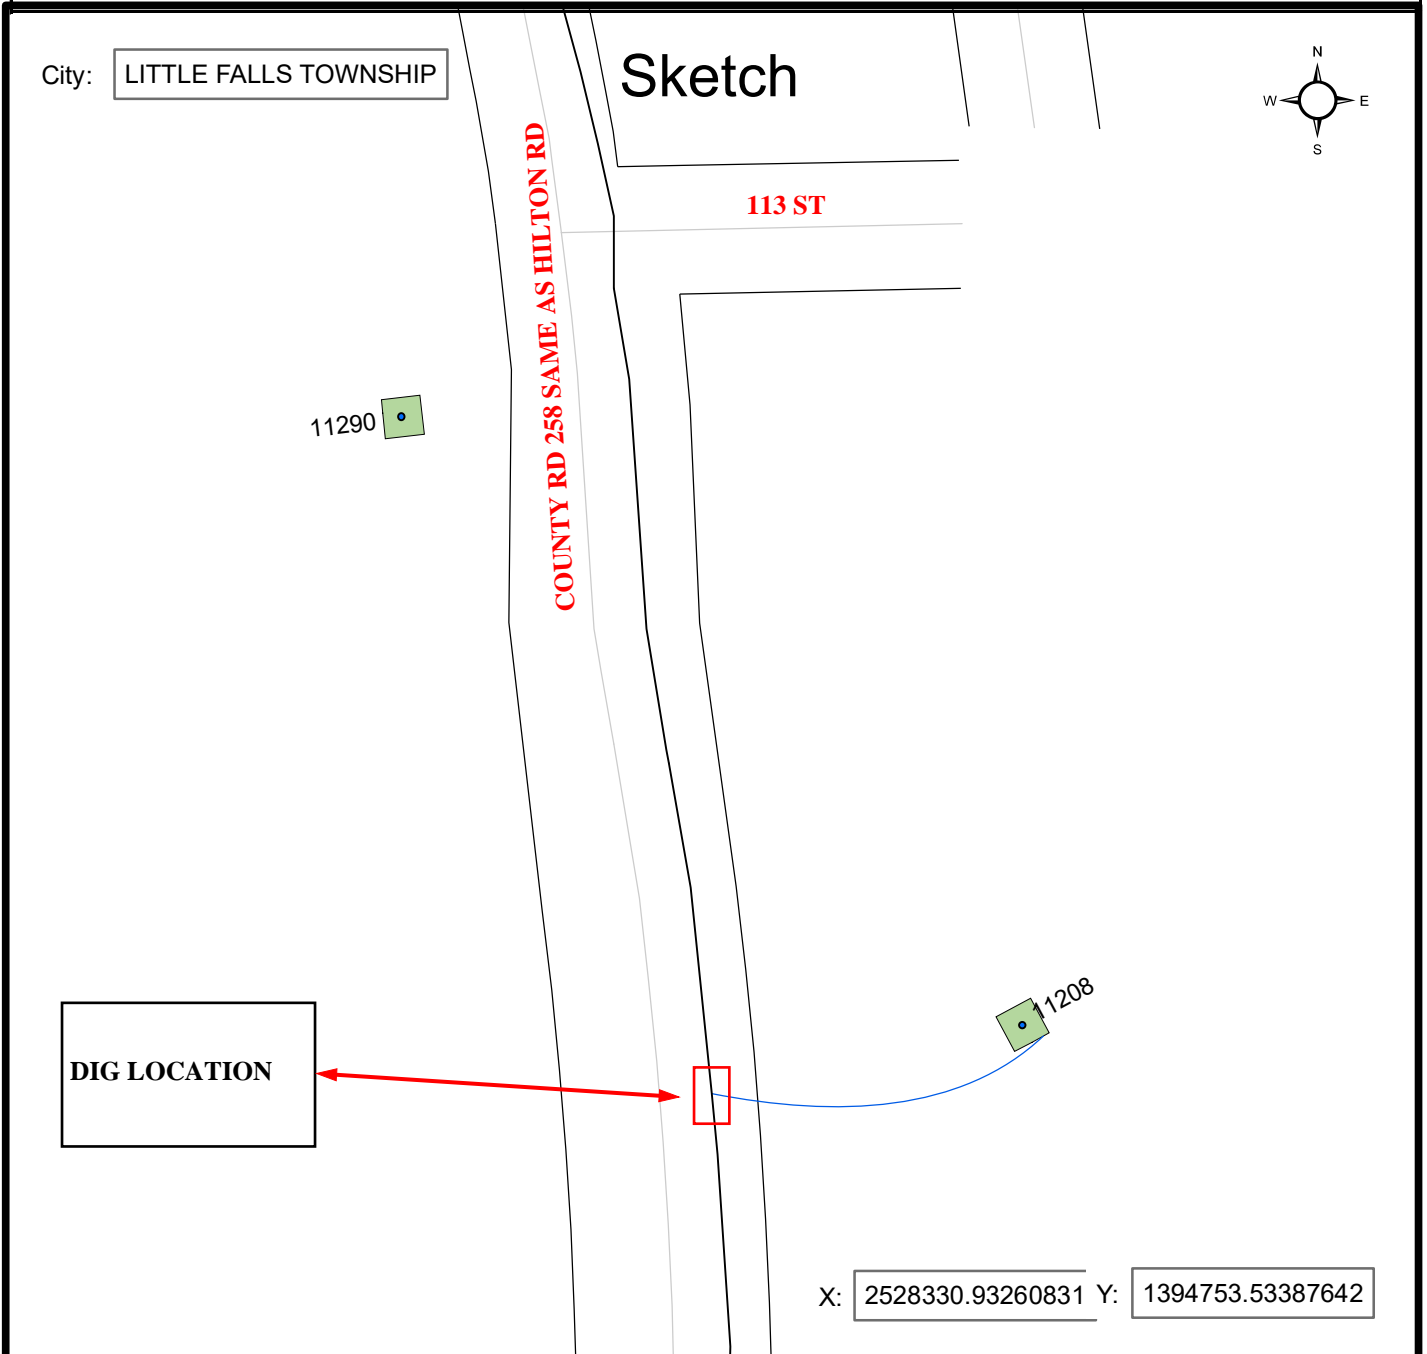

For Informational Use Only