

CenturyLink BSW Order/Maintenance Work Authorization


Company	Exchange Name	PIRZMNXA	Service Order#	
Work Activity	Buried Cable-Metallic	Capital	N	Maintenance
Customer Name	chad poser	Phone#	320-468-6168	
Address	33876 153rd st	One Call Ticket#		
City & Zip	pierz mn			
Location/Directions	head east on 153rd st out of pierz house on northside			
Description of Work or Special Instructions	intercept existing bsw at pit and plow in 110' of 3pr bsw to ped			

EMAIL FOR EXCESS:

Held Order	N	Permit:	N	Bore:	N	CBR#	
Tech Name and Tech #	rob 210			Employee Contact#	2188200338		

Sketch (Include Cntr Line & Pedestal)	Material/Labor Units		Footage/Quantity	Comments
	Description	Notes		
Cntr Line foot	SEB3-22	BSW-3 & plow plcmt	110	
	SEB3-22T	BSW-3 & hand dig plcmt		
Ped#	/3	SEPCUTOVER		
Parish/County	BM83	BSW guard at house		
	XXSEB-GL	Remove temp drop		Footage when temp can't be re-used
Township:	BM61(1.25)SEB	BSW Bore footage		
Section	SEBO PER FT LBR	Fiber & plow plcmt		
Range	SEBO PER FT LBR T	Fiber & hand dig plcmt		
	SEB6-22	BSW-6 & plow plcmt		
	BM2(5/8)(8)	Ground Rod		
	SEBO-COIL	Fiber Coil		Coil excess on Fiber drop add 1 unit
	Permit	Permit		Any placement within the ROW requires a permit

Nearest cross st.		Plat Page		Map#	
-------------------	--	-----------	--	------	--

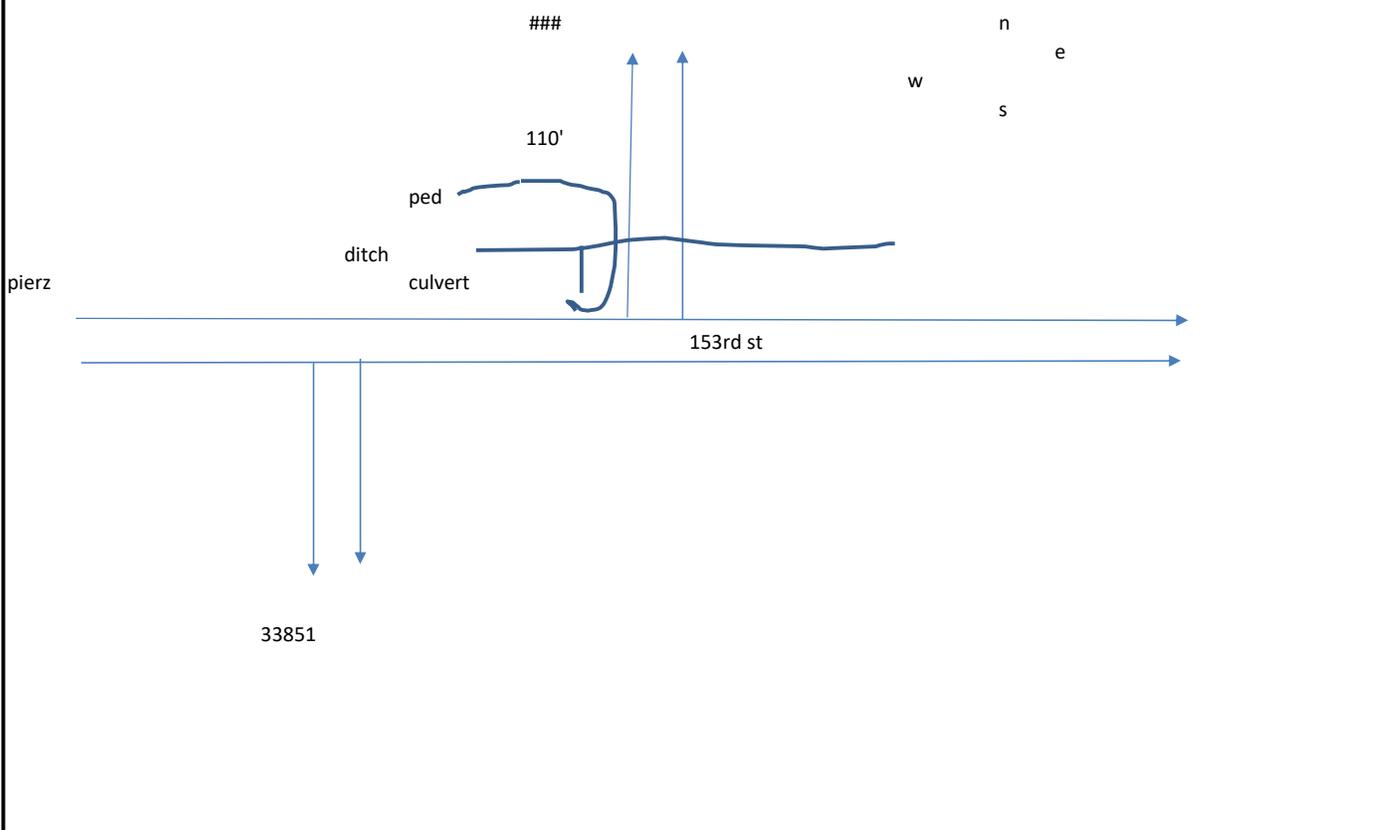

Originated By:	rob a	Date:	6/15/23	Completed By:		Date:	
Authorized By: (SRO)		Date:		Inspected By:		Date:	
Authorized By: (MRO)		Date:					

1. Distance of the bury in Right-of-Way	0	3. Distance to the nearest intersection	
2. Distance from the terminal to the centerline		4. Nearest State Hwy mile marker	na