



Distances from
Centerline

If any Questions
Call Brandon
320-630-4173

son Twsp Rd 15)

75th St (Morrison Cnty Rd 226)

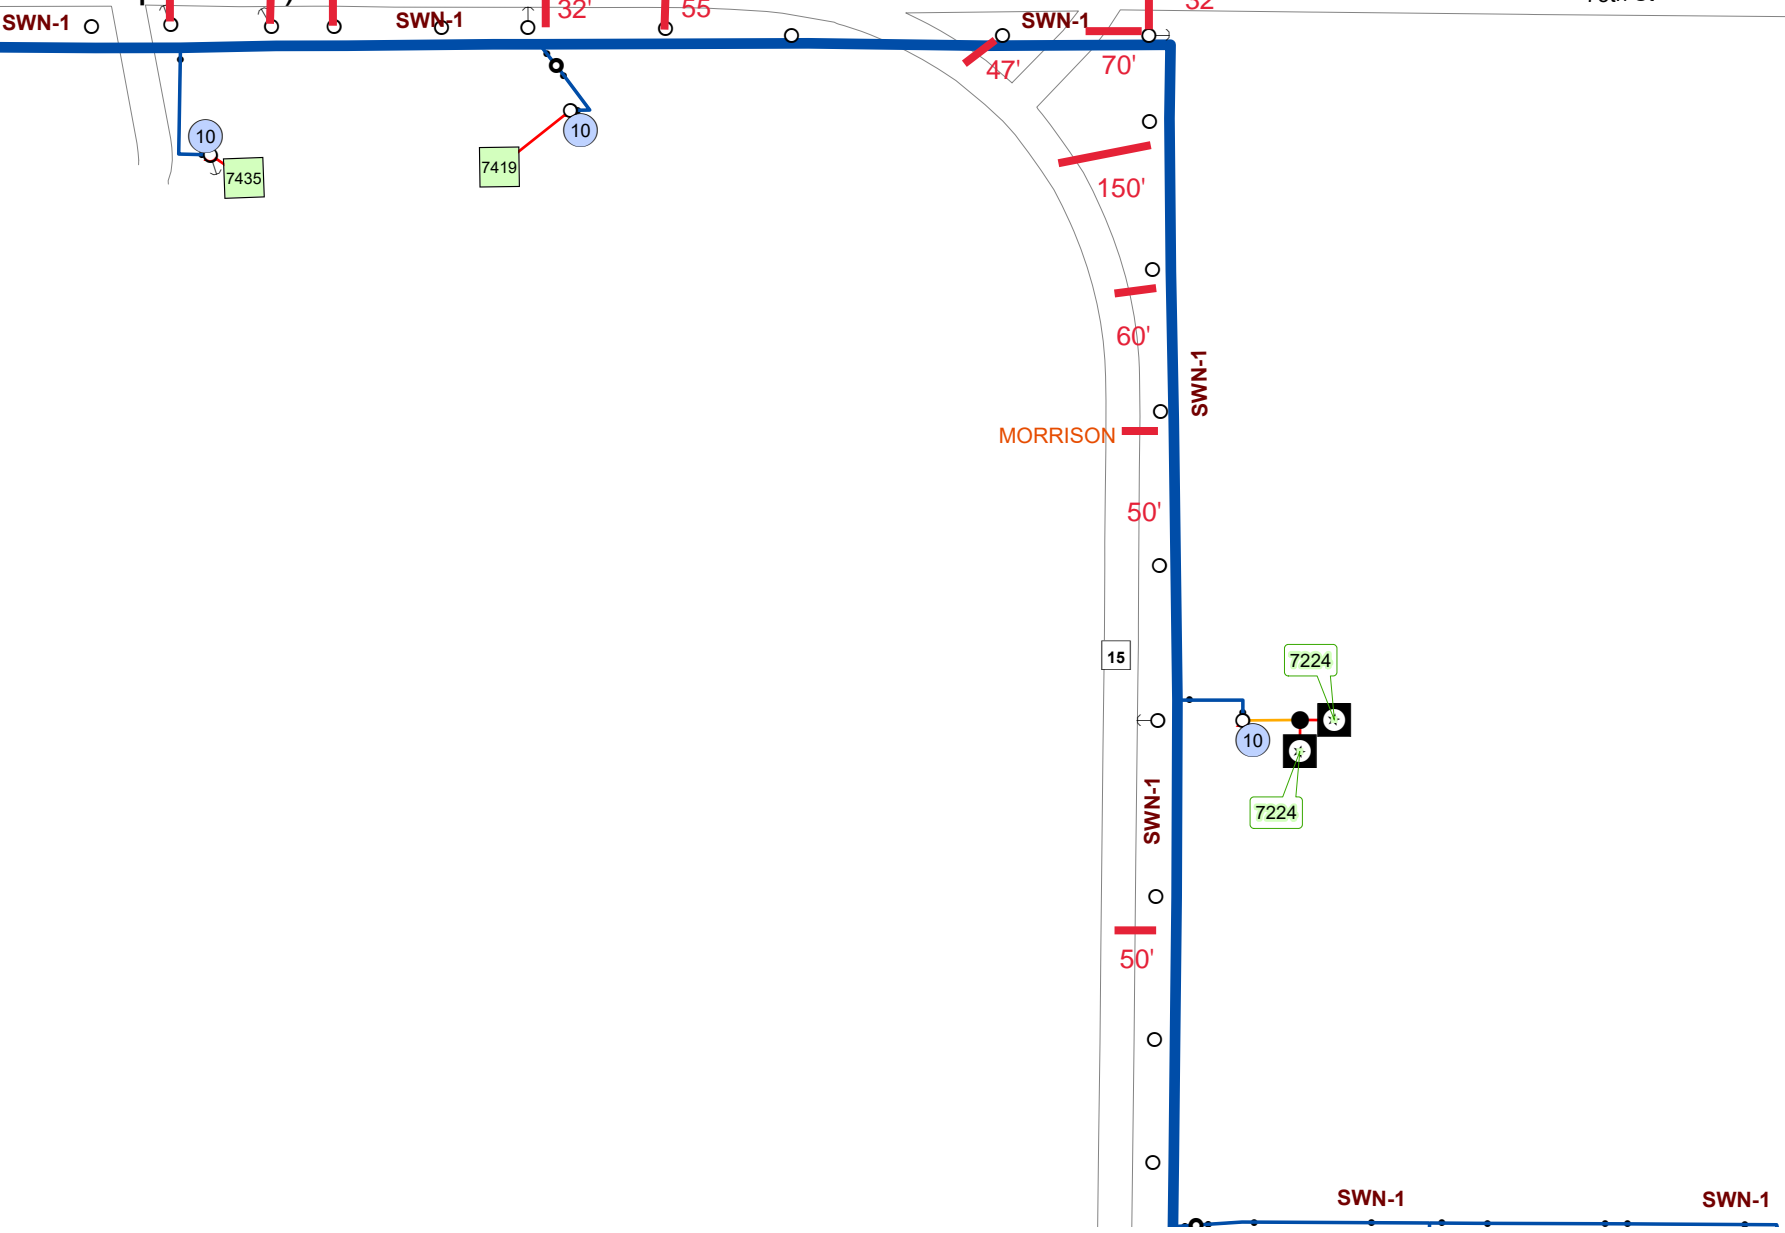

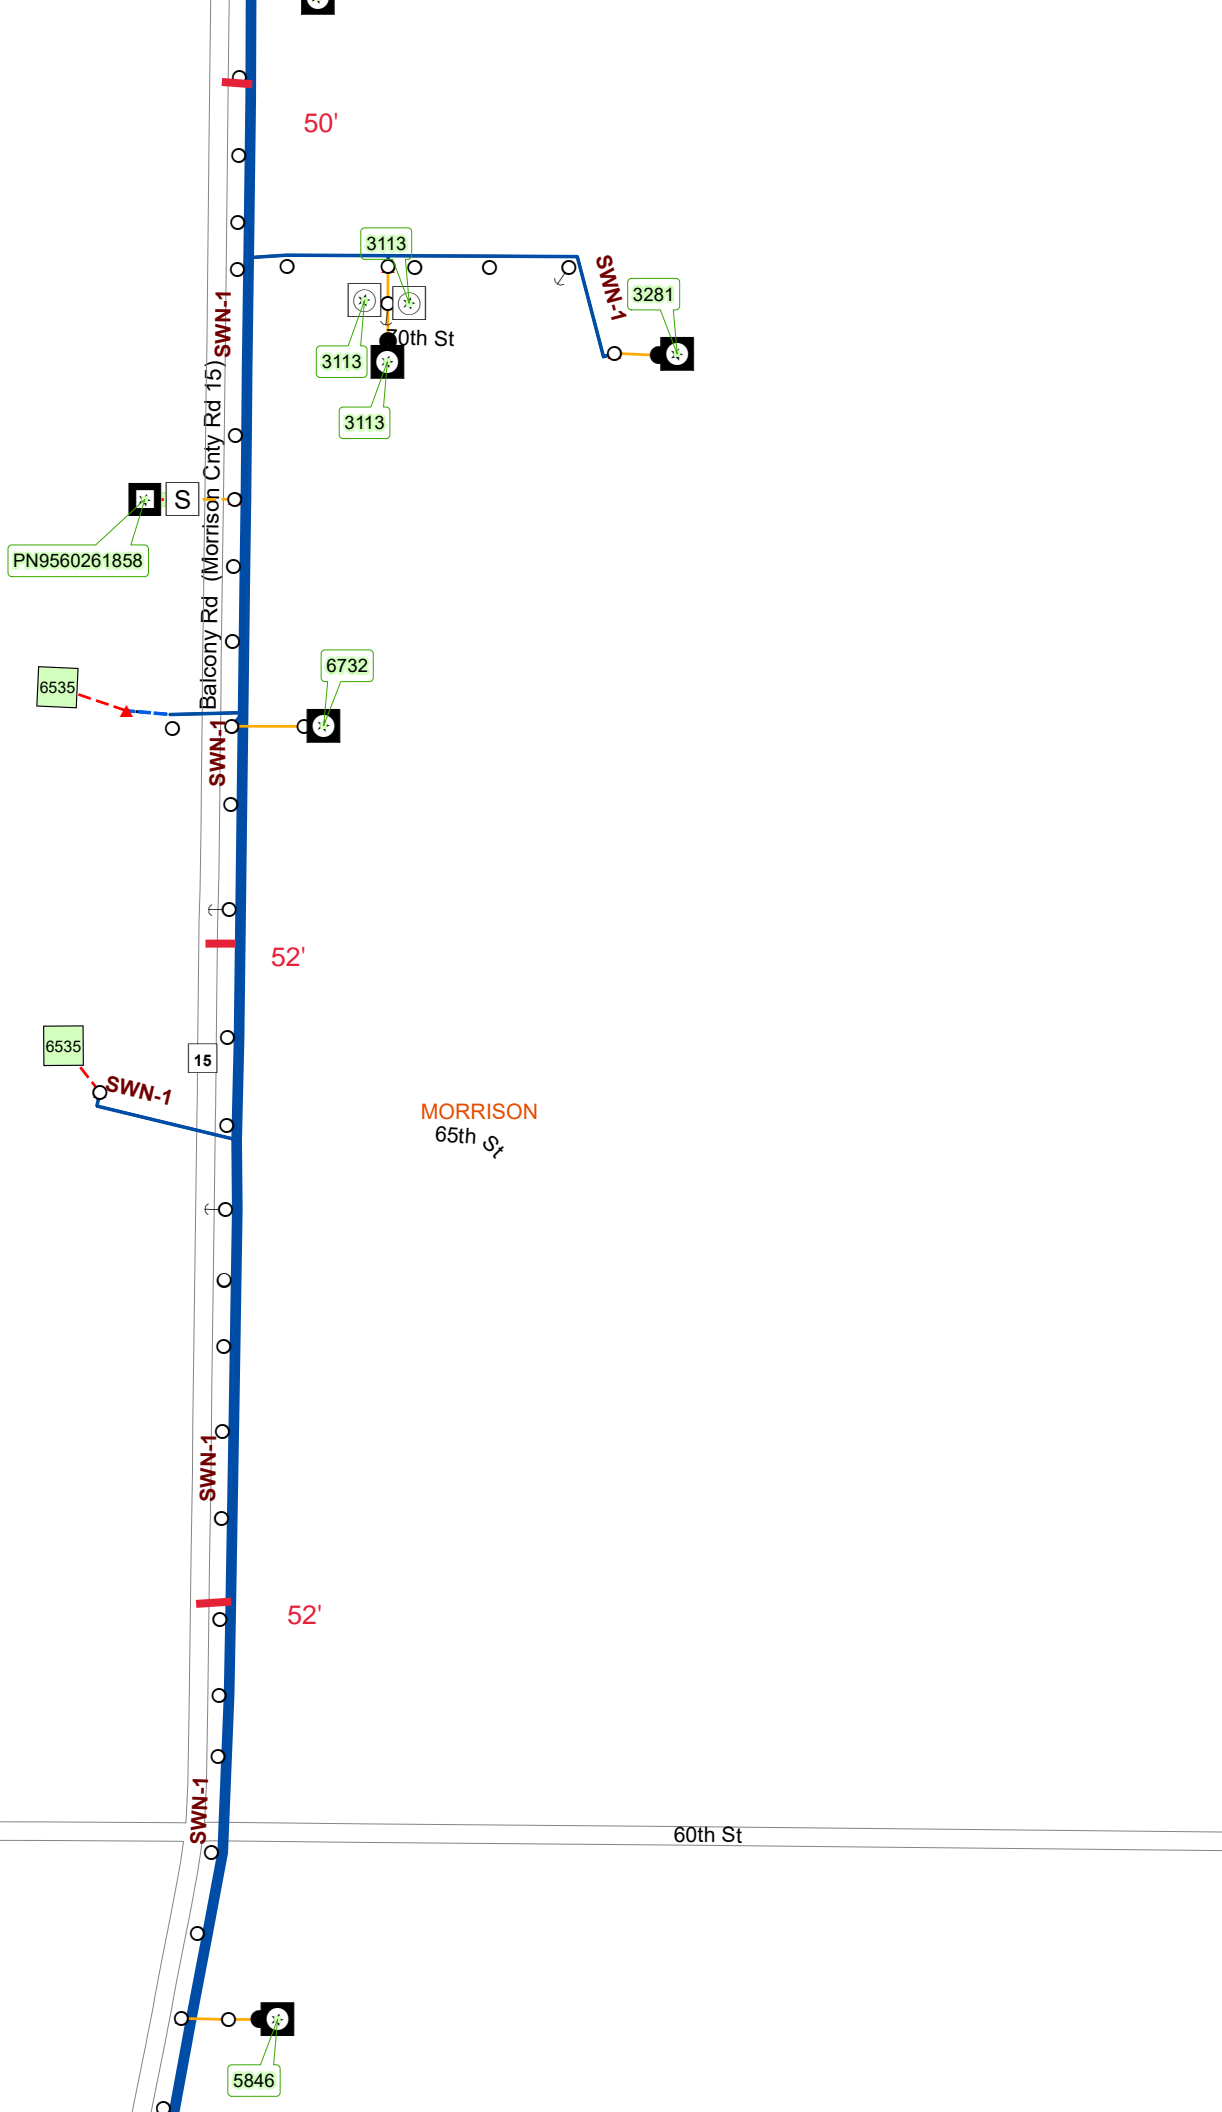

50'

Balcony Rd (Morrison Cnty Rd 15)
SWN-1

3113

3113

3113

60th St

SWN-1

3281

PN9560261858

6535

6732

52'

6535

SWN-1

15

MORRISON
65th St

52'

SWN-1

SWN-1

60th St

5846