


Generator Location

TOWNSHIP WELL

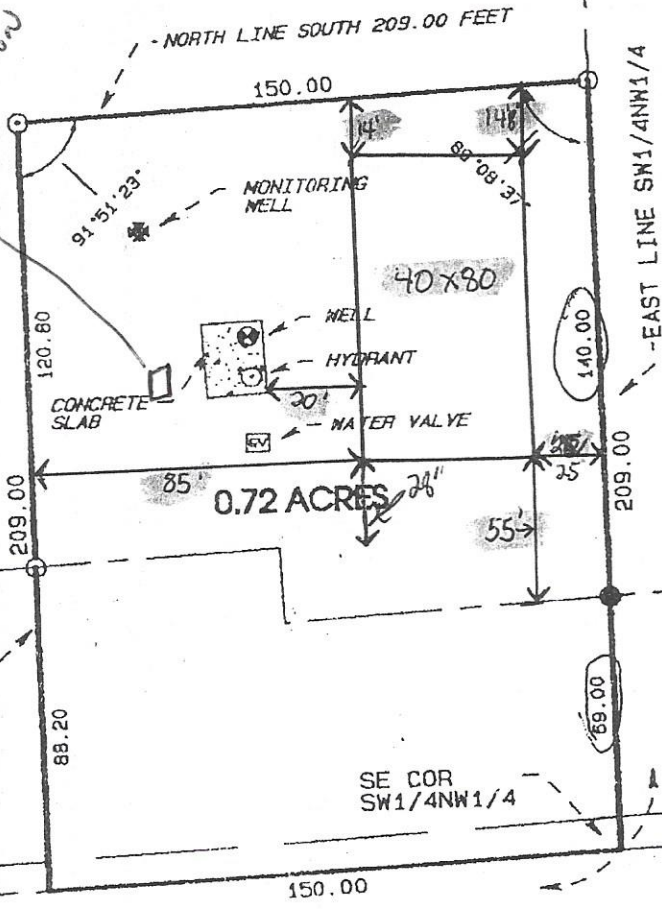

RIGHT OF WAY LINE

WEST LINE EAST 150.00 FEET

CENTERLINE

N87°37'11"E 343.24

SE COR SW1/4NW1/4

NO. 2E

RIGHT OF WAY LINE

521
N00°31'26"W 6

EAST LINE SW1/4NW1/4

209.00

150.00

120.80

209.00

88.20

150.00

0.72 ACRES

40x80

MONITORING WELL

WELL

HYDRANT

WATER VALVE

CONCRETE SLAB

85

20

25

55

140.00

69.00

91°51'23"

NORTH LINE SOUTH 209.00 FEET