


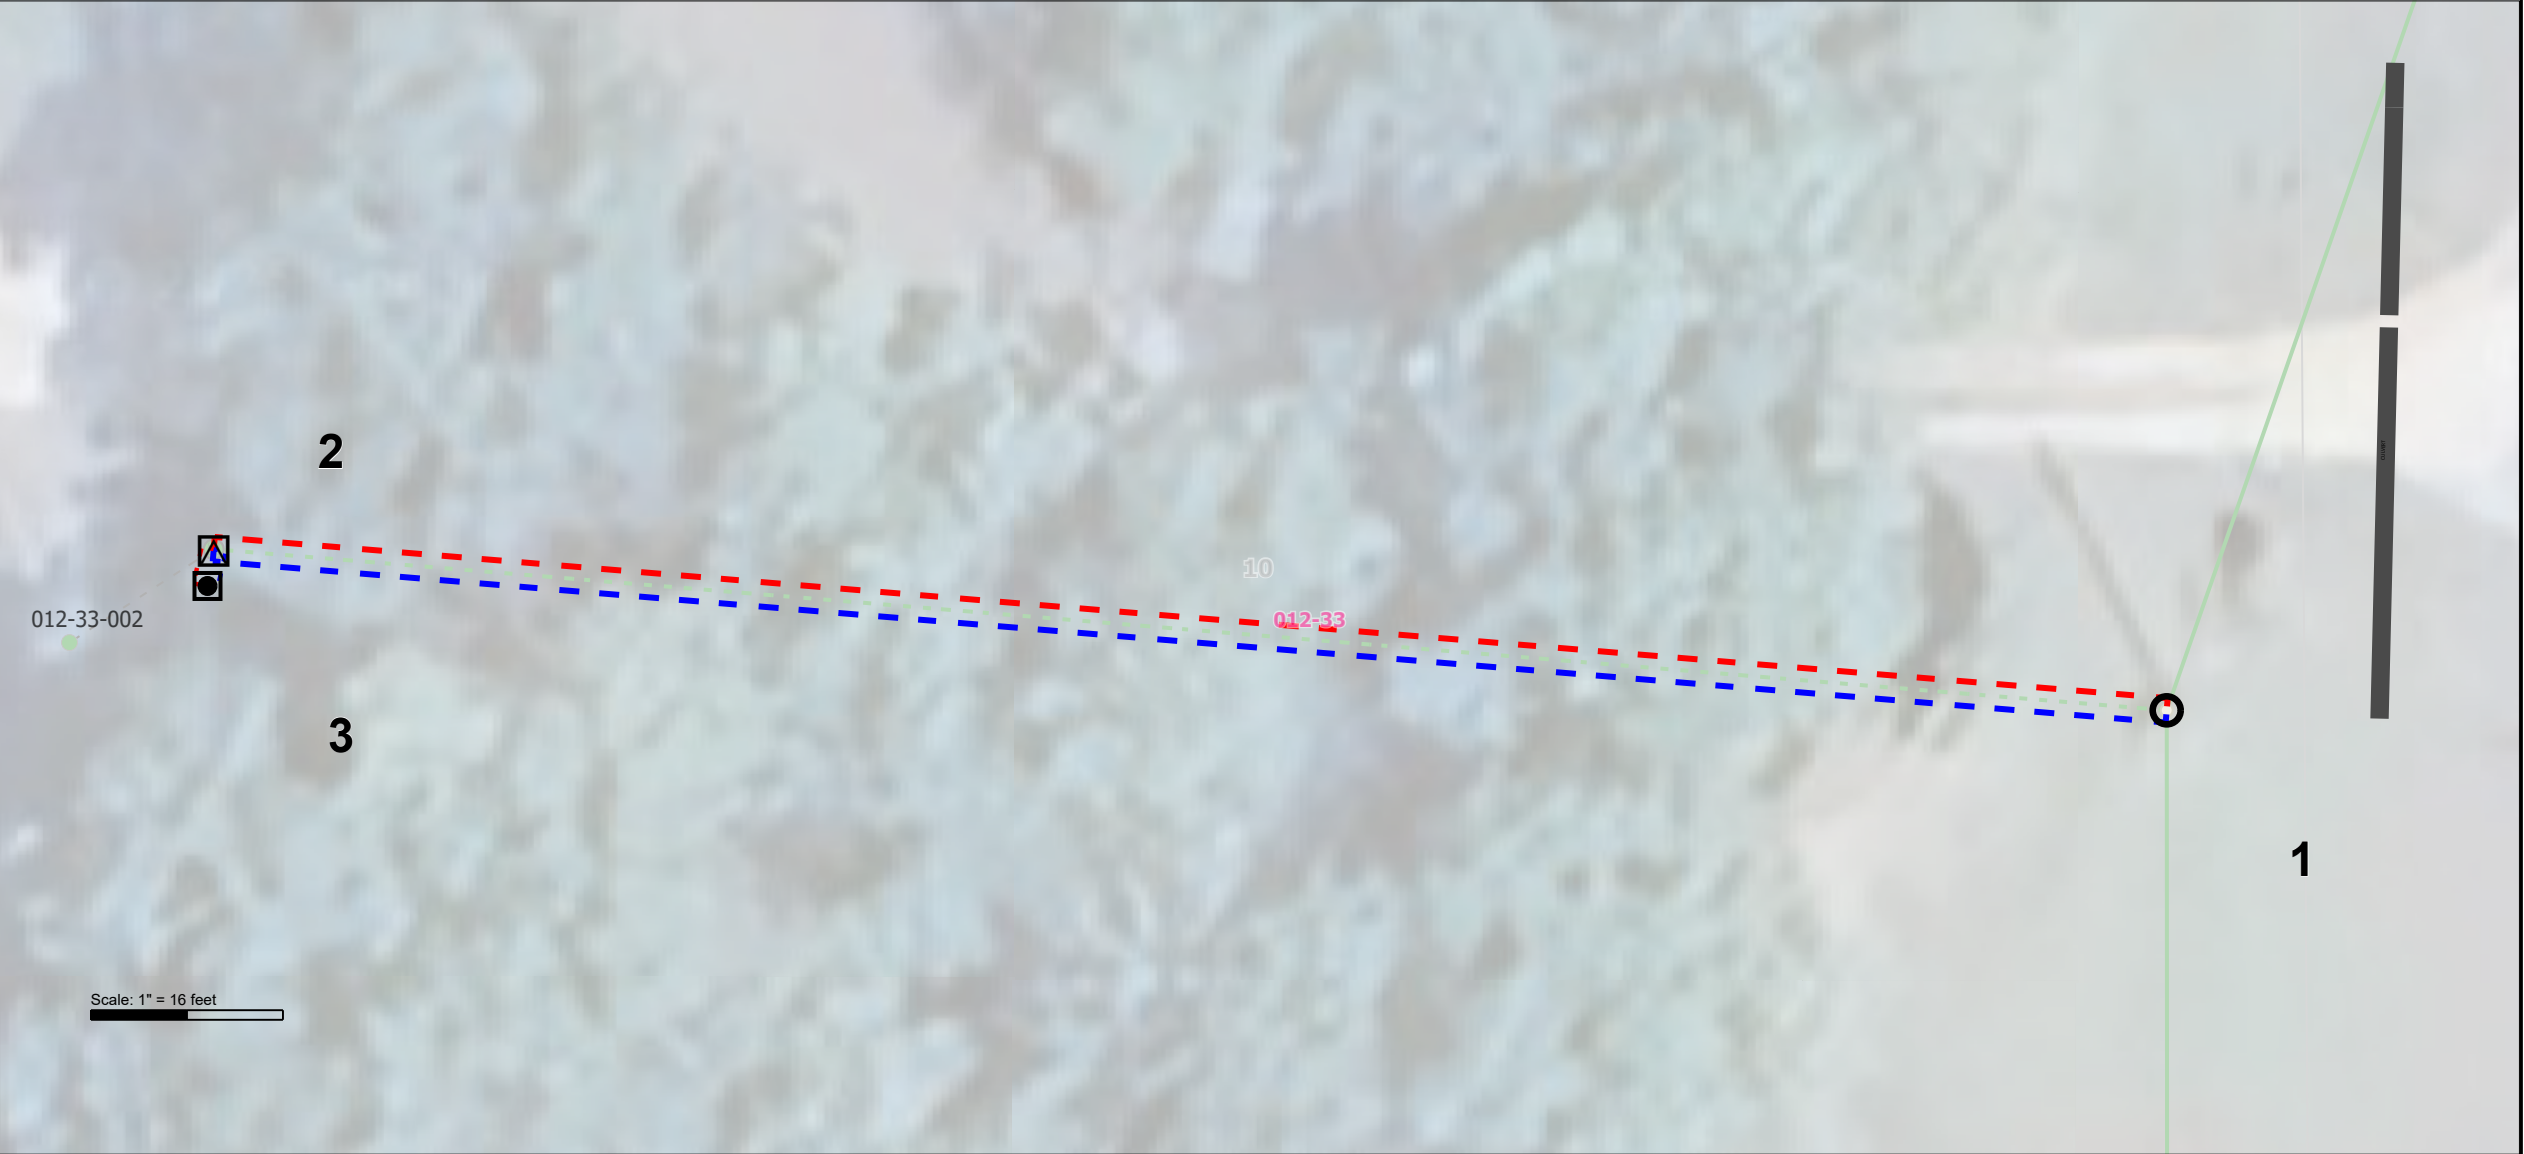

CNTY T-R-S: <u>Morrison T131N R30W S19</u>	PRI-WIRE: <u>1/0 AL</u>	STAKED BY : <u>Levi</u>	NAME: <u>NATHAN LONG</u>	WO#: <u>20250061</u>
SUBDIVISION: _____	RULING SPAN: <u>0</u>	STAKED DATE : <u>1/23/2025</u>	LOCATION: <u>012-33-002</u> SERVICE AREA: <u>SA1</u>	SHEET : <u>2 of 2</u> EXT : <u>1</u>
SERVICE TYPE: <u>Residential</u>	AMPS: _____	WO TYPE: <u>SYSTEM IMPROVEMENT</u>	SERV LOC: <u>48342</u> ACCT: <u>4834211</u>	DESC: <u>Bare Concentric Primary URD Replacemen</u>
PERMIT: _____	VOLTAGE: _____	RUS CODE: <u>608</u>	HOME: <u>320-224-9197</u> MOBILE: _____	SUB: <u>S15 F1 Phase C</u>



Blue – New Status Black – Existing Status Red – Retire Status	Staking Stations ○ Pole 📍 Service Point	... ▢ Padmount Transformer ☑ Primary Cabinet	■ Secondary Pedestal ● URD Point	Staking Span — Overhead - - Underground	
--	--	---	--	--	--