

ADDRESS: ., RANDALL		TITLE: STEARNS ELECTRIC ST JOSEPH		CITY LIMITS: NONE	
DESIGN COMMENTS:					
WCC COLLECTED: ☐ YES ☐ NO WCC INCURRED: ☐ YES ☐ NO					
ELECTRICIAN: _____					
ELECTRICIAN PH: _____					
RELATED WORK ORDERS:					




CNTY T-R-S: Morrison T130N R31W S2
SUBDIVISION: SUB LOCATION: 035-02-SUB15
SERVICE TYPE: _____
PERMIT: _____

PRI-WIRE: _____
RULING SPAN: 0
AMPS: _____
VOLTAGE: _____

STAKED BY : JD
STAKED DATE : 6/19/2025
WO TYPE: RETIREMENT WO REPLACEMENT
RUS CODE: 608

NAME: STEARNS ELECTRIC ST JOSEPH
LOCATION: _____ SERVICE AREA: SA1
SERV LOC: 126575 ACCT: 15
HOME: ()- MOBILE: _____

WO#: 20250380
SHEET : 2 of 2 EXT : 1
DESC: ALTERATION OF SERVICE / NORTH PARKER F4
SUB: S15 F4 Phase ABC

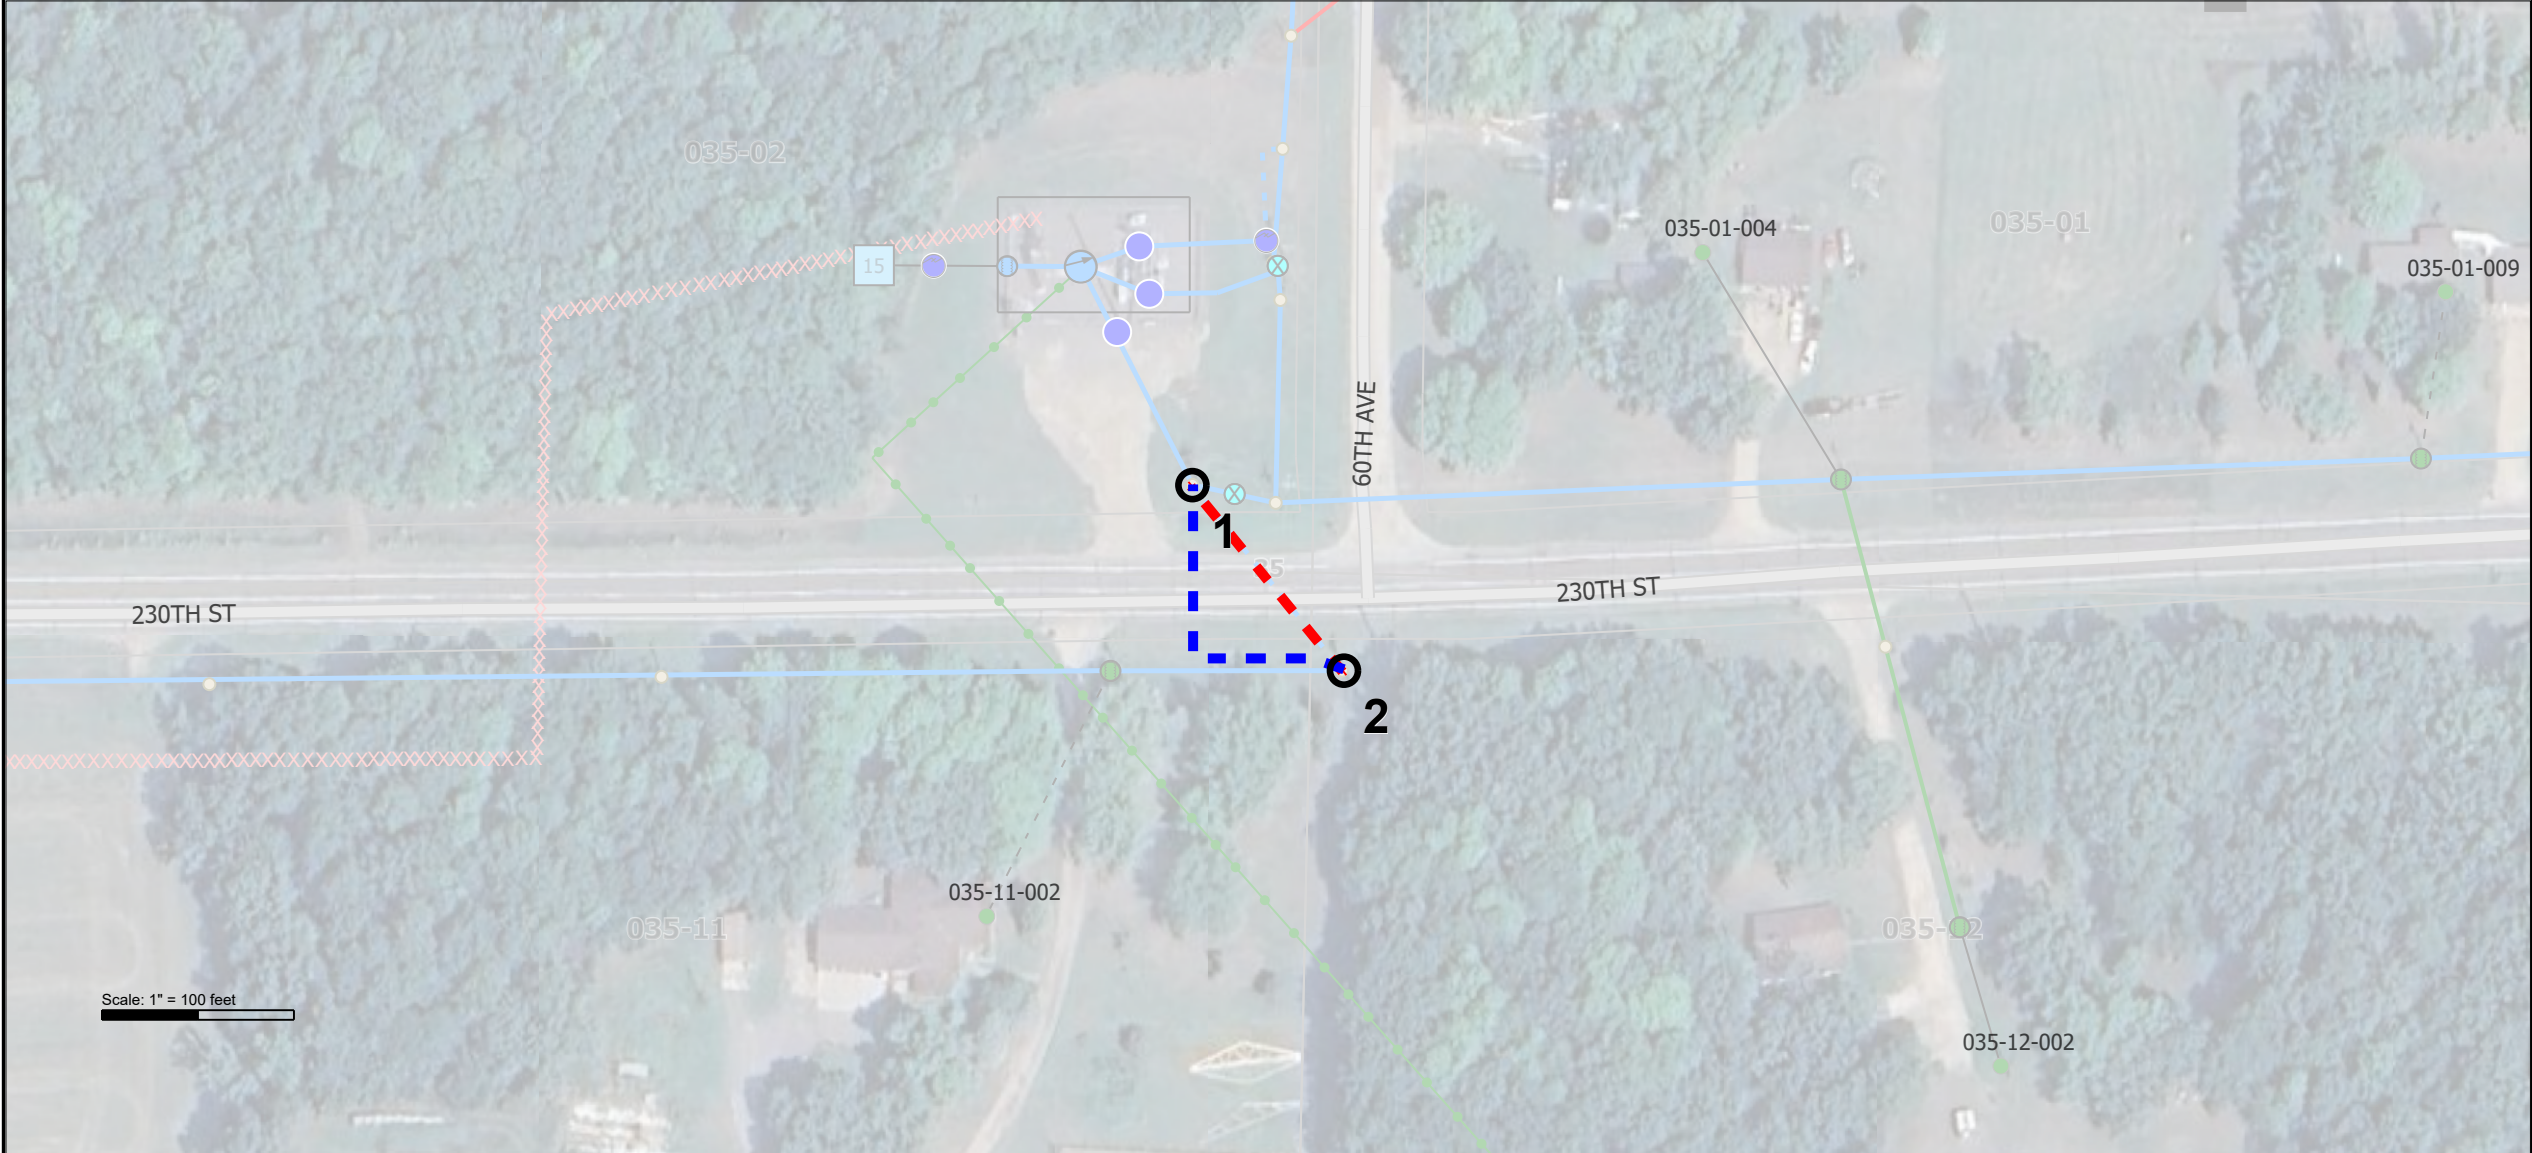

- | | | | |
|-------------------------|-------------------------|----------------------|---------------------|
| Blue - New Status | Staking Stations | ... | Staking Span |
| Black - Existing Status | Pole | Padmount Transformer | Overhead |
| Red - Retire Status | Service Point | Primary Cabinet | Underground |
| | | Secondary Pedestal | |
| | | URD Point | |

