


S:\PROJECTS\CSA\H24\H24.dwg:CSA\H24.dwg, 01/20/2006 02:04:05 PM

P.I. 186+86.65
DELTA 0°09'00" RT.

P.I. 213+44.27

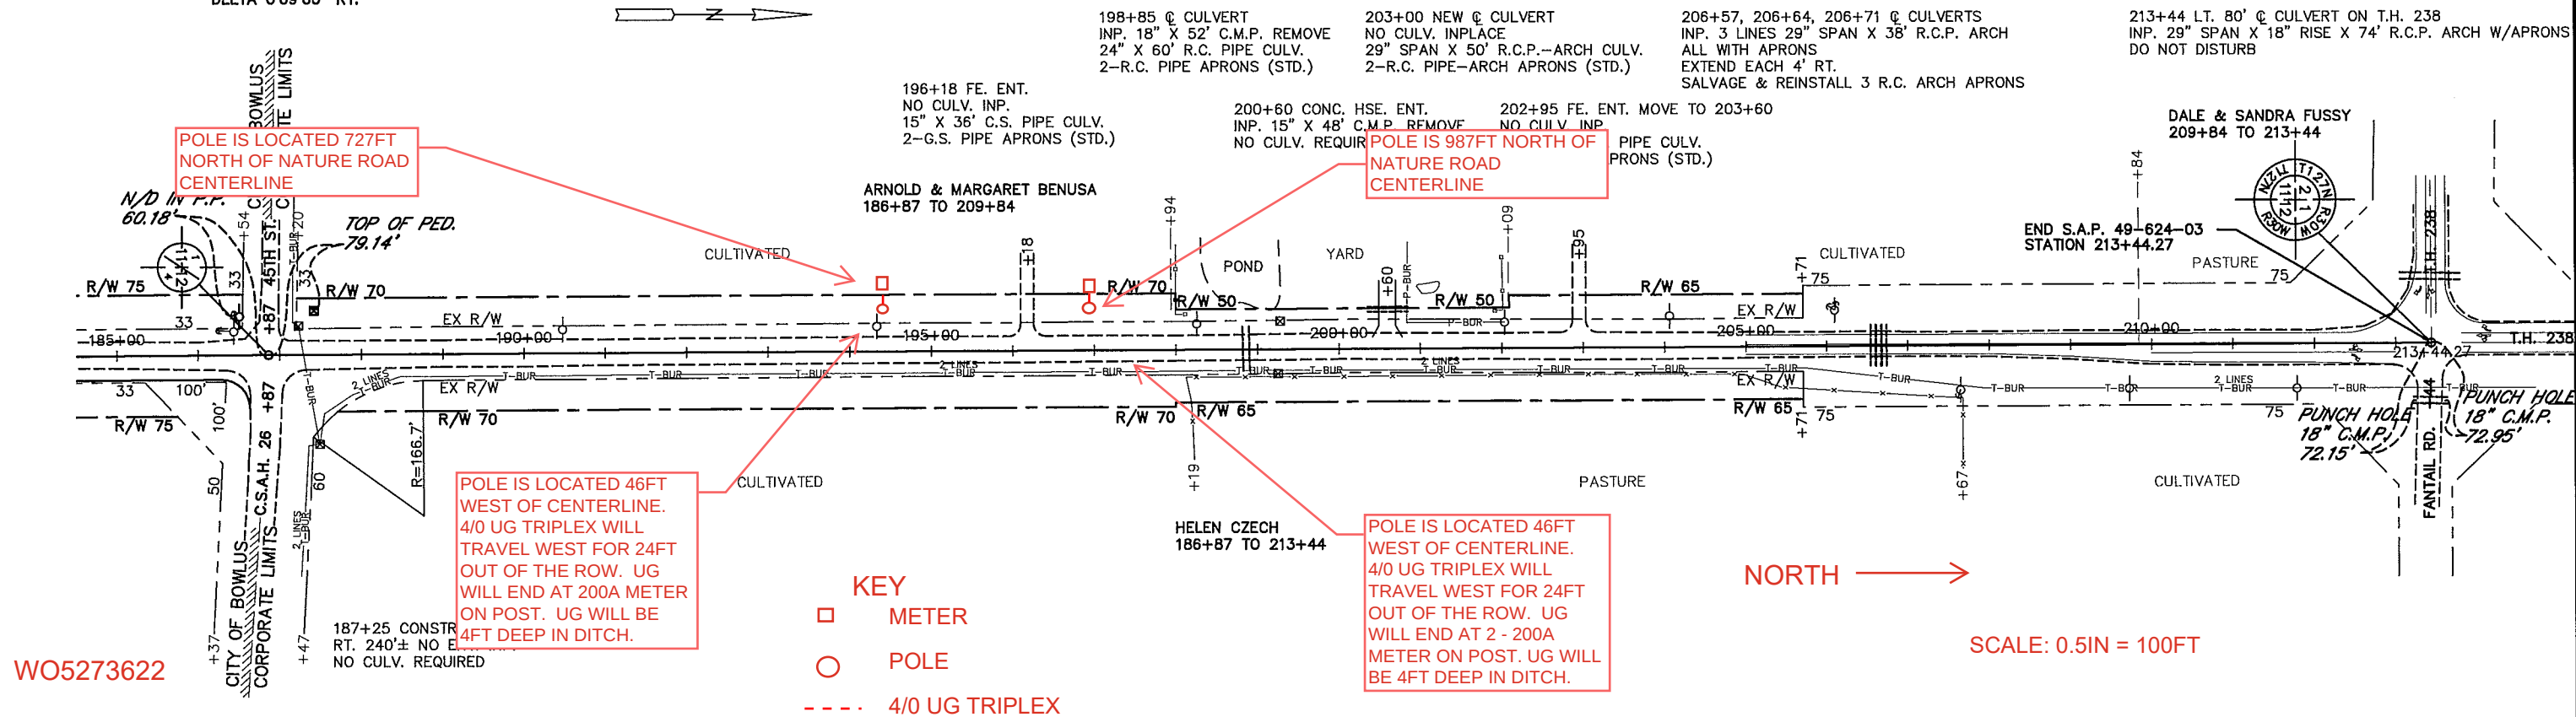


WO5273622

AS BUILT 2004

B.M. ELEV. 1112.54
SPK. IN P.P.
STA. 206+10 LT. 42'

B.M. ELEV. 1117.37
MN/DOT MONUMENT
STA. 213+11 RT. 308'

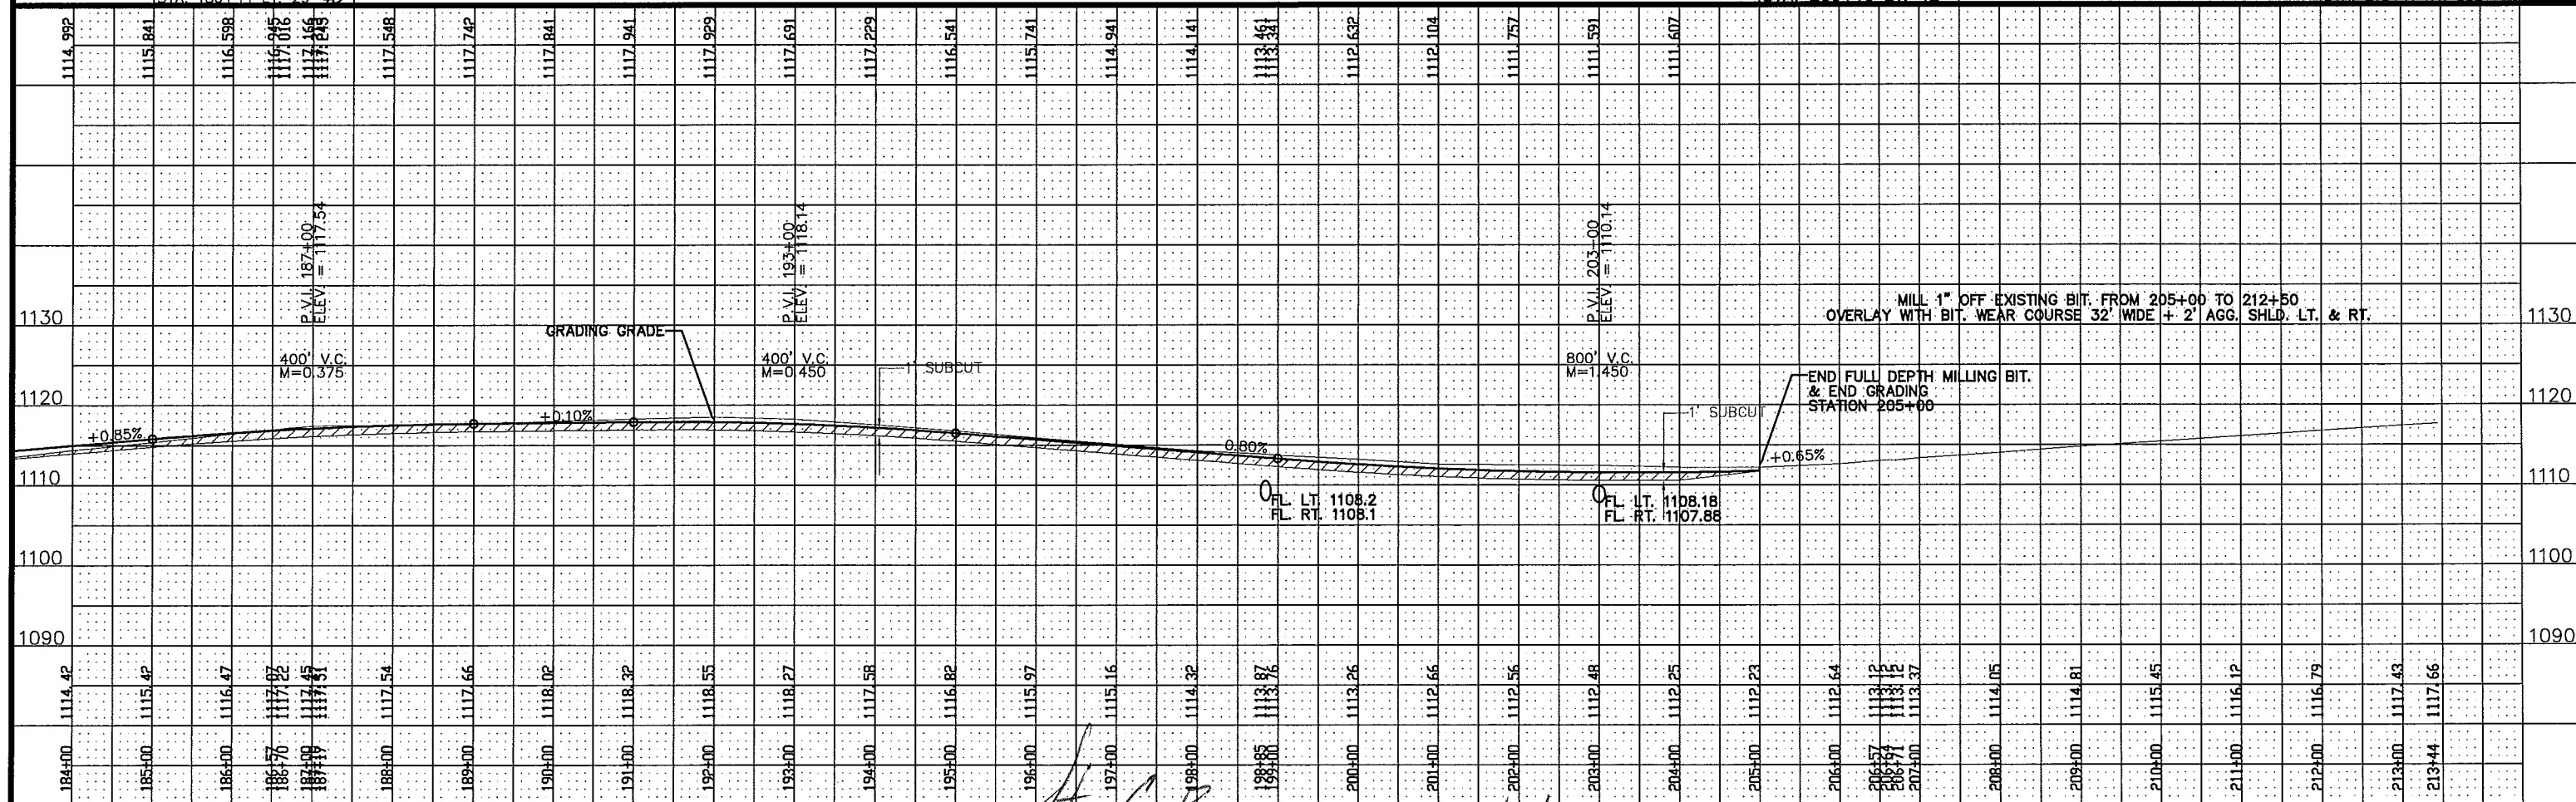

Licensed Professional Engineer

DATE 1/25/06 LICENSE NO. 18286

S.A.P. NO. 49-624-03

SHEET NO. 14 OF 31 SHEETS