


CenturyLink Constant Job Order/Maintenance Work Authorization

Company T600 Exchange Little Falls Service Order# _____
 Work Activity Buired Drop-Copper Capital x Maintenance _____
 Customer Name anderson custom processing Phone# _____
 Address 200 lindbergh dr south One Call Ticket# _____
 Location/Directions _____
 Description of Work or Special Instructions place 6pr bsw from pole to building, term is inside will need pipe and a 90 to get into building.. 110' about 30' of hand digging between fence and garage plplace a splice box on pole or bpost next to it. Cust has 4 lines
 DOR/TOG Yes ___ No ___ Permit: Yes ___ No ___ Bore: Yes ___ No ___ CBR# 3206306221
 Employee Name Craig Cox Employee Contact# _____

Sketch (Include Line & Pedestal)	Material/Labor Units		Est Qty.	Actual Qty.	Placed by (Foreman/Crew Name)
	Description	Notes			
Line	SEB6-22	Place 3 pair BSW	110	110	
Ped#	BM83	BSW Guard	1	1	
County	Cut		1	1	
morrison					
Township	129n	XXSEB-GL	Remove Temp Drop	110'	110
Section	19				
Range	29w	BM61(1.5)D	Underground Bore 1.5"		
GPS Reading					

Nearest cross st. 1st ave Plat Page _____ Map# _____
 Damaged facility # _____
 TOWNSHIP NAME pike creek
 SKETCH

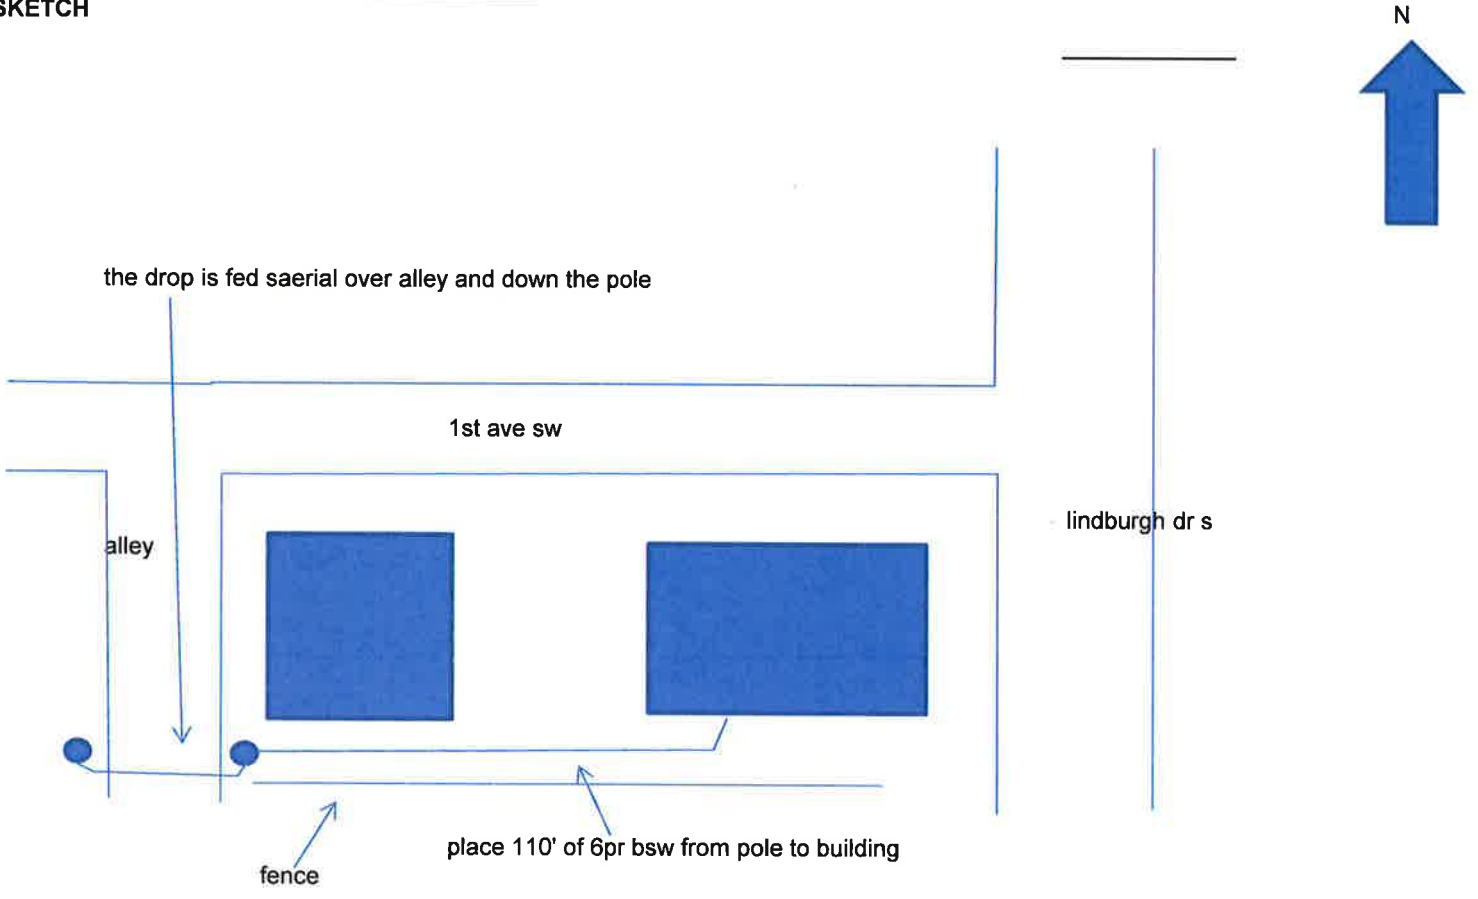

Originated By: craig cox Date: 4/21/15 Completed By: Mark Howard Date: _____
 Authorized By: _____ Date: _____ Inspected By: _____ Date: _____

Inspection notes: _____