


GENERAL LOCATION ONLY. DO NOT USE TO LOCATE FOR EXCAVATION. CALL 1-800-252-1166 FOR ONSITE LOCATIONS AND STAKING.

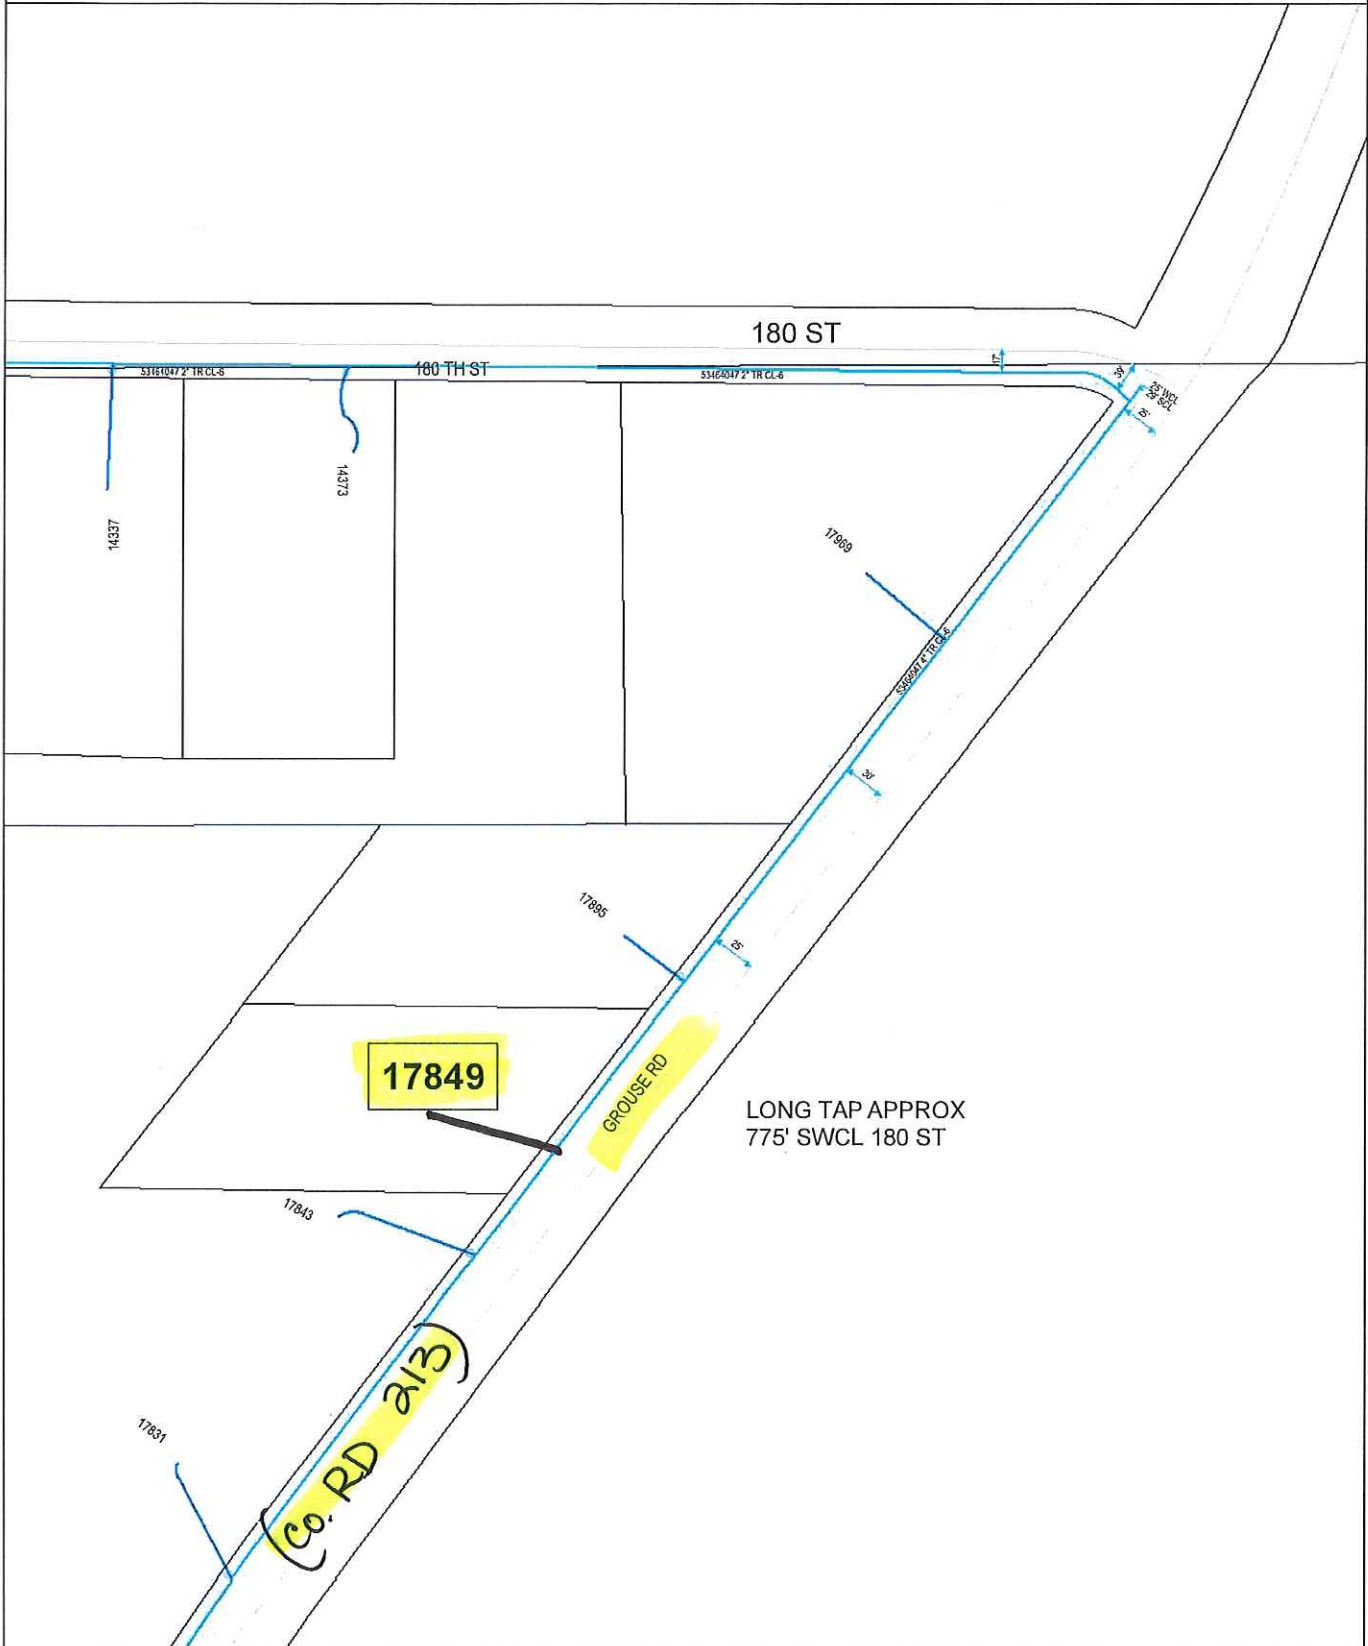

Plotted by: i932427
Plot Date: 10/12/2018

17849 GROUSE RD (COUNTY RD 213)
LITTLE FALLS/MORRISON COUNTY

Scale: 1" : 150'
CenterPoint Energy
North