


Royalton.

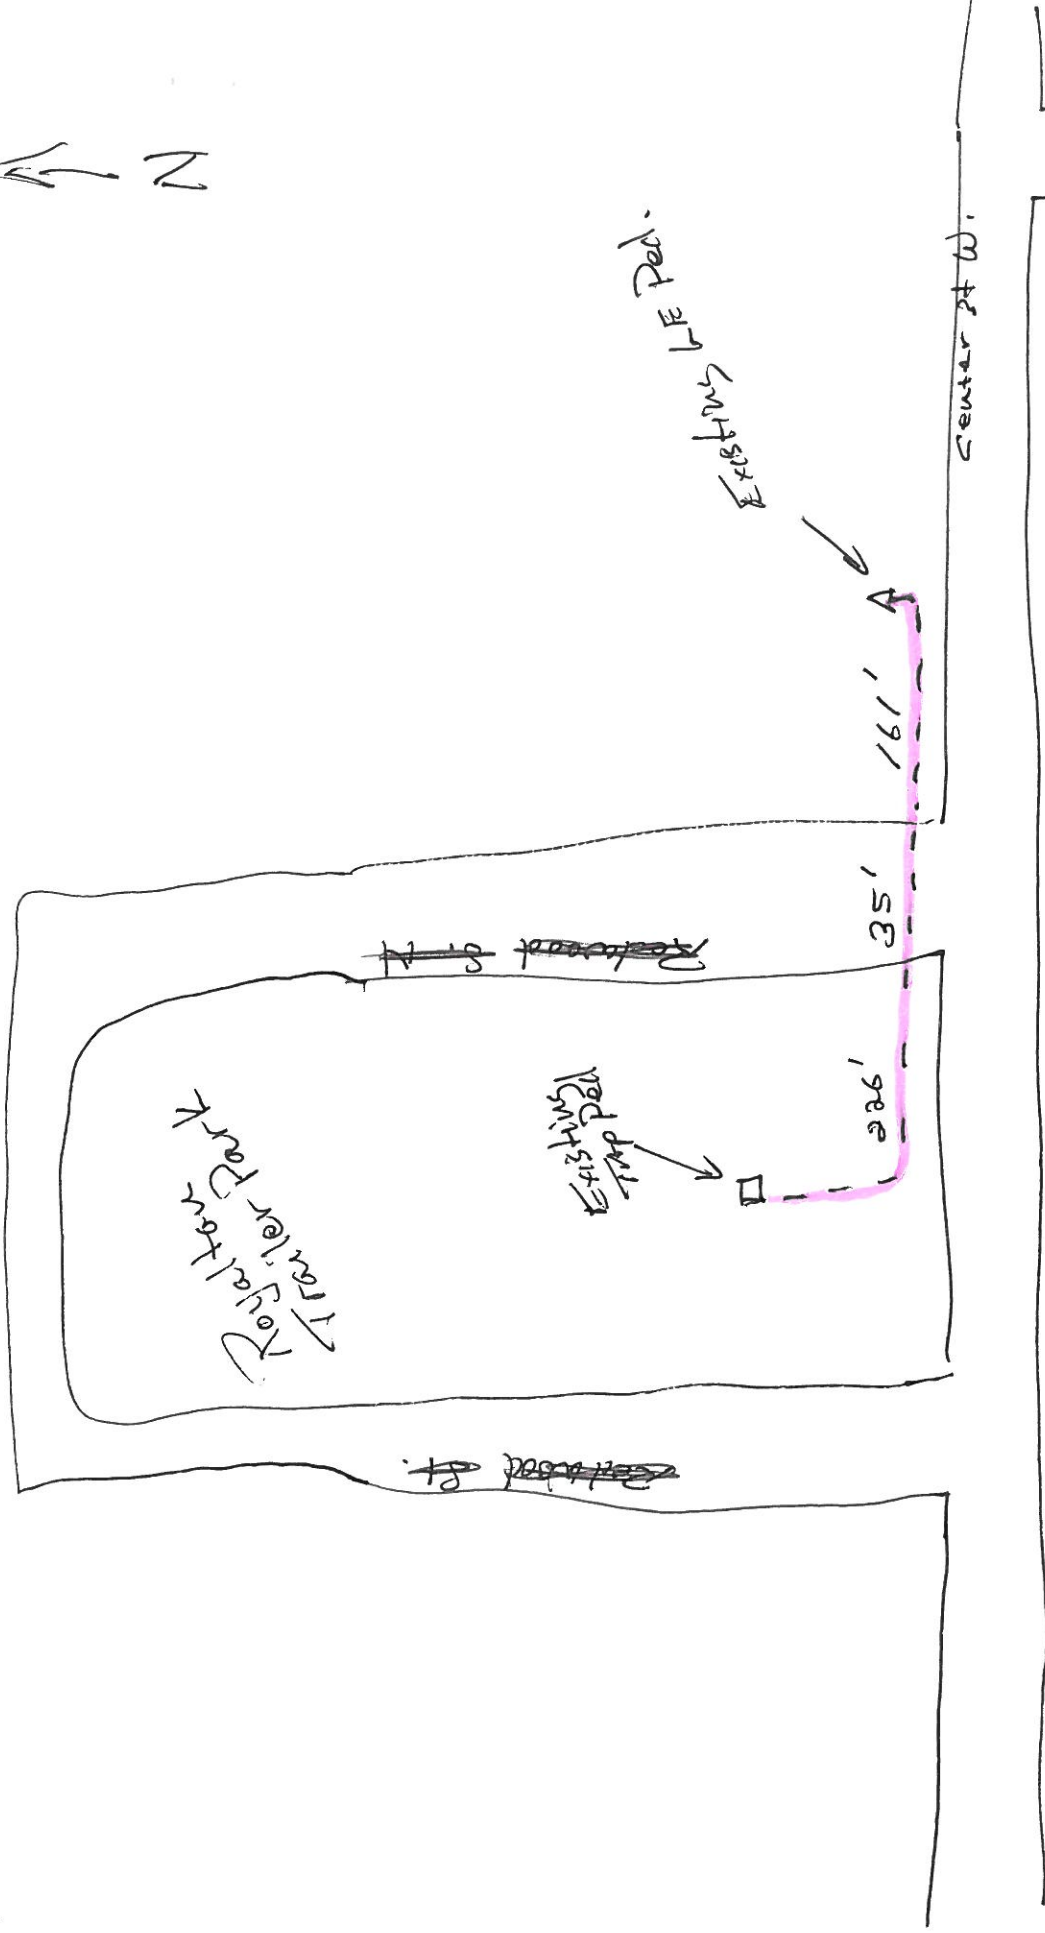

Chestnut St S.

Center St W.

Royalton Trailer Park

Existing Trap Ped.

Existing LE Ped.

161'

35'

226'

~~Chestnut St S.~~

~~Center St W.~~

