


CIC Drop Placement Diagram

Customer Name: ATT cell side Exchange: Fred Lion
 Customer 911 Address: 15713 268th St
 Customer Daytime Phone #: _____ Route/Ped #: FN-7
 Customer Nighttime Phone #: _____ Cell Phone #: _____

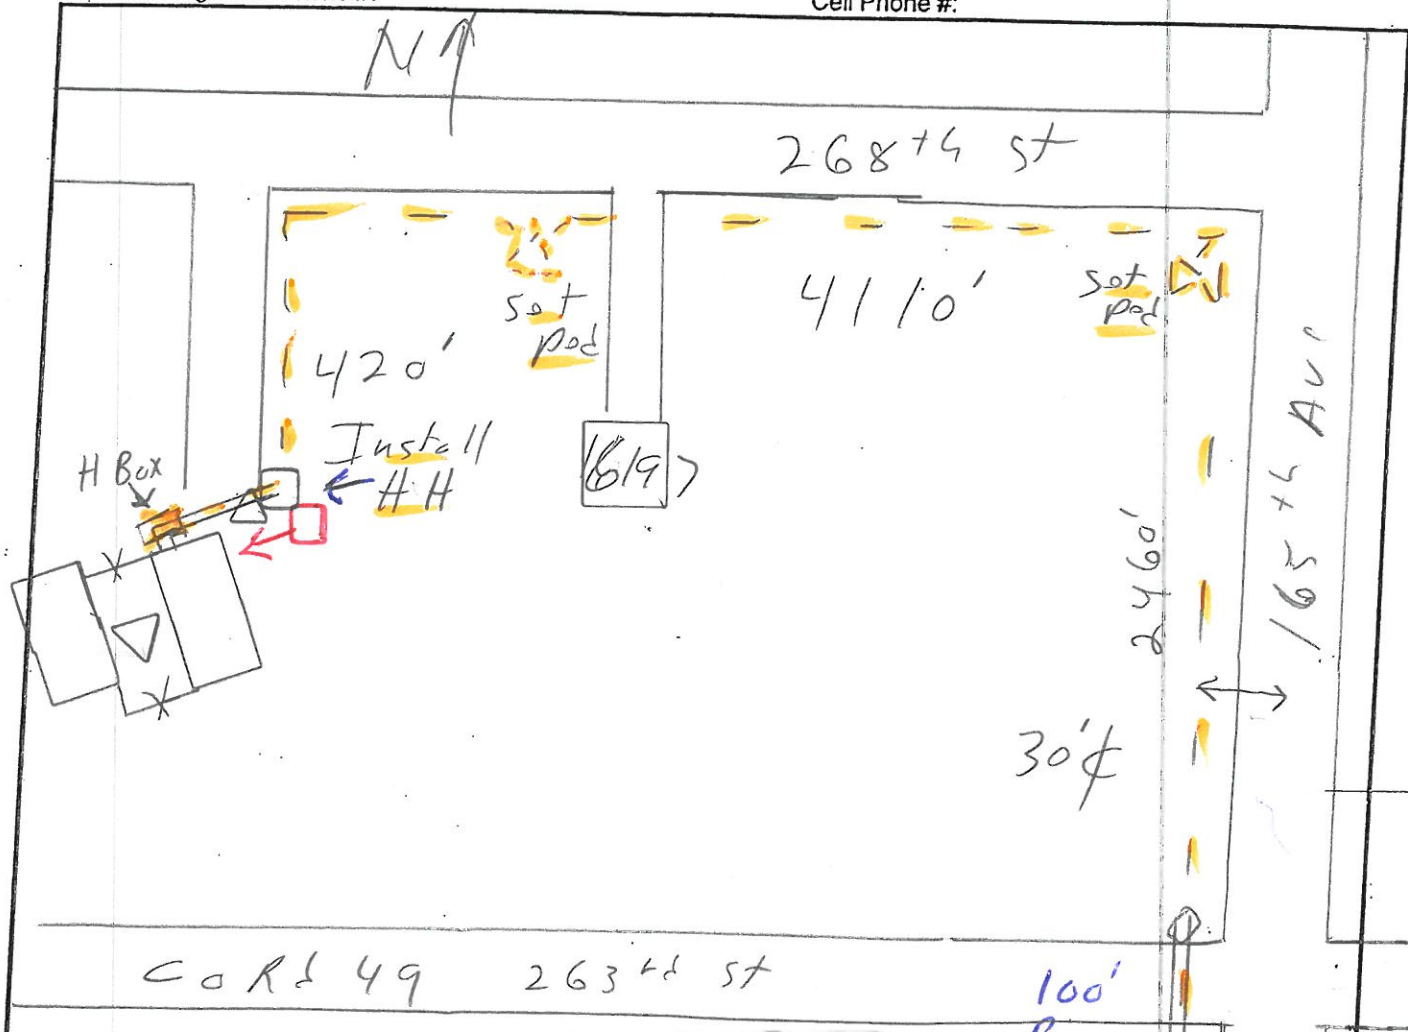

Fractast

Bore 100'
 2460'
 4110'
 420'

 7090'

Pods 2
 Hand Help 1




70-0711-8542-8

515- _____ FN-7
 s, draw details on sketch):

- at Fences?
- ?
- ctrical Lines?
- s or Septic Systems?
- ?
- n?
- es?
- ? How Deep?
- f a coil is required?

22-10

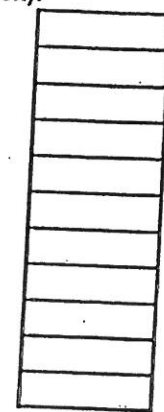

CONTRACTOR CONSTRUCTION WORK ORDER

CTC Exchange: Freedom CTC Phone Number: _____

Customer Name: ATT cell tower

Customer Address: 15713 268th St

Daytime Phone Number: _____ Cell Phone Number: _____

Service Install Date: _____ Cable Pair/Fiber: _____

Description of work to be completed: AFC - RST5 site
North on 165th Ave to cell
site west on 268th St,

* Install Hand Hole by 4" conduit pull Fiber
to H-Box

.....MATERIAL USED.....

Cable Size: _____ Feet: _____ Reel #: _____

Cable Size: _____ Feet: _____ Reel #: _____

Cable Size: _____ Feet: _____ Reel #: _____

Cable Size: _____ Feet: _____ Reel #: _____

Inner-Duct Size: _____ Feet: _____ Reel #: _____

Inner-Duct Size: _____ Feet: _____ Reel #: _____

Pedestal Size: _____ Quantity: _____

Pedestal Size: _____ Quantity: _____

Pedestal Pole or Stake: _____ Quantity: _____

.....

Project Staked By: RV Date: 9-22-00

Engineer Approval By: _____ Date: _____

Construction Completed By: _____ Date: _____