

MORRISON COUNTY PUBLIC WORKS DEPARTMENT PERMIT APPLICATION FOR WORK ON COUNTY HIGHWAY RIGHT OF WAY

PERMIT FEE: \$25.00

DESCRIPTION OF WORK: (be specific) The Proposed Route would start at the Crow Wing and Morrison County line Heading South 12.15 Miles or 64,152 feet on the West and East side of the Road, ending at the intersection of CSAH #8 and CSAH #39, Including 41 Road crossings. Also Crossing at Soo Line Recreational Trail (print attached)

Work to start on or after April 1st, 2011 and completed on or before Dec. 31st, 2011

CSAH/CO. RD. NUMBER: CSAH #8

LOCATION: 12.15 miles South of Crow Wing and Morrison Cty Line on the East & West side of the road

APPLICANT'S NAME: Consolidated Telecommunications Company (Steve Gilbert)

ADDRESS: 1102 Madison Street, Brainerd, MN 56401

PHONE NUMBER: (218)454-1234

CONTRACTOR'S NAME: _____ PHONE: _____

In accordance with the application herein, a Permit is granted for work within county right-of-way at the location described above and in such manner as may be specified by the Public Works Department.

SPECIFICATION:
"See Attached"

Before any work is done the Applicant shall furnish a deposit in favor of the County Treasurer of Morrison County in the amount of \$ _____. Deposit, less cost of any repair by County, will be returned upon acceptance of work by County Engineer.

Applicant Signature Date: _____

=====

Do Not Write Below This Line:

Check Number: _____ (\$25 Permit Fee plus Deposit)

Check Number: _____ (Deposit)

Check Number: _____ (\$30 Right of Way Registration Fee, if applicable)

Date Permit Approved: _____ Date Work Approved: _____

Deposit returned Warrant # _____ Amount: \$ _____

County Highway Engineer: _____

SPECIAL PROVISIONS

MORRISON COUNTY PUBLIC WORKS

The Applicant agrees to the following conditions covering the construction work:

1. The Applicant shall assume all liability for, and save the County, its agents and employees harmless from any and all claims for damages, actions or causes of action arising out of the work to be done and the continuing uses by the Applicant, including but not limited to the placing, constructing, maintaining and using of said utility under this application and permit.
2. Said work shall be completed in conformity with all applicable laws, regulations and codes covering said work. All installation/construction shall be made in conformity with regulations of governmental agencies for the protection of the public.
3. Wherever topsoil and sod are disturbed they shall be replaced and maintained until the turf is established.
4. The said construction and/or installation shall not interfere with any existing utility facilities on the county highway right-of-way.
5. Necessary barricades, warning devices and flagman shall be provided by the Applicant during all phases of their construction and maintenance operations on county highway right-of-way.
6. Upon completion of installation/construction, the Applicant shall restore the county highway right-of-way to its original condition, the Applicant shall then notify the office of the County Highway Engineer of the completion of the work so that inspection can be made to determine its acceptability.
7. Damage resulting from the installation/construction described shall be paid for in its entirety by the Applicant.
8. Notice to the Public Works Department that the work shall take place shall be at least 24 hours.
9. Applicant is responsible for contacting Gopher State One Call for utility locates before they began work.
10. All underground facilities must be Registered with Gopher State One Call before deposit will be returned. (Forms available at Public Works – no charge to get Registered)
11. The Morrison County Ordinance for the Management of Public Right of Way states that all underground facilities within county right-of-way be Registered with Morrison County (Forms available at Public Works - \$30 Registration Fee) All after the fact Right of Way Registration/Permit fees for Morrison County are doubled.

*Morrison County Public Works Department
213 First Avenue Southeast
Little Falls MN 56345*


Phone: 320-632-0121

55'



R 28 W

To Pine Centre

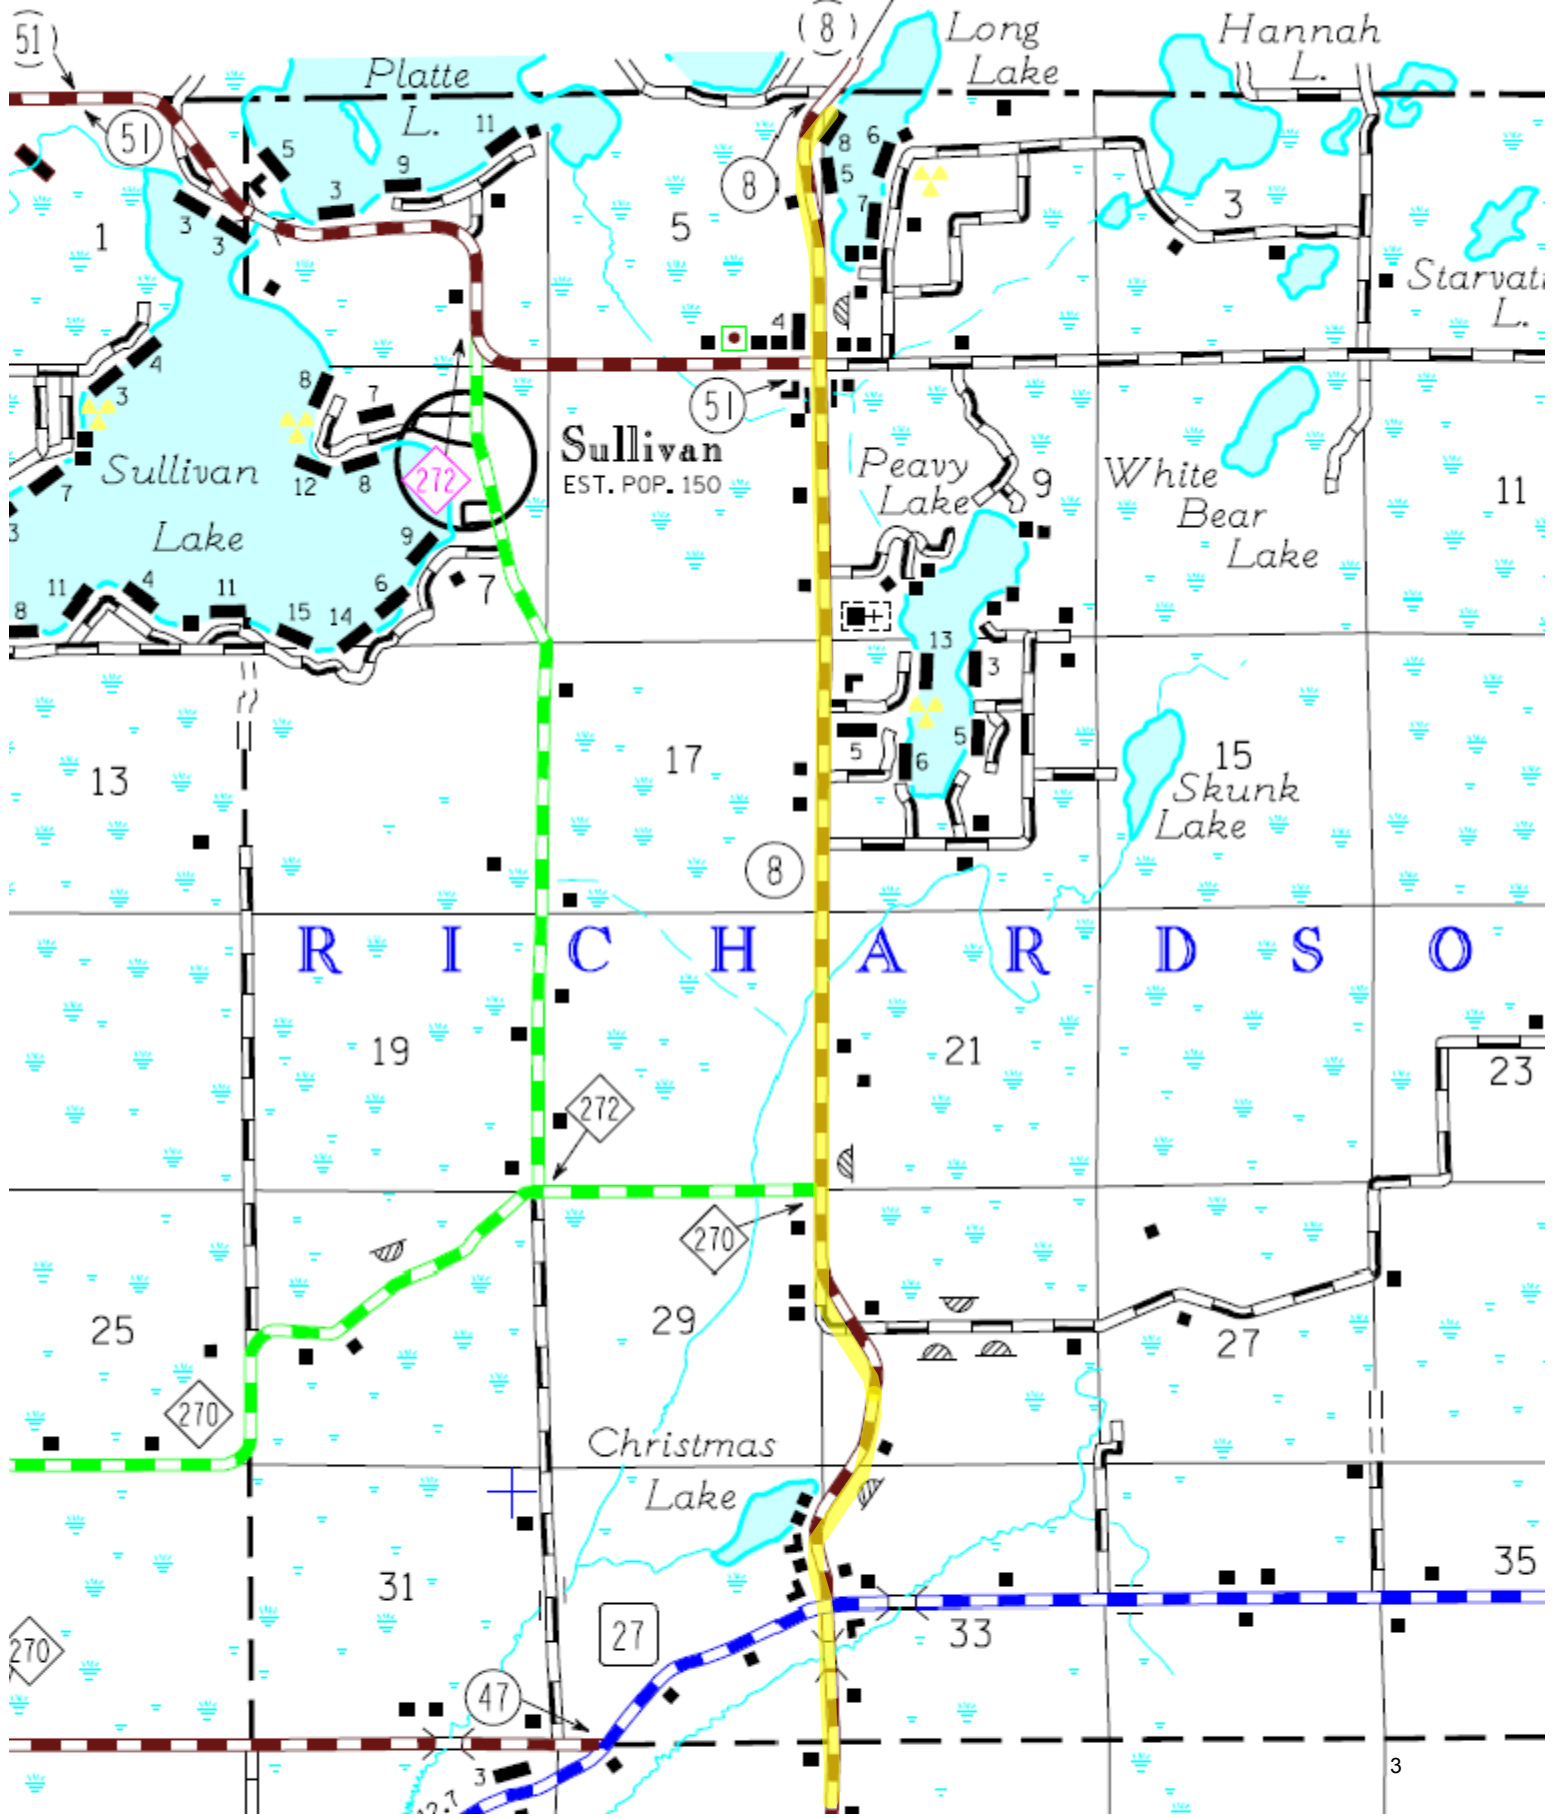

Platte L. Long Lake Hannah L. Starvati L. Sullivan Lake Peavy Lake White Bear Lake Skunk Lake Christmas Lake

Sullivan EST. POP. 150

R I C H A R D S O

R 28 W

To Pine Centre


51 8 270 47

1 3 5 7 9 11 13 15 17 19 21 23 25 27 29 31 33 35

272

55'

N

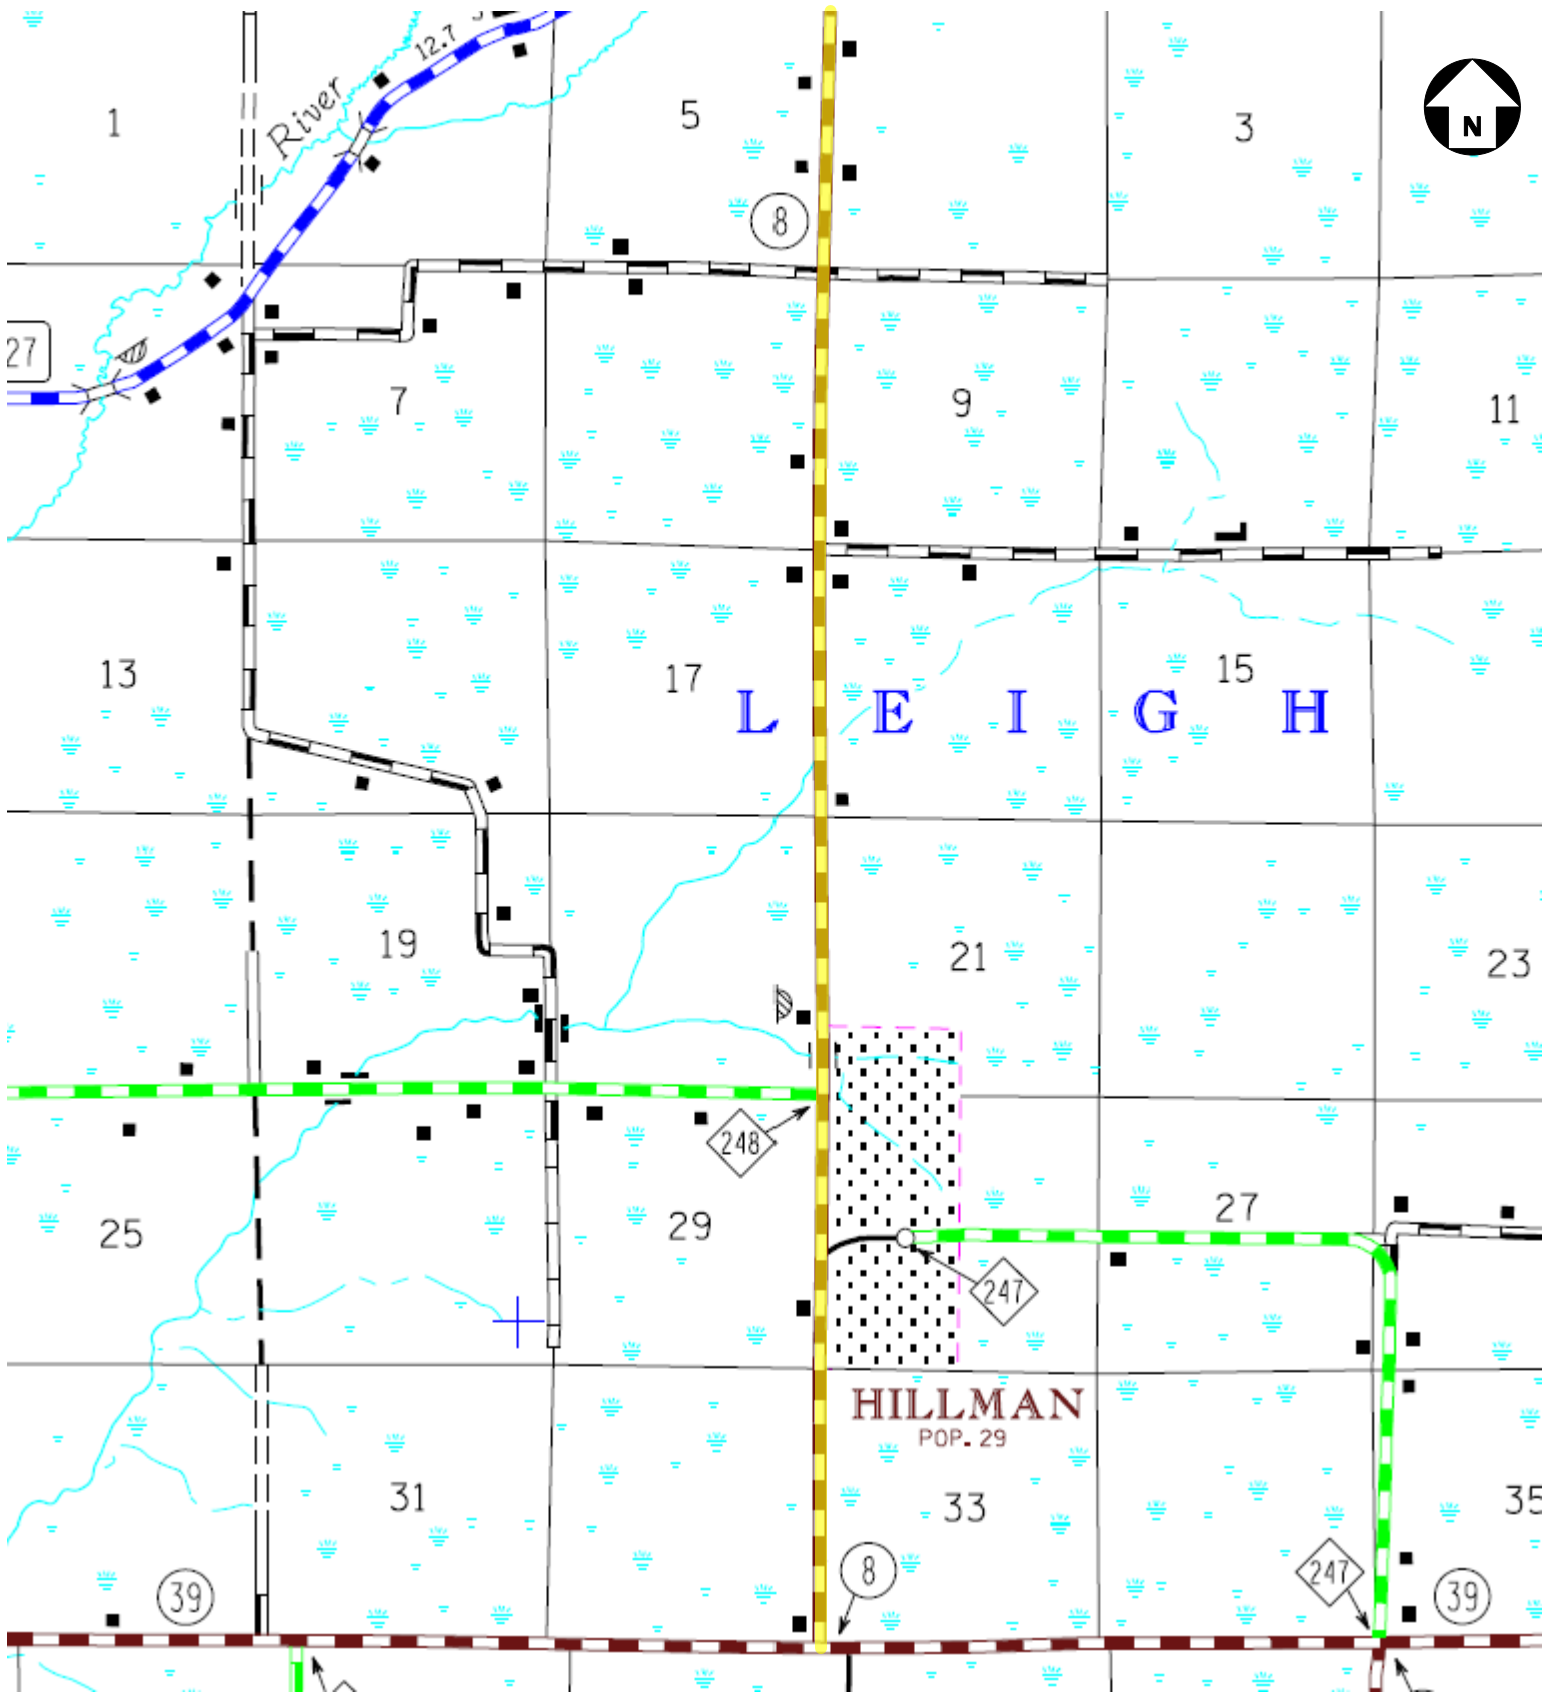


Morrison County Road #8

Proposed Route Highlighted Yellow

The proposed route would start at the Crow Wing County and Morrison County Line heading South 12.15 miles or 64,152 feet ending at the intersection of CSAH #8 and CSAH #39, Including 41 Road Crossings.

DISTANCE FROM G ROAD SEE NOTATION		BURIED PLANT STAKING SHEET & PLANT RECORD		SEC. 32/33 5/4	SHEET 6 OF 14
STAKED BY EDB	DATE 3-21-10	COMPANY CTC	TWP. 43N	ROUTE COB	
REV.	REV.	PROJECT MNS37-2011	RANGE 28W	MAP REFERENCE	
AS BUILT ENT. BY	DATE	EXCHANGE Sullivan	CO. CROW WING MORRISON		

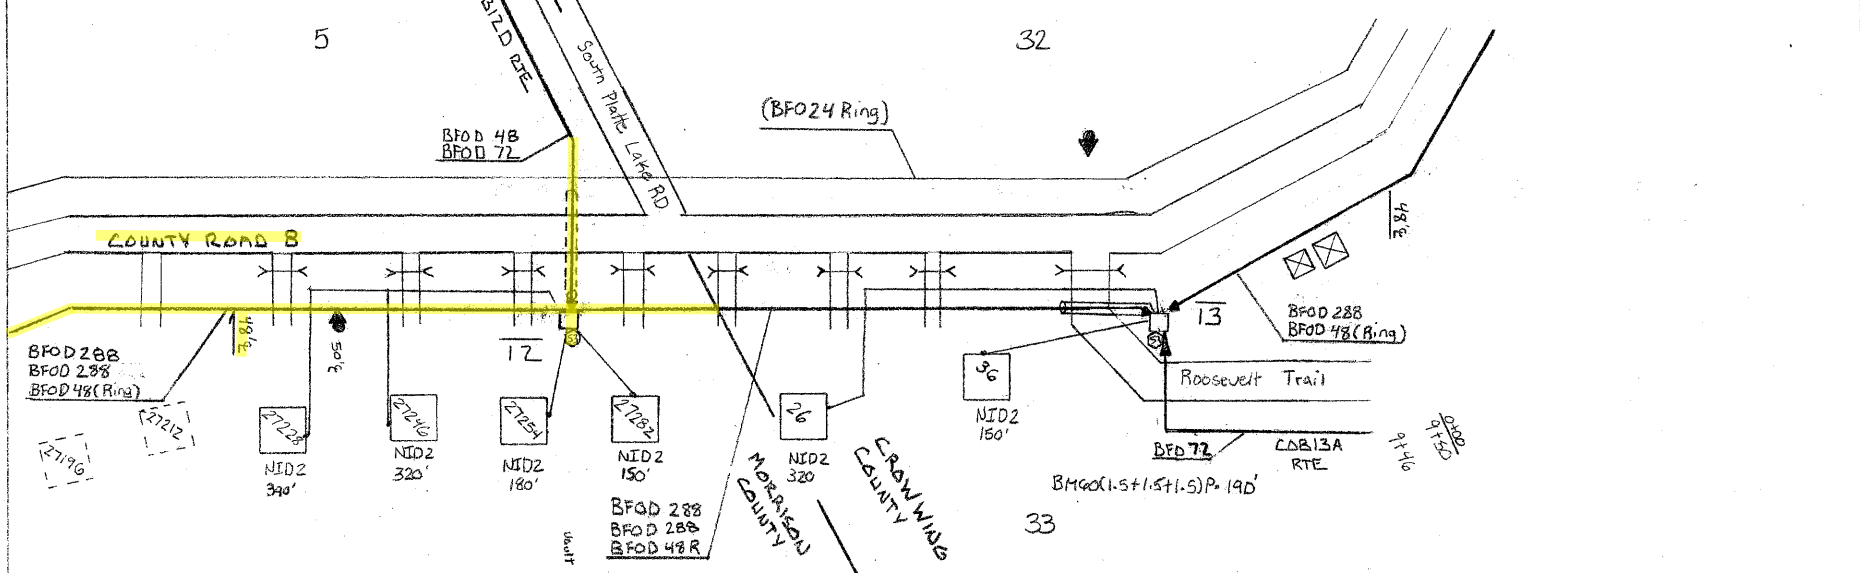


PED.	BA	BD				BH	HRF	BFO	SUB	SEB	BM	NID	HO	X	Contr.
						F 36x60 x 36 T	0 (288)	(48 288 288) D	NO.	4	(38) (8)	2	7		BA BD
12						1	1	330 470 330	27228	390		1	124		1 1
									27246	320		1			
									27254	180		1			
									27282	150		1			
13						1	1	610 680 610	26	320	190	1	74		
									36	150		1			
						2	2	940 1150 940		1510	190	6	198		1 1

FORM CCI-103



DISTANCE FROM R ROAD SEE NOTATION		BURIED PLANT STAKING SHEET & PLANT RECORD		SEC 5	SHEET 5 OF 14
STAKED BY EDB	DATE 3-19-10	COMPANY CTC	TWP 42N	RANGE 28W	ROUTE COB
REV.	REV.	PROJECT MW537-2011	CO Morrison	MAP REFERENCE	
AS BUILT BY	DATE	EXCHANGE Sullivan			

5

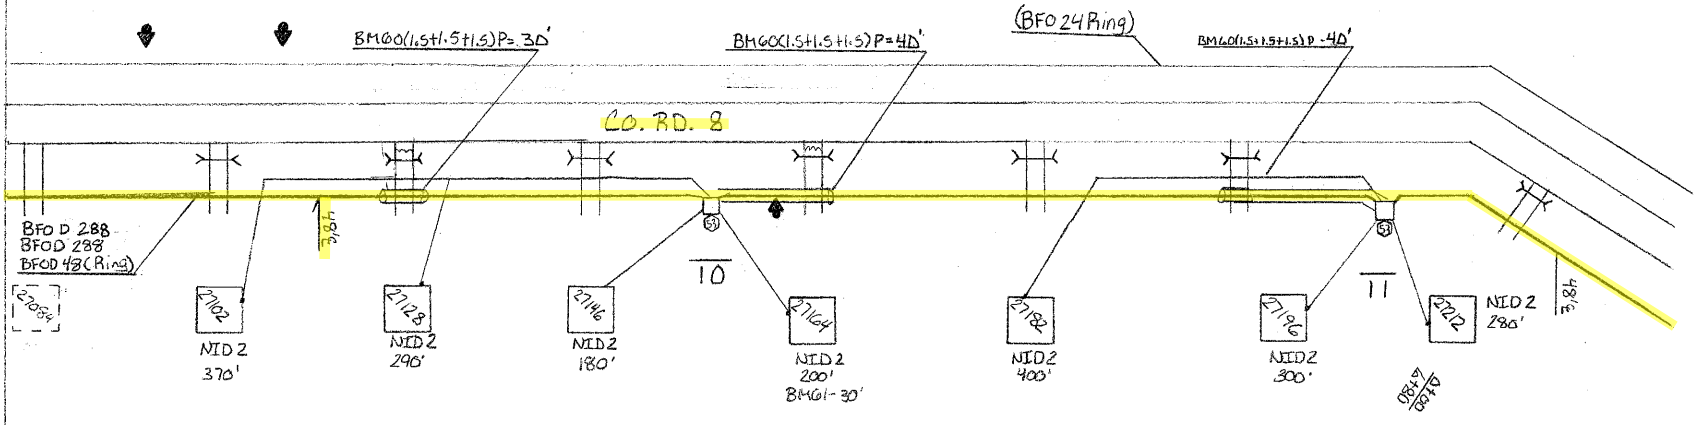


PED.	BA	BD	BH	HBF	SFO	SUB.	SEB	BM	NID	HO	X CONTR.	
			F 36x60 x 36 T	0 (288)	(48 ; 288 ; 288) D	NO	4	60(1.5+1.5+1.5)P 61 (3)	2	-1	BA BD	
10			1	1	542	682	542	27102 370 27128 290 27146 180 27164 200	3D 30	1 1 1 1	4	
11			1	1	747	387	242	27182 400 27196 300 27212 280	8D	1 1 1	3 1 1	
			2	2	784	1064	784	2020	2	11D 30	7	7 1 1

FORM CCI-103



DISTANCE FROM G ROAD SEE NOTATION		BURIED PLANT STAKING SHEET & PLANT RECORD		SEC. 5	SHEET 4 OF 14
STAKED BY EDB	DATE 3-19-10	COMPANY CTC	TWP. 42N	ROUTE COB	
REV.	REV.	PROJECT MN537-2011	RANGE 28W	MAP REFERENCE	
AS BUILT BY	DATE	EXCHANGE Sullivan	CO. Morrison		

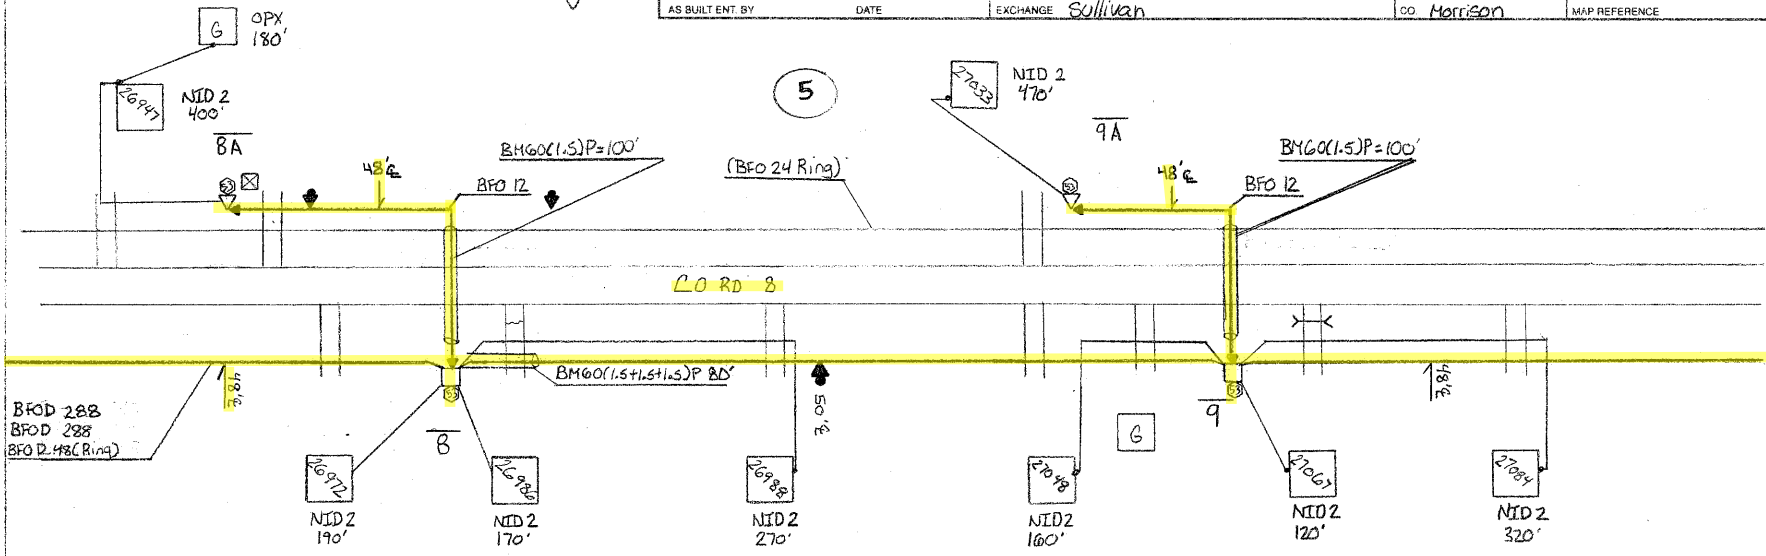

PED.	BA	BOD	UD	BH	HBF	BFO	SUB.	SEB	BM	NID	HO	X CONTR.		
		4	(14-1)S	F(36x60 X 36)T	(288)	24 (48 ; 288 ; 288)D	NO. 4	4	(2) (8) 53 (60 (1 1/2) P (1 1/2) P	2	-1	BA BD		
B				1	1	474 614 474	26972	190	1	1	5	1 1		
							26986	170		1				
BA	1		180			384	26988	270		1				
							26947	400	OPX	1	1	100	1 1	
9				1	1	462 602 462	27048	160		1		80	1 1	
							27067	120		1				
							27084	320		1				
9A	1					276	27033	470		1	1	100	1 1	
		2	180	2	2	6660 936 1216 936	2100	4	2	200	80	8	12	3 3


FORM CCI-103



DISTANCE FROM ROAD		SEE NOTATION		BURIED PLANT STAKING SHEET & PLANT RECORD			REL. 5	SHEET 3 OF 14
STANDARD BY EDB	DATE 3-19-10	COUNTRY CTC	LINE 42N	PROJECT MNS37-2011	RANGE 28W	ROUTE COB		
DATE	BY	DATE	BY	DATE	BY	DATE		
				SULLIVAN		MORRISON		

5


26947

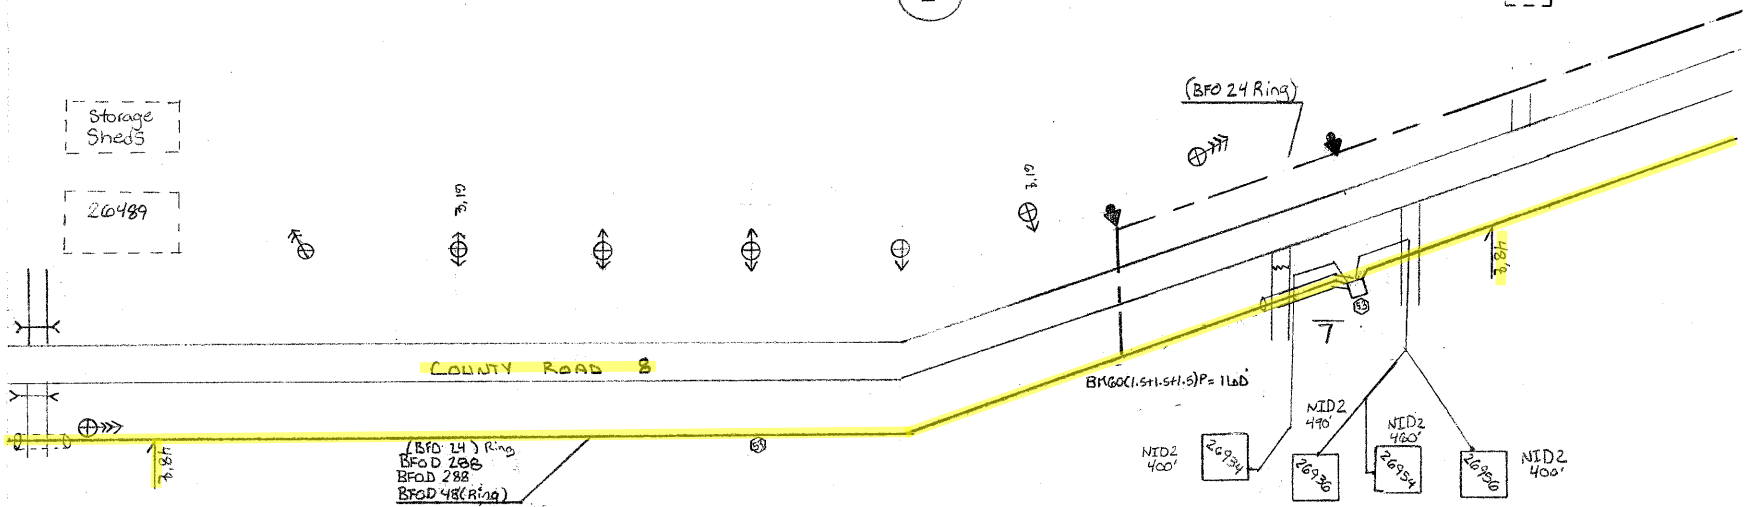

PLAN											X						
CROSS SECTION											CONT.						
STATION	BA	SD	BH	HPF	3FO		SUB	DEB	BIO		NID	0	X 2				
10884	2178	3440	3802	10467	13228	15496	17428	18496	19470	19498	20408	21100	21478	23200	23700	BA	BD
			F 136X60 X 36 T	0 288	(48	288	288	D	40	4	(2 3/4)8			601'+ 13412)P	2	1	
			1	1	2548	2688	2548	26934	400					210	1	4	4
								26936	490						1		
								26954	460						1		
								26956	400						1		
			1	1	2548	2688	2548	1750		1				210	4	4	4


FORM CC-165

DISTANCE FROM LOCAL POLE SEE NOTATION		BURIED PLANT STAKING SHEET & PLANT RECORD		SEC. 5/4	SHEET 2 OF 14
STAKED BY EDB	DATE 3-19-10	COMPANY ETC	TWP 42N	RANGE 28W	ROUTE COB
REV.	REV.	PROJECT MNS37-2011	CC Morrison	MAP REFERENCE	
AS BUILT ENT. DATE	DATE	EXCHANGE Sullivan			

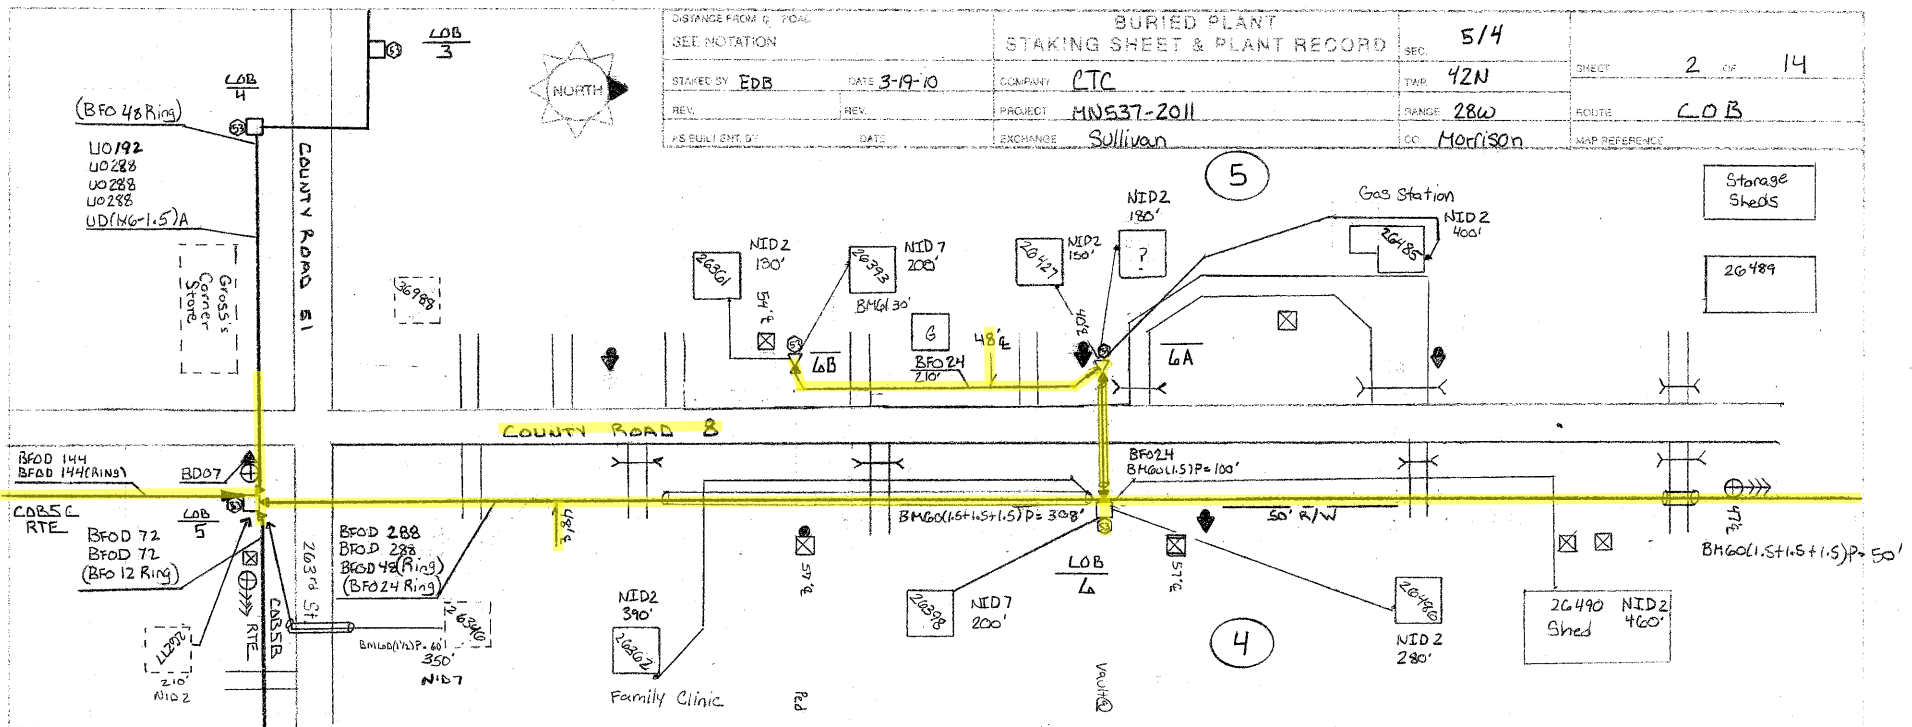

PEC.	3A	300	UD	BH	H&F	SPOD				SUB	SEB	BM			NID	HO	X				
			(M-1)S	F(36x60) x(36)T	O (288)	24	48	288	288	D	NO.	4	2	53	60	60	41	7	-1	SA	BD
LOB	6			1	1	766	846	766	26362	390			308	1	10					2	2
	2		20						26398	200					1						
									26486	280											
6A		1				210			26490	460											
									26427	150	1	1	100								3
									?	180											
6B		1				270			26485	400											
	2		20						26361	130	1	1									2
	4	2	40	1	1	480	766	846	766	2390	3	2	100	308	30	6	2	15		2	2

DISTANCE FROM E ROAD SEE NOTATION		BURIED PLANT STAKING SHEET & PLANT RECORD		SEC. <u>5</u> <u>4</u> <u>8</u> <u>9</u>	SHEET <u>1</u> OF <u>8</u>
STAKED BY <u>JMM</u>	DATE <u>3-22-10</u>	COMPANY <u>CTC</u>	TWP. <u>42N</u>	RANGE <u>28W</u>	ROUTE <u>COB5C</u>
REV.	REV.	PROJECT <u>MN 537-28</u>	CO. <u>Morrison</u>	MAP REFERENCE	
AS BUILT ENT. BY	DATE	EXCHANGE <u>Sullivan</u>			

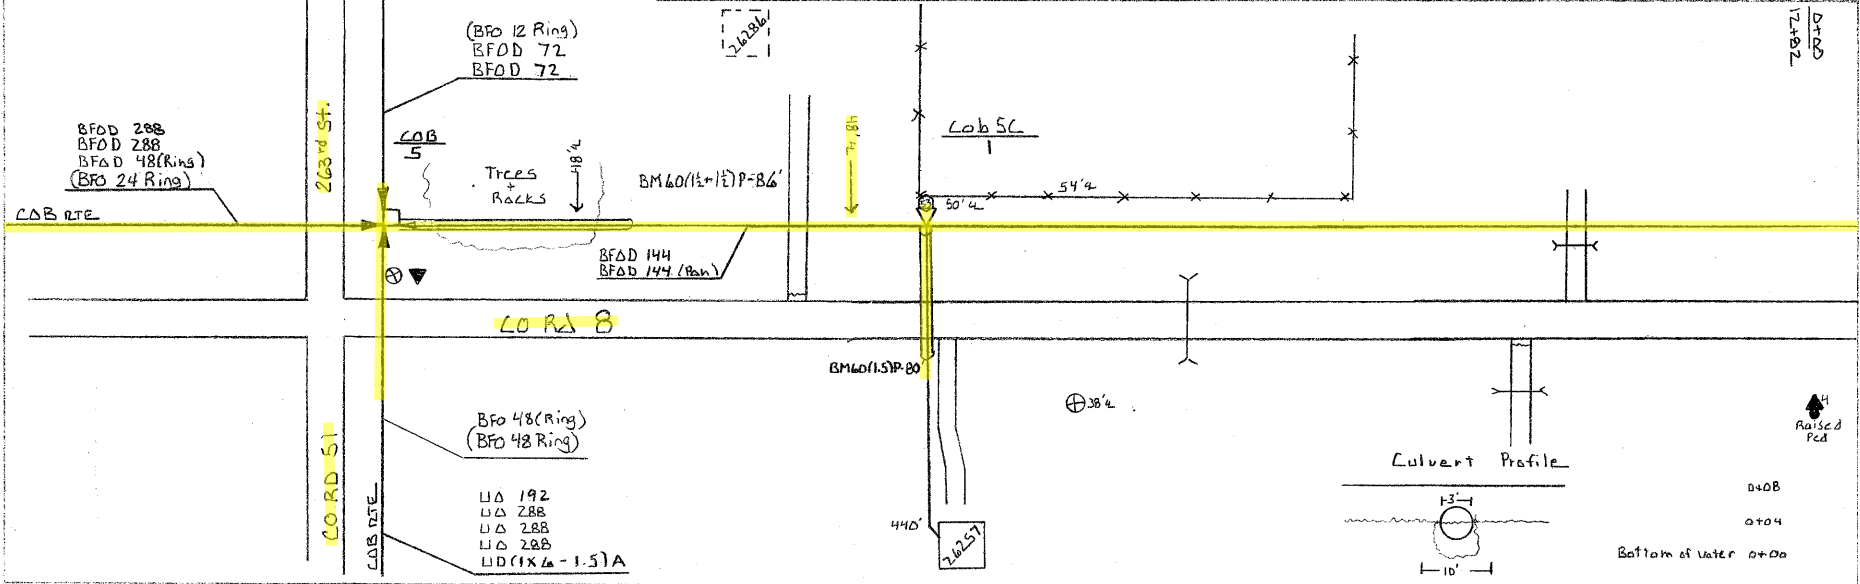


PED.	BA	BDD	BFO	SUB.	SEB	BM	NID	HO	XZ
		5	(144 144) D	NO.	4	(2/3) 53 60(1 1/2) P 60(1 1/2) P	2	1	BA BP
1		1	246 356	26257	440	1 1 80 86	1	1	1 1
		1	246 ✓ 356 ✓		440 ✓	1 ✓ 1 ✓ 80 ✓ 86 ✓	1 ✓	1 ✓	1 1

FORM CC-103




DISTANCE FROM ROAD SEE NOTATION		BURIED PLANT STAKING SHEET & PLANT RECORD		SEC. $\frac{9}{8}$	SHEET 2 OF 8
STAKED BY IMM	DATE 3-22-10	COMPANY CTL	TWR 42N	RANGE 28W	ROUTE COB5C
REV.	REV.	PROJECT MNS37-28	CO. Morrison	MAP REFERENCE	
AS BUILT ENT BY	DATE	EXCHANGE Sullivan			

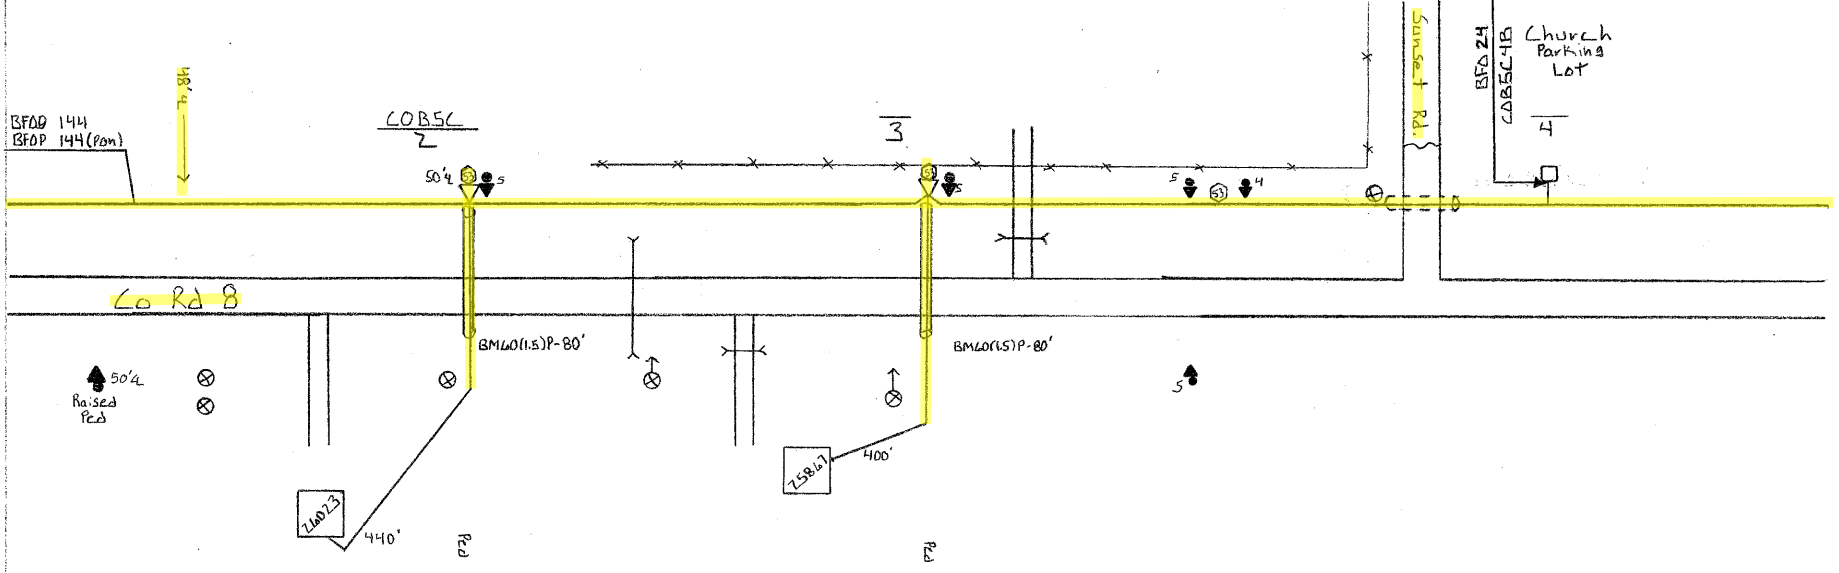


PED.	BA	BDD	BFO	SUR	SEB	BM	NID	HO	X2
		5	(144 144) D	NO.	4	(5) (8) 53 60 115) P	2	1	BA BD
2		1	1472 1572	26023	440	1 1 80	1	1	1 1
3		1	756 856	25867	400	1 1 80	1	1	1 1
		2	2228 2428		840	2 2 160	2	2	2 2

FORM CO-103

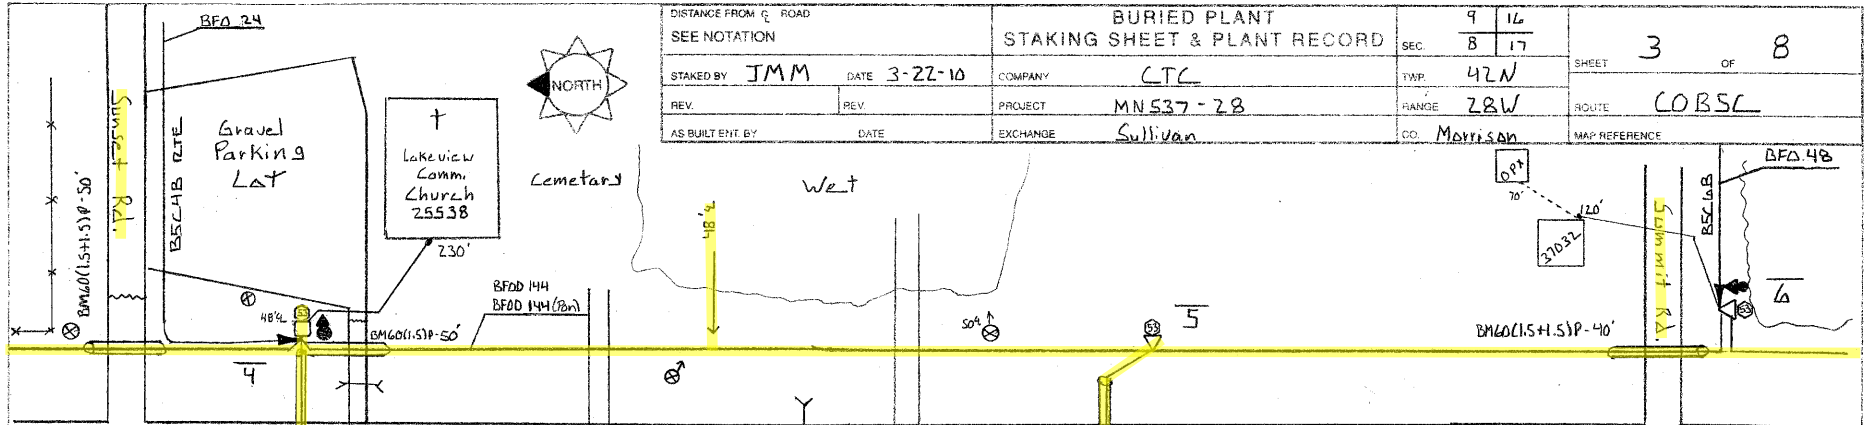


DISTANCE FROM E ROAD SEE NOTATION		BURIED PLANT STAKING SHEET & PLANT RECORD		SEC 9 8	16 17	SHEET 3 OF 8	
STAKED BY JMM	DATE 3-22-10	COMPANY CTC	TWP 42N	RANGE 28W		ROUTE COBSC	
REV.	REV.	PROJECT MN537-28	CO. MORRISON	MAP REFERENCE			
AS BUILT BY	DATE	EXCHANGE Sullivan					

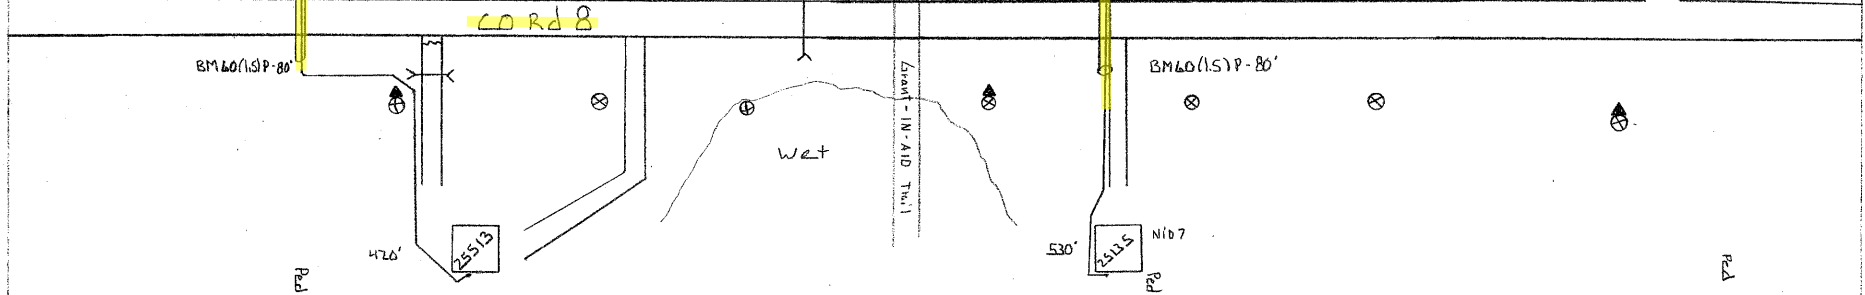

PED.	SA	BOO	LD	BH	HBF	BFC	SUB	SEE	BM	NID	HO	X CONTR
	2	5	(1x1-1)S	F(30x48 X36)T	(144)	(144)D	NO.	4	(8) 53 60(15)P 160(15)P	2	7	BA/BO
4				1	1	1574 1674	Church 25538	230	1 1 80 50	1	14	4 4
							25513	420		1		
5	2	1	20			1816 1916		23135 530	1 1 80 50	1	1	1 3
6		1	70			704 804		37032 170 DPX	1 1 40	1	37	1
	2	2	90	1	1	4094 4394		1300	3 3 160 140	3	1 52	5 8

FORM GCH-103


DISTANCE FROM C ROAD SEE NOTATION		BURIED PLANT STAKING SHEET & PLANT RECORD		SEC. $\frac{16}{17}$	SHEET 4 of 8
STAKED BY IMM	DATE 3-22-16	COMPANY CTC	TWP 42N	RANGE 28W	ROUTE COB5C
REV.	REV.	PROJECT MN537-28	CO. Morrison	MAP REFERENCE	
AS BUILT BY	DATE	EXCHANGE Sullivan			

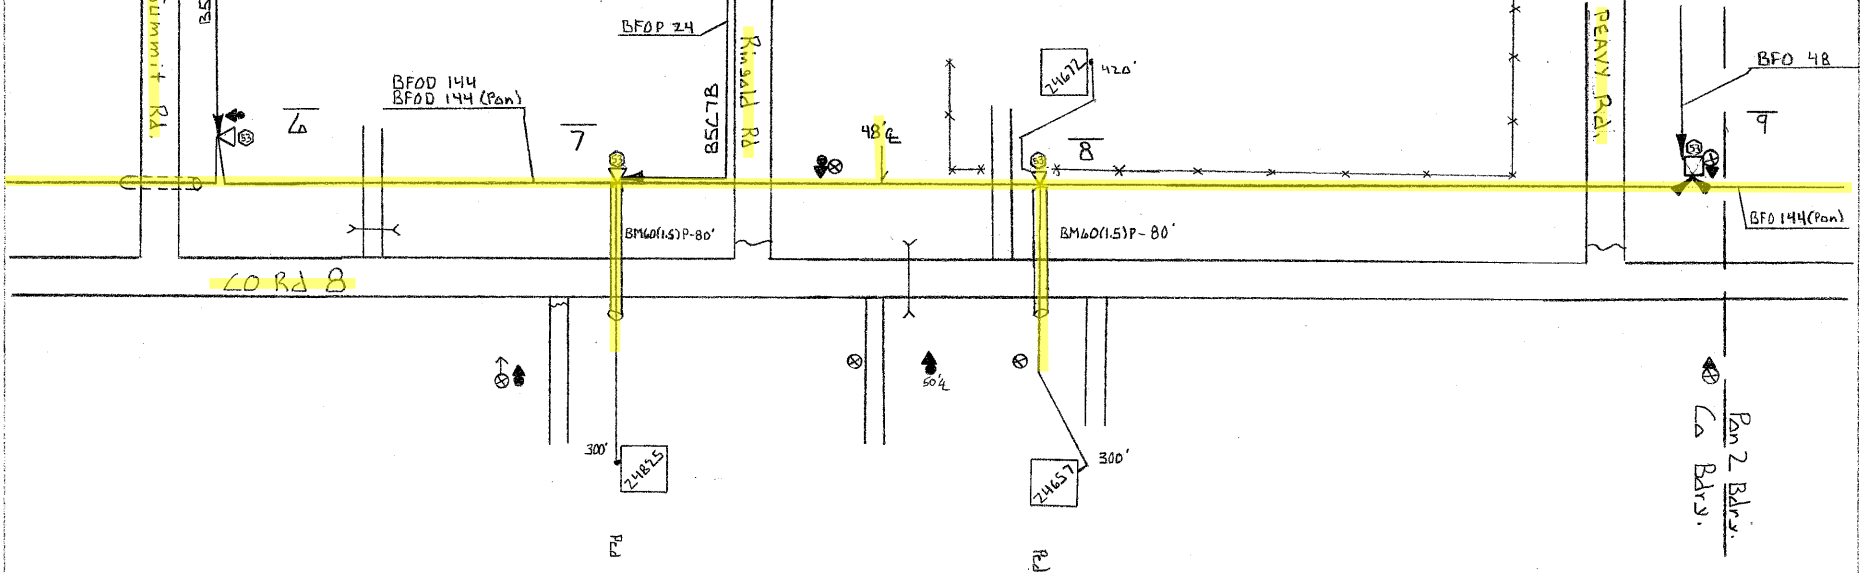

PED.	BA	BD	HB	BH	BFO	SUB	SEB	BM	NID	FO	X CONT.
		5	(144) (144)	F(36x160 x36)T	(144) (144) D	NO.	4	($\frac{2}{3}$) 53 (1 $\frac{1}{2}$)P	2	1	BA BD
7		1			1050 1150	24825	300	1 1 80	1	13	1 1
8		1			710 810	24657	300	1 1 80	1	2	2 2
						24672	420		1		
9			1 1	1	976 1026			1		192	
		2	1 1	1	2736 2986		1020	3 2 160	3	207	3 3

FORM CO-103

DISTANCE FROM G. ROAD SEE NOTATION		BURIED PLANT STAKING SHEET & PLANT RECORD		SEC. 21 16	SHEET 3 OF 3
STAKED BY RJB	DATE 3-25-10	COMPANY CTC	TWP 41N	ROUTE 2A11A	
REV.	REV.	PROJECT MNS27-2011	RANGE 28W	MAP REFERENCE	
AS BUILT BY	DATE	EXCHANGE SULLIVAN	CO. MADISON		

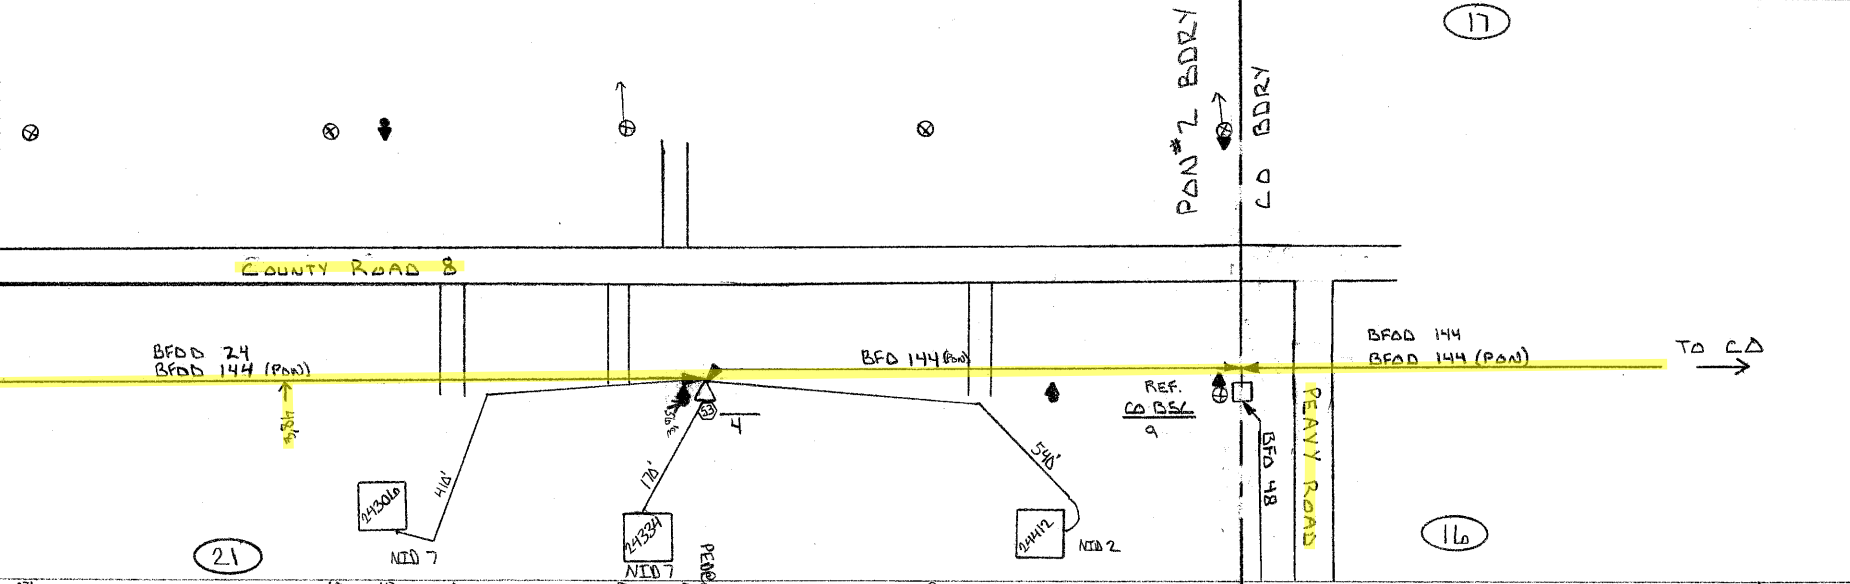


APP. 000	PED.	BA	BDD	LID	BFO	SUB. NO.	SEB	NID	NIA	BM	CONTRACT		
											HO	XZ	XZ
	3	2	4	(1x-17)S	144 (24 ± 144)D	NO. 4	4	2	7	2570 53	-1	BA	RD
	4	2	1	ZD	3596 3536	24306	410	1	1	3 170	3	3	3
		2		ZD		24334	170						
						24412	540	1					
					608								
		4	1	4D	608 3596 3536		1120	1	2	1 3 170	3	3	3

FORM CCI-103




DISTANCE FROM G ROAD SEE NOTATION		BURIED PLANT STAKING SHEET & PLANT RECORD		SEC. 21	SHEET 2 OF 3
STAKED BY ROB	DATE 3-25-10	COMPANY CTC	TWP 42N	ROUTE 2A11A	
REV.	REV.	PROJECT MN537-2011	RANGE 28W	MAP REFERENCE	
AS BUILT ENT BY	DATE	EXCHANGE SULLIVAN	CO. MORRISON		

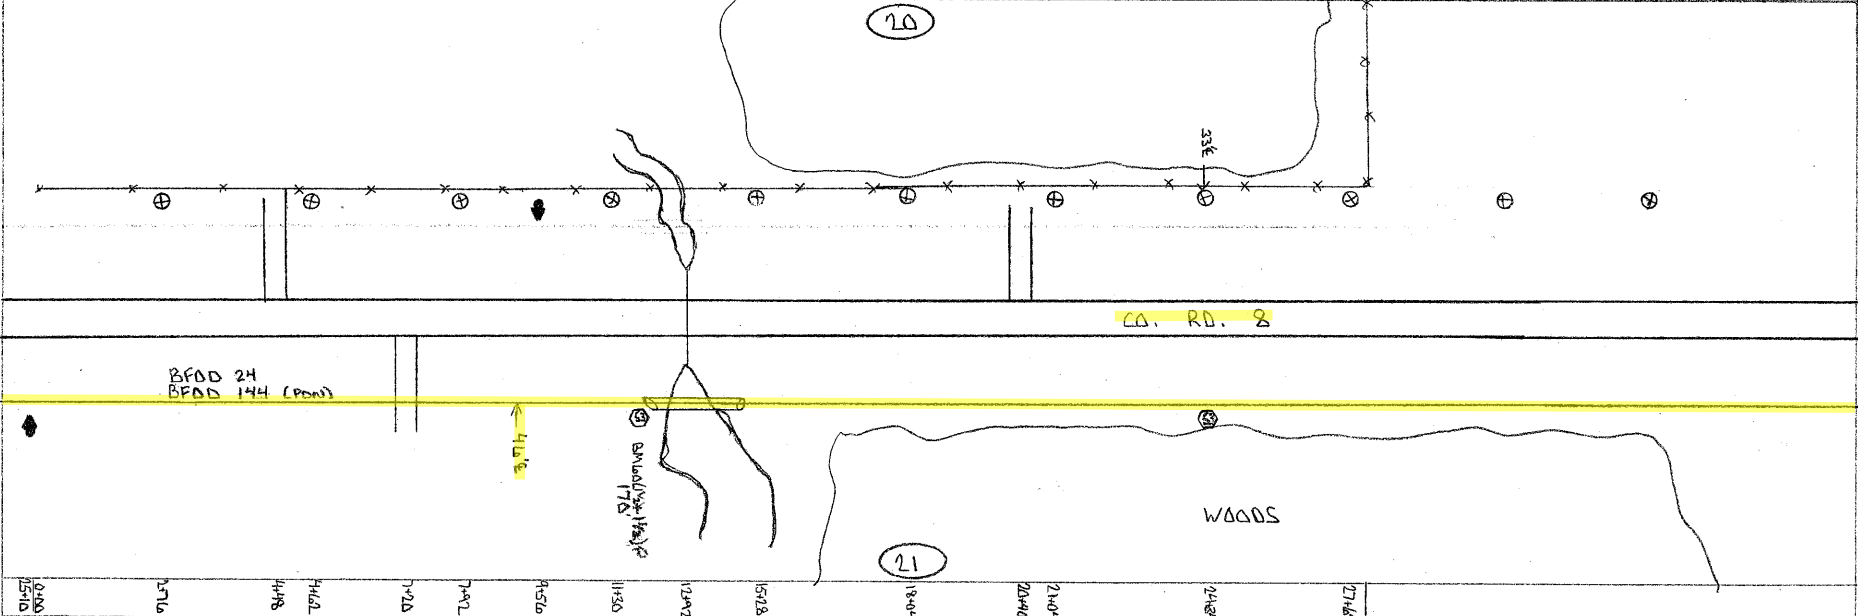

PED.	BA	BD							BFC	SUB.	SEB				BM			HC
										NO.								

No Units


DISTANCE FROM Q ROAD SEE NOTATION		BURIED PLANT STAKING SHEET & PLANT RECORD		SEC 21	SHEET 1 OF 3
STAKED BY RJB	DATE 3-25-10	COMPANY CTL	TWP. 42N	ROUTE 2A11A	
REV.	REV.	PROJECT MNE37-2011	RANGE 28W	MAP REFERENCE	
AS BUILT BY	DATE	EXCHANGE SULLIVAN	CO. MORRISON		

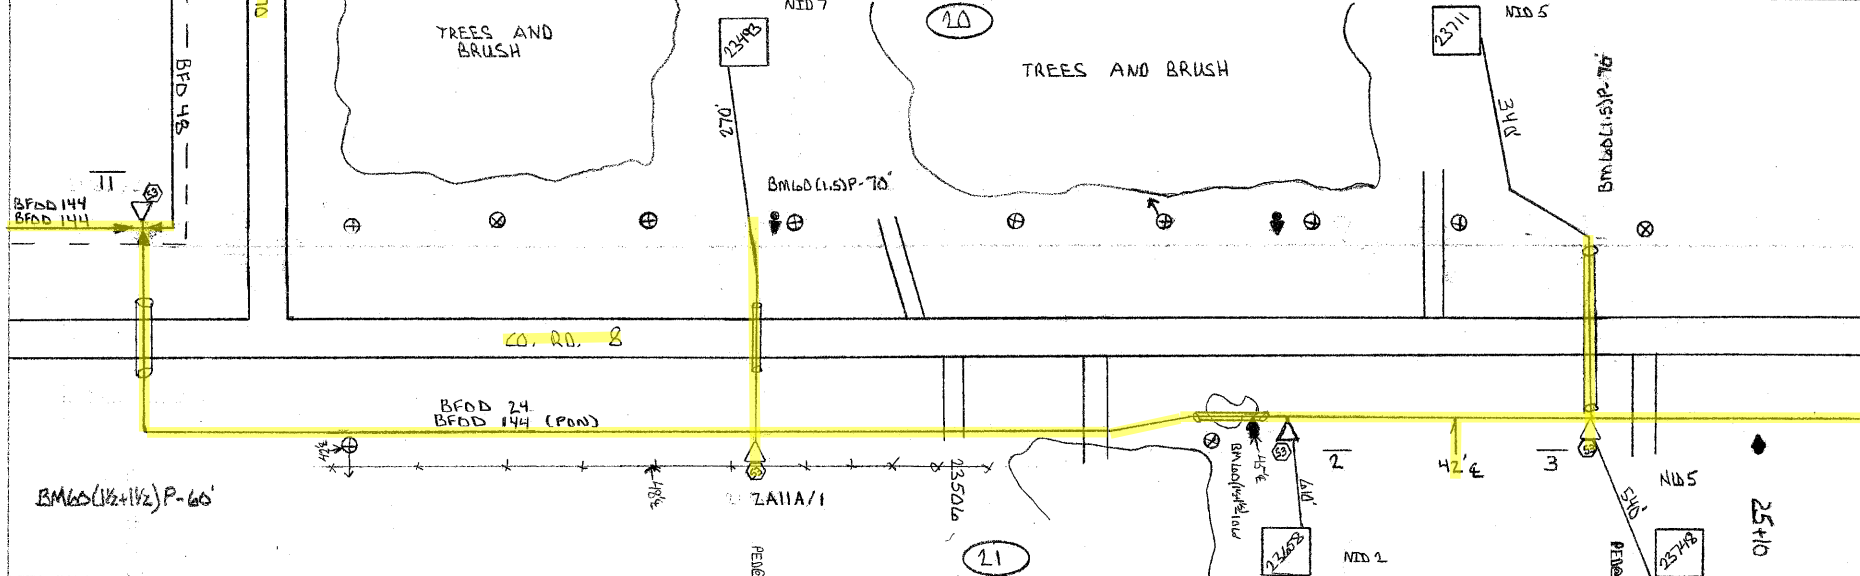

PED.	BA	BDO	UD	BFO	NID	SUB.	SEB	NID	BM	H	XZ	XZ
	2	4	(xl-175)	(24 & 144)D	2 5	NO.	4 7	2(18) 53	60 70	-	BA	BD
1	2	1	20	1046 986		23493	270 1	1 1	60 70	1	1	1
2		1		994 934	1	23608	610	1 1	106	1	2	2
3		1		726 666	1	23711 340		1 1	70	2		
					1	23748 540						
	2	3	20	2766 2586	1 2	1760	1	3 3	166 140	4	3	3


FORM CC-103

DISTANCE FROM G ROAD SEE NOTATION		BURIED PLANT STAKING SHEET & PLANT RECORD		SEC. 29	SHEET 5 OF 11
STAKED BY RSB	DATE 3-24-10	COMPANY CTC	TWP 42N		
REV.	REV.	PROJECT MN537-2011	RANGE 18W	ROUTE 2A	
AS BUILT ENT. BY	DATE	EXCHANGE SULLIVAN	CO. MORRISON	MAP REFERENCE	

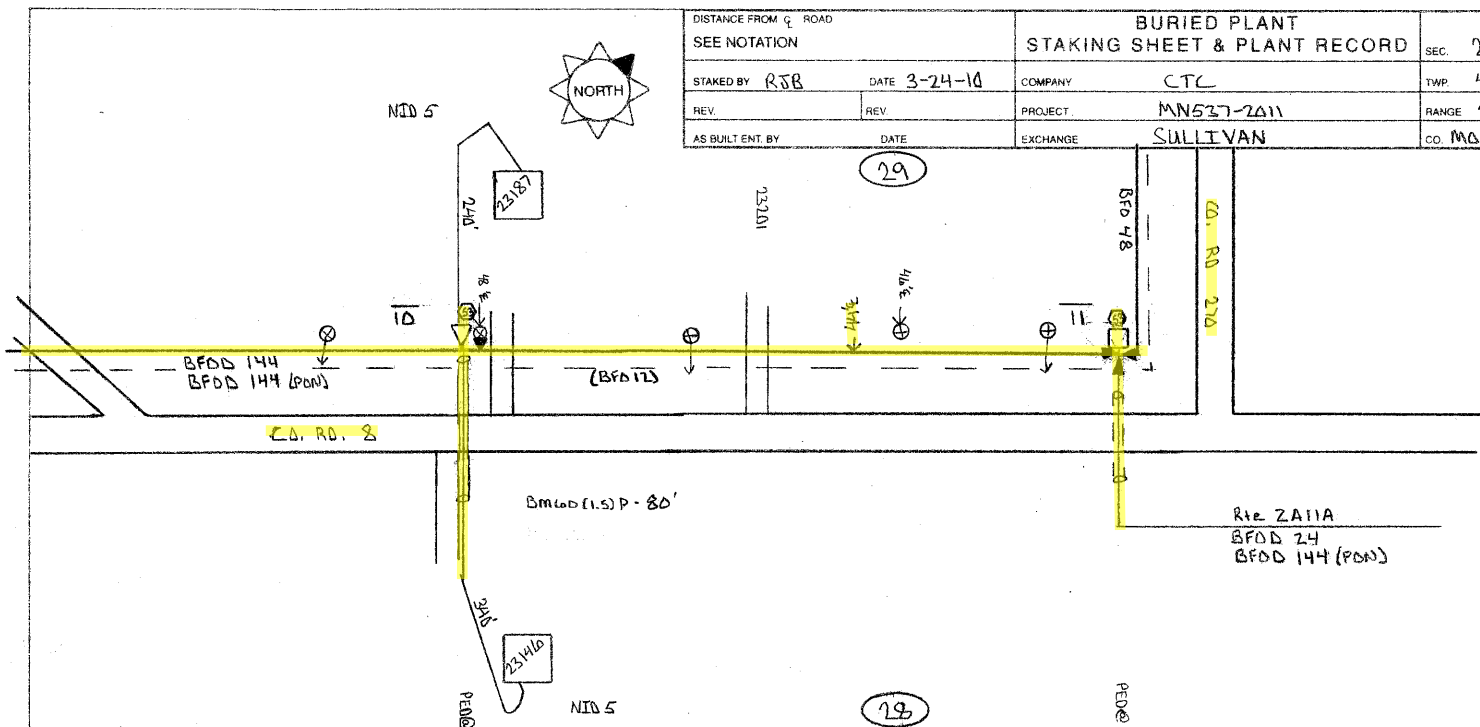


PED.	BA	BDO	HSB	BH	BFO	NID	SUB.	SEB	BM			HO	X CONTRACT			
			D (144)	F(36x60 x36)T	(144) D	5	NO.	4	2 (36) (8)	53	60 (18)P	-1	BA	BD		
10		1			1056	1136	1	23187	240	1	1		2		1	
							1	23146	340			80				
11			1	1	1	862	942			1					216	
		1	1	1	1918	2078	2	580		2	1	80			218	1

FORM CCI-103

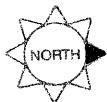

DISTANCE FROM G ROAD SEE NOTATION		BURIED PLANT STAKING SHEET & PLANT RECORD		SEC. 28	SHEET 14 OF 11
STAKED BY: RSB	DATE: 3-24-10	COMPANY: CTC	TWP: 42N	ROUTE: 2A	
REV.	REV.	PROJECT: MNS37-2011	RANGE: 28W	MAP REFERENCE	
AS BUILT BY	DATE	EXCHANGE: SULLIVAN	CO: MORRISON		

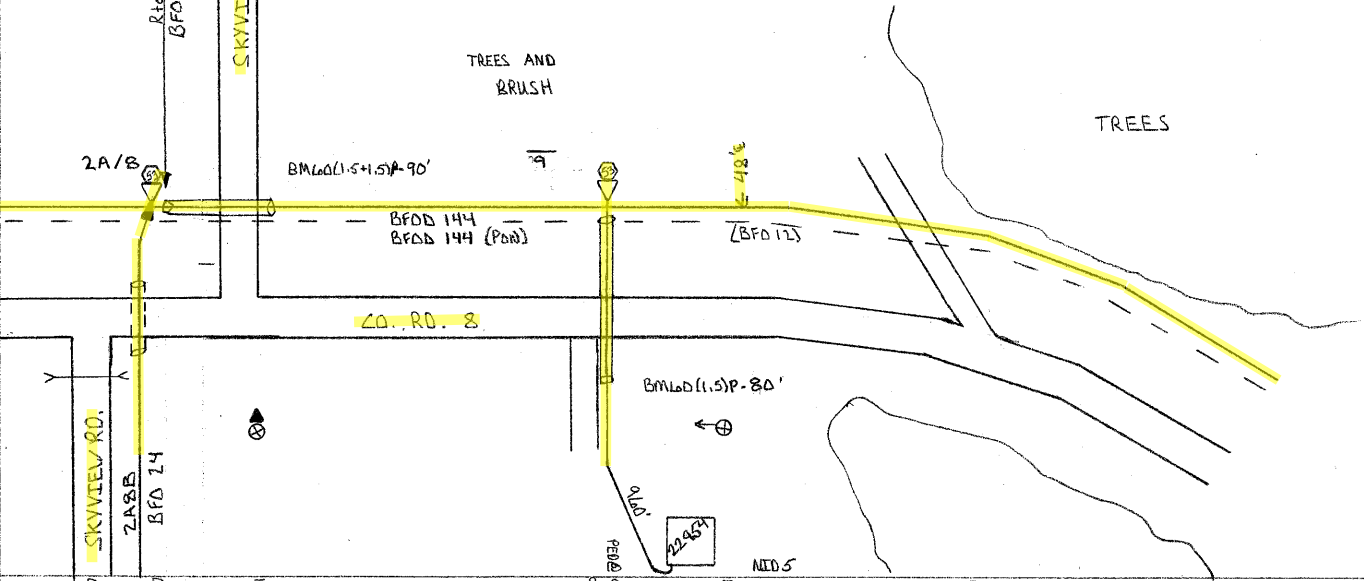


PED.	BA	BOD	BFO	NID	SUB.	SEB	BM				HO	CONTRACT	
												XZ	XZ
		5	(144) (144) D	5	NO.	4	2	53	60	60	-1	BA	BD
9		1	926 1006	1	22954	960	1	1	80	90	1		1
		1	926 1006	1		960	1	1	80	90	1		1

FORM CCI-103




DISTANCE FROM ROAD		SEE NOTATION		BURIED PLANT STAKING SHEET & PLANT RECORD		SEC 28	SHEET 3 OF 11
STAKED BY RTB	DATE 3-24-16	COMPANY CTC	TWP 42N	PROJECT MN537-2011		RANGE 28W	ROUTE 2A
REV.	REV.	EXCHANGE SULLIVAN	CO MORRISON	MAP REFERENCE			

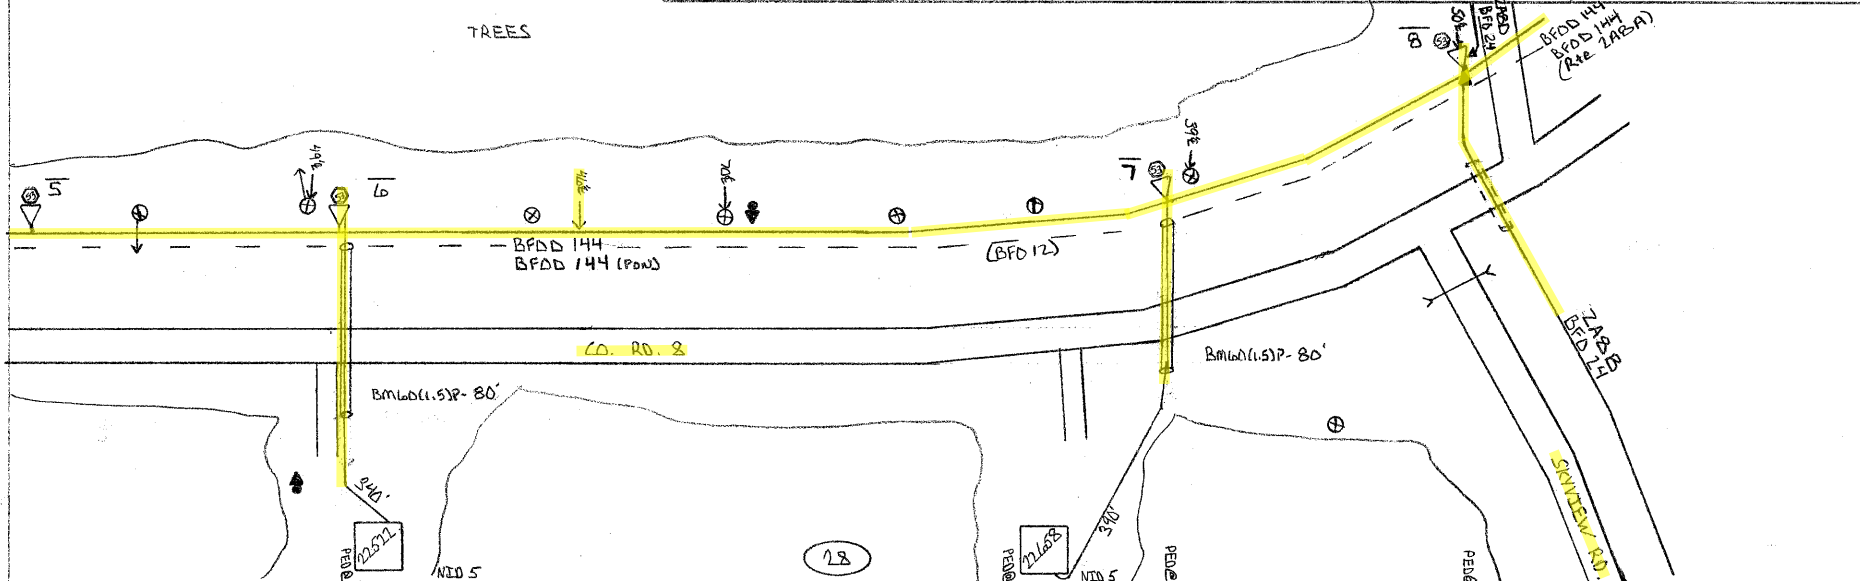

PED.	BA	BDO	BFO		NID	SUB	SEB	BM			HO	CONTRACT	
												XZ	XZ
5		5	(144	144) D	5	NO. 4	2	53	60	-1	BA	BD	
6		1	472	552	1	22572	340	1	80	1	1	1	
7		1	1036	1116	1	27658	390	1	80	1	1	1	
8		1	606	686				1		30			
		3	2114	2354	2	730	3	3	160	32	2	2	

FORM CCI-103

DISTANCE FROM Q ROAD SEE NOTATION		BURIED PLANT STAKING SHEET & PLANT RECORD		SEC 33	28	SHEET 2 OF 11	
STAKED BY RSB	DATE 3-24-16	COMPANY CTL	TWP. 42N	RANGE 28W		ROUTE 2A	
REV.	REV.	PROJECT MNS37-2611	CO. MARRISON	MAP REFERENCE			
AS BUILT ENT. BY	DATE	EXCHANGE SULLIVAN					

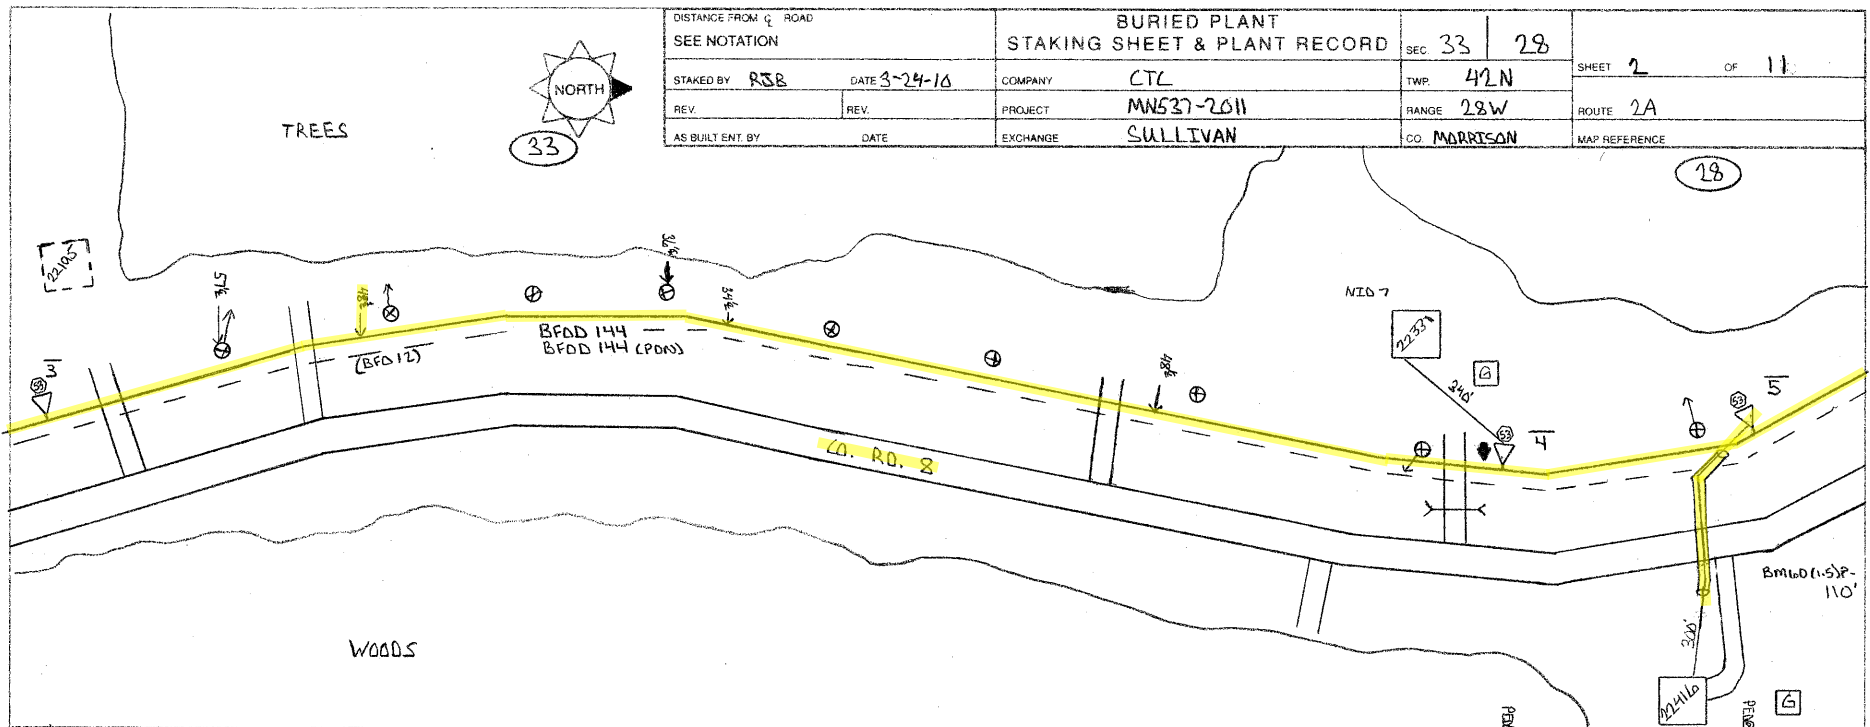


PED.	BA	BDD	UD	BFO	NID	SUB.	SEB	BM	HO	CONTRACT	
3	2	5	(1x1)S	(144 ; 144)D	5 7	NO. 4	(5/8) 53	LoD (12)P	-1	BA	BD
4	2	1	20	2260 2340	1	22331 340	1 1		1	1	1
5		1		320 400	1	22416 300	1 1 110		1		
	2	2	20	2580 2740	1 1	640	2 2 110		2	1	1

FORM CCI-103



DISTANCE FROM ROAD SEE NOTATION		BURIED PLANT STAKING SHEET & PLANT RECORD		SEC. 32	SHEET 1 OF 11
STAKED BY: RJB	DATE: 3-24-10	COMPANY: CTC	TWP: 42N	RANGE: 28W	ROUTE: 2A
REV.	REV.	PROJECT: MN537-2011	RANGE: 28W	ROUTE: 2A	MAP REFERENCE
AS BUILT ENT. BY	DATE	EXCHANGE: SULLIVAN	CC: MORRISON		

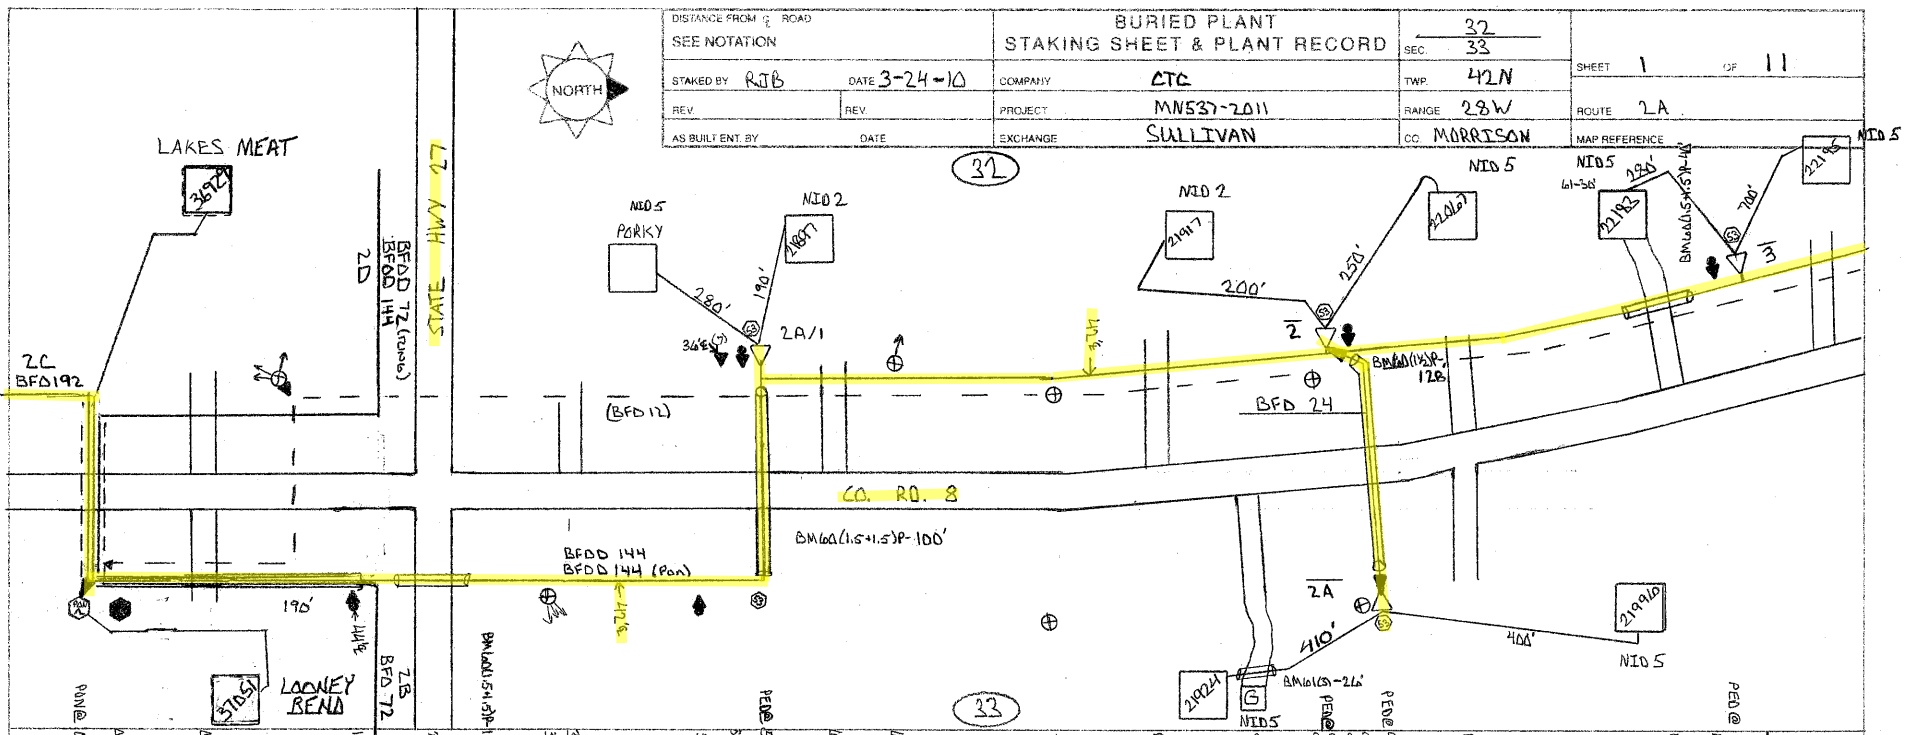

PED.	BA	BOD	HD	BFO	NID	SUB.	SEB	BM	BM	HO	XZ	XZ	CONTRACT	
	4	5	-1	24 (144)	2	5	NO. 4	53	60					
PON 2			674	144D	1		36929	300	60(1/2)P					
2A 1		1	2	642	1	Parky	280	1	60(1/2)P	200	190	3	4	
2A 2		1	5	474	1		21897	190				1	1	
2A 2A	1		2		1		21917	200						
				188	1		22067	250						
2A 3		1	2	362	1		21924	410	128		26			
					1		21996	400						
					1		22183	280	40		30	1	1	
					1		22195	700						
	1	3	685	188	4	6	3362	4	128	240	190	56	5	6

FORM CCI-103

DISTANCE FROM 1/2 ROAD
SEE NOTATION

STAKED BY **EJB** DATE **3-8-10**

REV. _____ REV. _____

AS BUILT ENT BY _____ DATE _____

BURIED PLANT
STAKING SHEET & PLANT RECORD

COMPANY **LTC**

PROJECT **MN537-2011**

EXCHANGE **Sullivan**

SEC. 33
32

TWP **42N**


RANGE **78W**

CO **Morrison**


SHEET 1 OF 28

ROUTE 2C

MAP REFERENCE _____

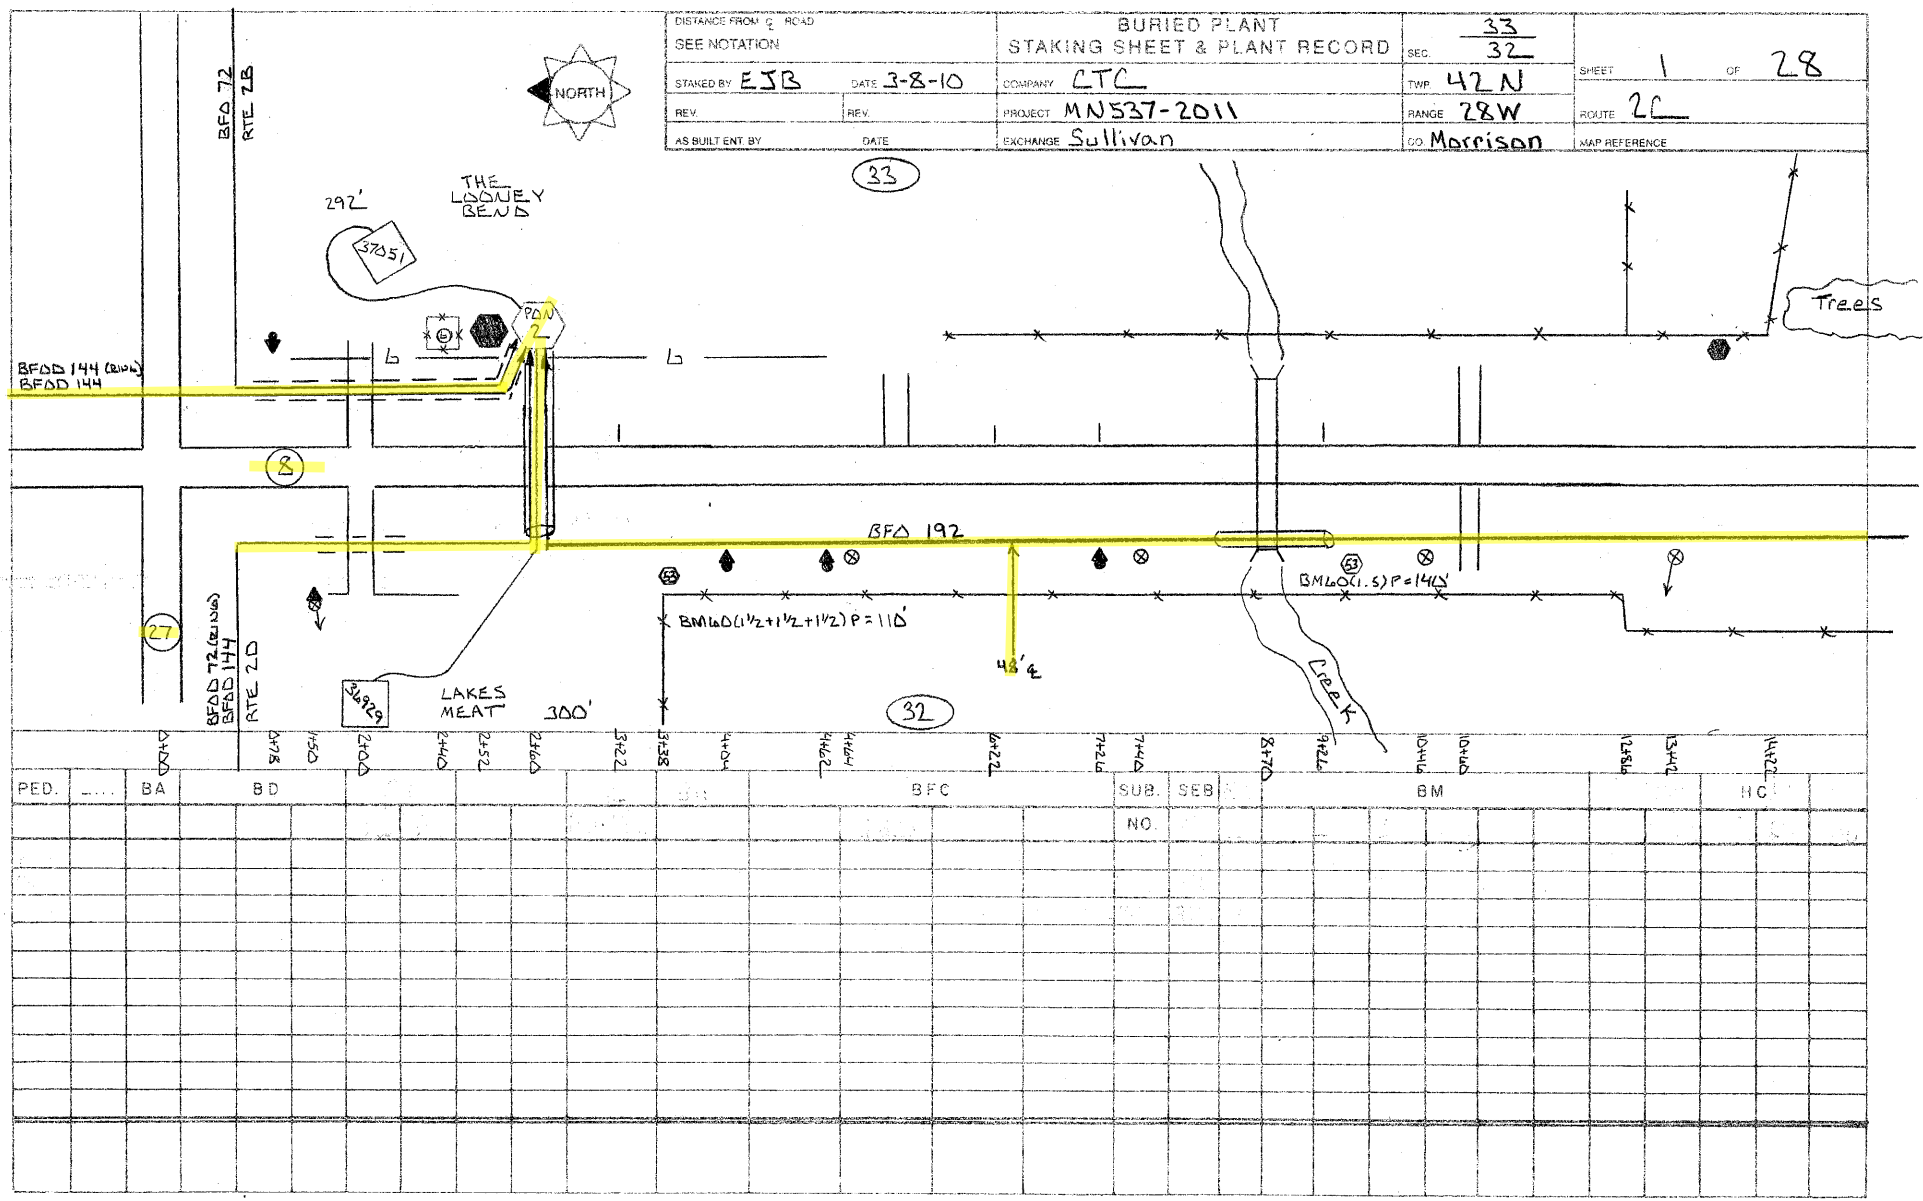

DISTANCE FROM C ROAD SEE NOTATION		BURIED PLANT STAKING SHEET & PLANT RECORD		SEC 33 4 32 5	SHEET 2 OF 28
STAKED BY EJB	DATE 3-8-10	COMPANY CTC	TWP 42N 41N	ROUTE 2C	
REV.	REV.	PROJECT MN537-2011	RANGE 28W	MAP REFERENCE	
AS BUILT ENT. BY	DATE	EXCHANGE Sullivan	CD Morrison	TLR VAL?	

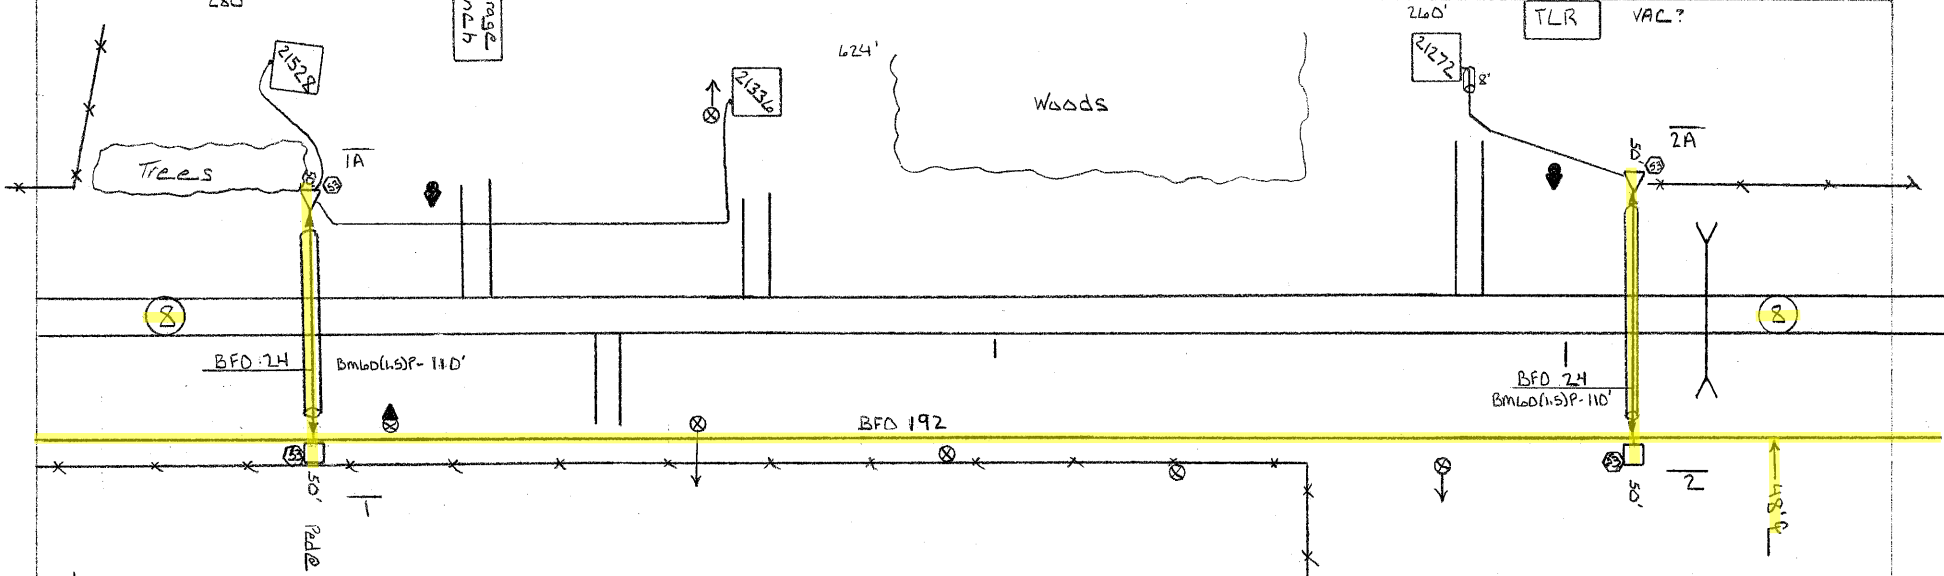


PED	BA	BOO	RH	BFO	SUB.	SEB	NID	BM	HGF	H0	XZ	XZ	CONTRACT
REF	2	4	21336 x 160 x 36	24	NO.	4	2	21528 280 21336 640	53	140	110	192	BA PD
2A			1	1600				1 2 140	110	1	3	3	4
1A		1		200				1 1 110			2	1	1
2			1	1342				21217 740	1		1	2	
2A		1		200				21272 260	1		1	1	1
		2	2	400	2942			1920 4	4	4	360	110	2 8 5 6

FORM CCI-103




DISTANCE FROM G. ROAD SEE NOTATION		BURIED PLANT STAKING SHEET & PLANT RECORD		SEC <u>4</u> <u>5</u>	SHEET <u>3</u> OF <u>28</u>
STAKED BY <u>EJB</u>	DATE <u>3-8-10</u>	COMPANY <u>LTC</u>	TWP <u>41N</u>	RANGE <u>28W</u>	
REV.	REV.	PROJECT <u>MN537-2011</u>	RANGE <u>28W</u>	ROUTE <u>2C</u>	MAP REFERENCE
AS BUILT ENT. BY	DATE	EXCHANGE <u>Sullivan</u>	CO. <u>Morrison</u>		

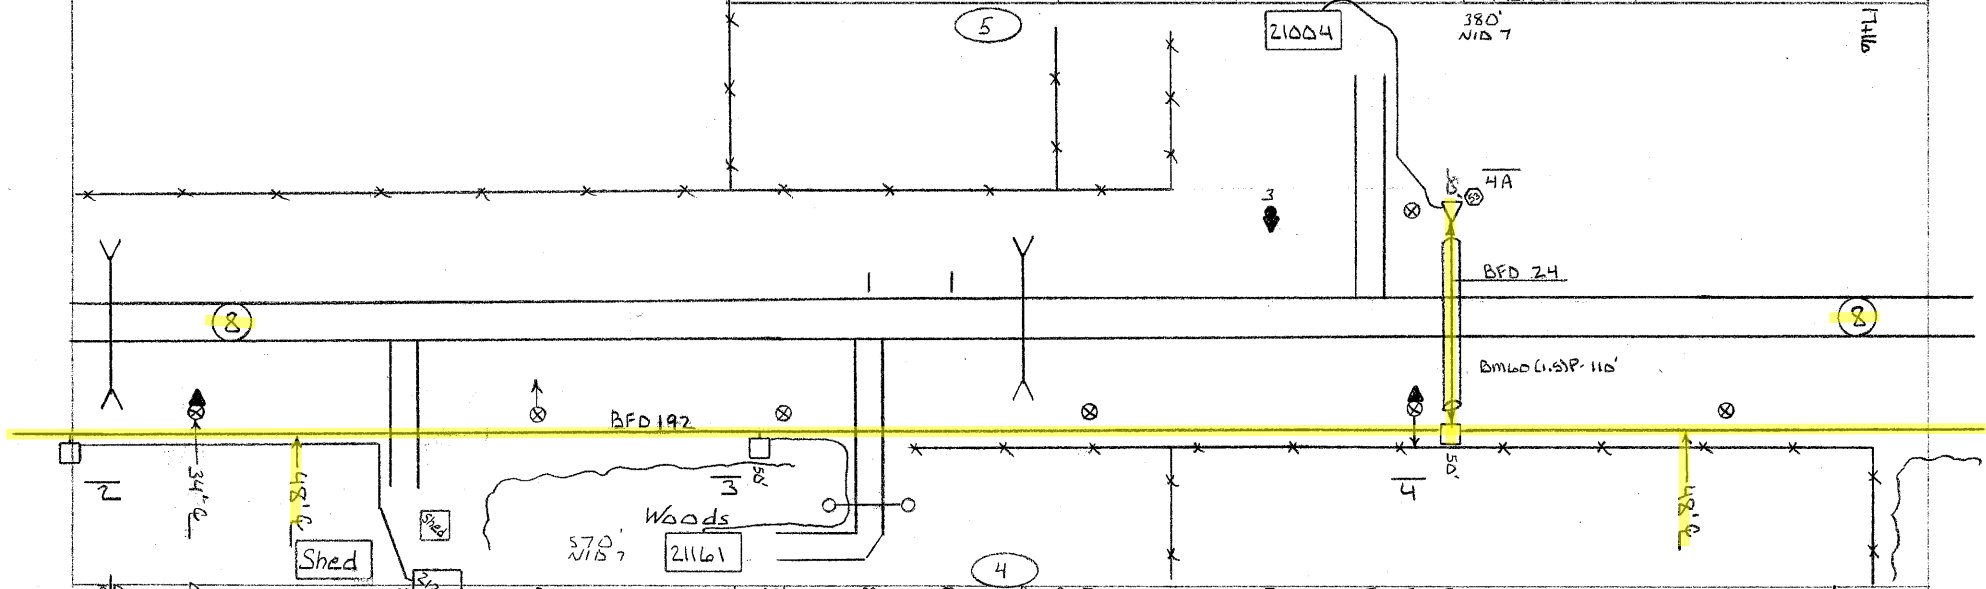

PED.	BA	BOO	BH	LD	BFO	SUB	SEB	NID	BM	HBF	H0	X2	XZ			
REP 2	2	4	372 x 60 x 360	(1x1) 5	24	192	NO. 4	7	21004 53 50 1120P	0 (192)	-1	BA	RD			
3	2		1	20		924	21161	570	1		1	1	1			
4			1			784			1		1	2	1			
4A	2	1		20	200		21004	380	1	1	1	1	1			
	4	1	2	40	200	1708		950	2	3	1	110	2	4	1	3

FORM CCI-103

DISTANCE FROM ROAD SEE NOTATION		BURIED PLANT STAKING SHEET & PLANT RECORD		SEC. <u>4</u> <u>5</u>	SHEET <u>4</u> OF <u>28</u>
STAKED BY <u>EJB</u>	DATE <u>3-8-10</u>	COMPANY <u>CTC</u>	TWP <u>41N</u>	RANGE <u>28W</u>	
REV.	REV.	PROJECT <u>MN537-2011</u>	RANGE <u>28W</u>	ROUTE <u>2C</u>	MAP REFERENCE
AS BUILT ENT. BY	DATE	EXCHANGE <u>Sullivan</u>	CO. <u>Morrison</u>		

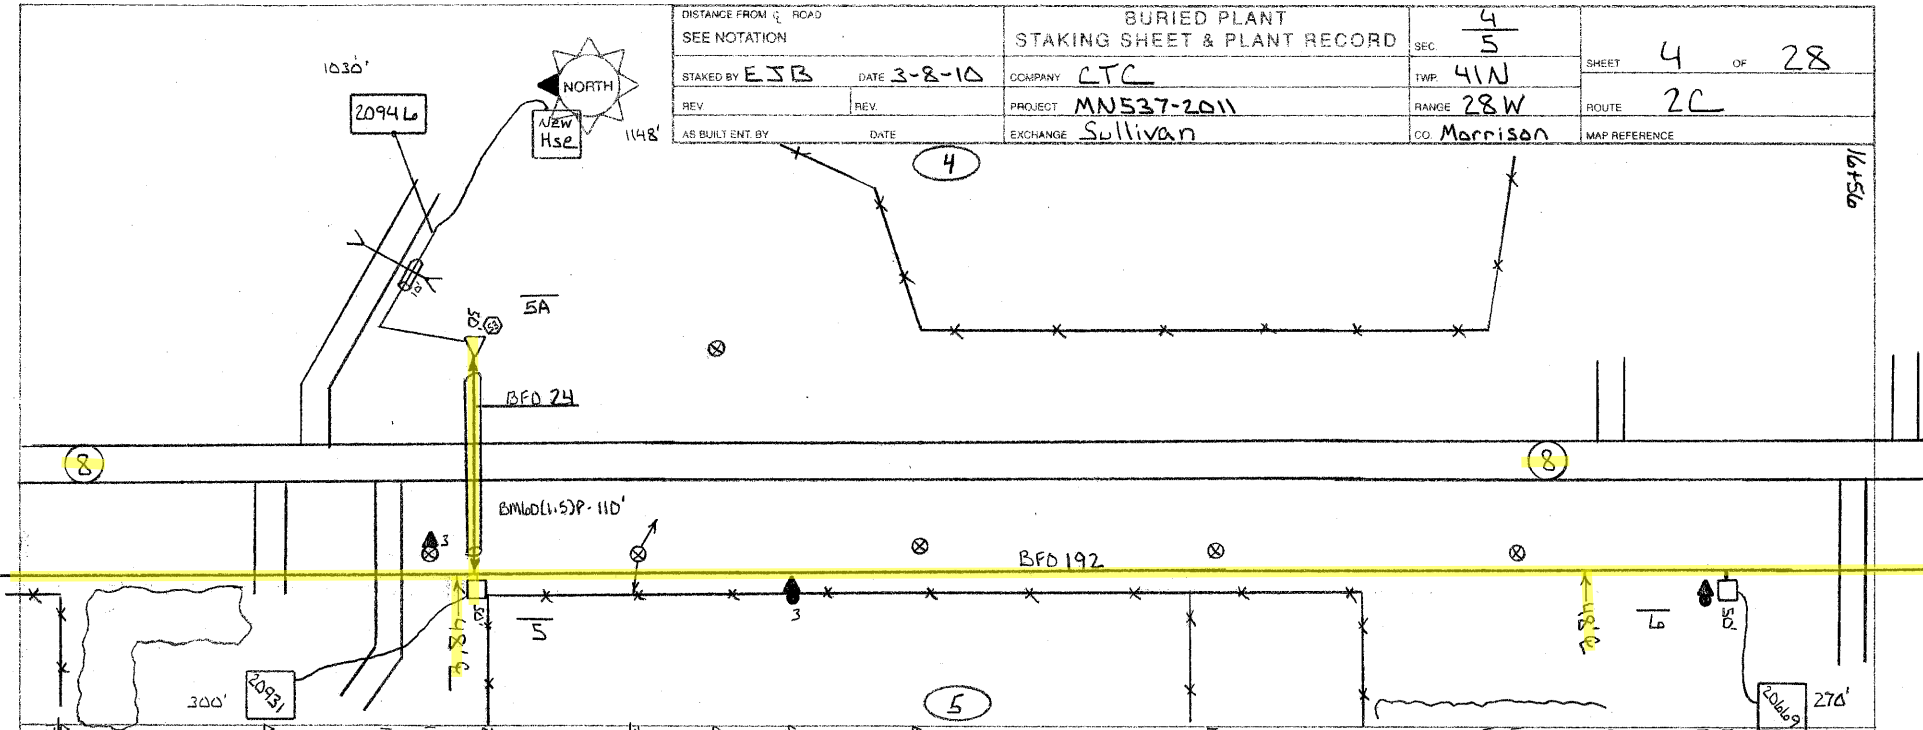


PED	BA	BDO	BH	BFO	SUB.	SEB	NID	BM	HBF	H	XZ	XZ
REF					NO.						BA	BB
4		4	F(36X60 X36) T	24	192		2094	53 (100' 3)	(192)	-1	BA	BB
5			1	646	20931	300	1		1	4		1
5A		1		200	20946	1030	1	1	110	10		2
					NEW HSE.	1149	1					
6			1	1480	20669	270	1	1		3	1	1
		1	2	200	2126		2748	4	3	1	110	10
									2	9	1	2

FORM CCI-103



DISTANCE FROM Q. ROAD SEE NOTATION		BURIED PLANT STAKING SHEET & PLANT RECORD		SEC. $\frac{4}{5}$	SHEET 5 OF 28
STAKED BY EJB	DATE 3-8-10	COMPANY CTC	TWP 41N	RANGE 28W	
REV.	REV.	PROJECT MNS37-2011	RANGE 28W	ROUTE 2C	MAP REFERENCE
AS BUILT ENT. BY	DATE	EXCHANGE Sullivan	CO. Morrison		

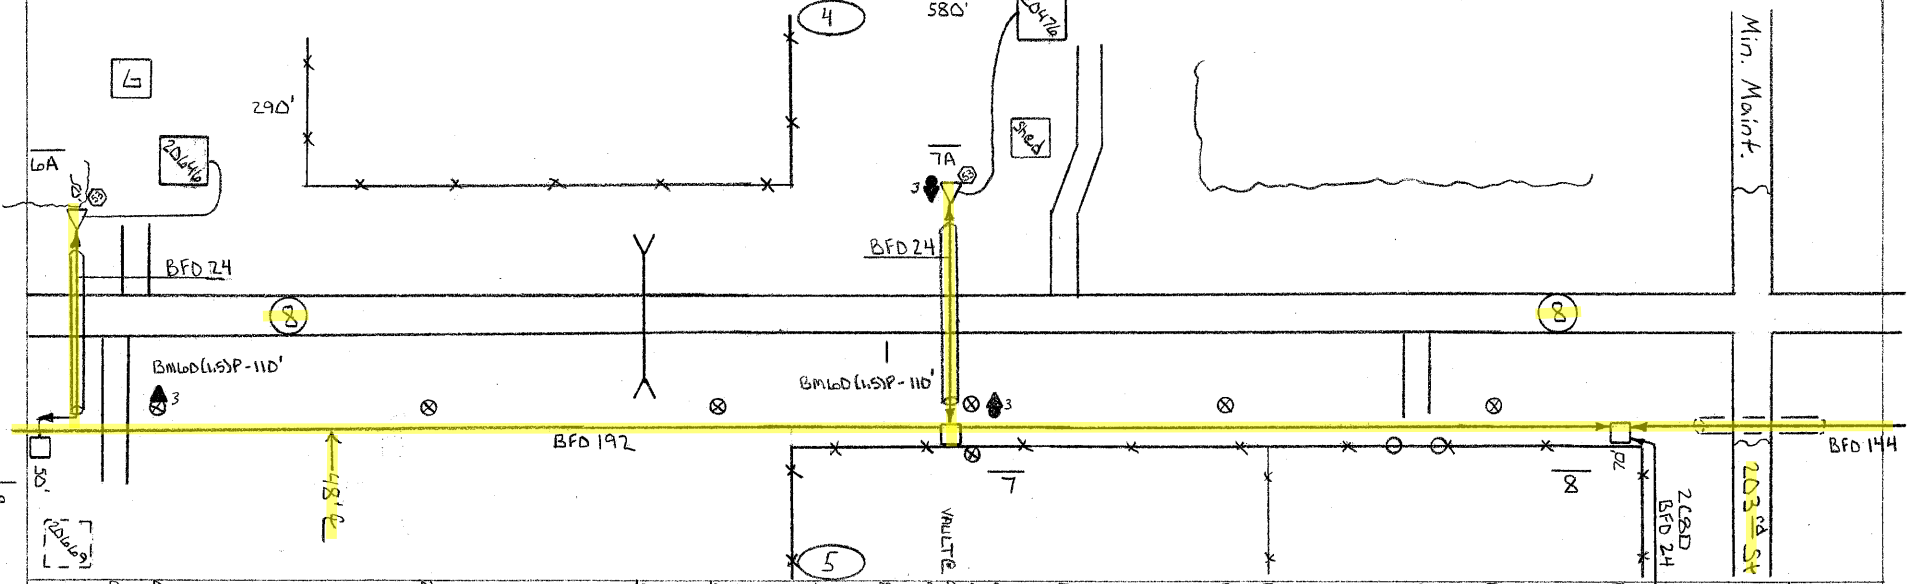


PED.	BA	BDO	BH	BFD	SUB.	SEB	NIB	BM	HIB	HOB	XZ	XZ
REF					NO.				(192)	-1	BA	BA
6A		4	FL 36X60 236	24	26646	290	1	53 116		1		
7				1040					1	2	1	2
7A		1		200	26476	580	1	110		1	1	1
8				1118					1	168		
		2	2	440	870	2		4 2 220	2	172	2	3

FORM CCI-103



DISTANCE FROM G ROAD SEE NOTATION		BURIED PLANT STAKING SHEET & PLANT RECORD		SEC. <u>9</u> <u>8</u>	SHEET <u>6</u> OF <u>28</u>
STAKED BY <u>ESB</u>	DATE <u>3-8-10</u>	COMPANY <u>CTC</u>	TWP <u>41N</u>	RANGE <u>28W</u>	
REV.	REV.	PROJECT <u>MN537-2011</u>	RANGE <u>28W</u>	ROUTE <u>2C</u>	
AS BUILT ENT. BY	DATE	EXCHANGE <u>Sullivan</u>	CD <u>Morrison</u>	MAP REFERENCE	

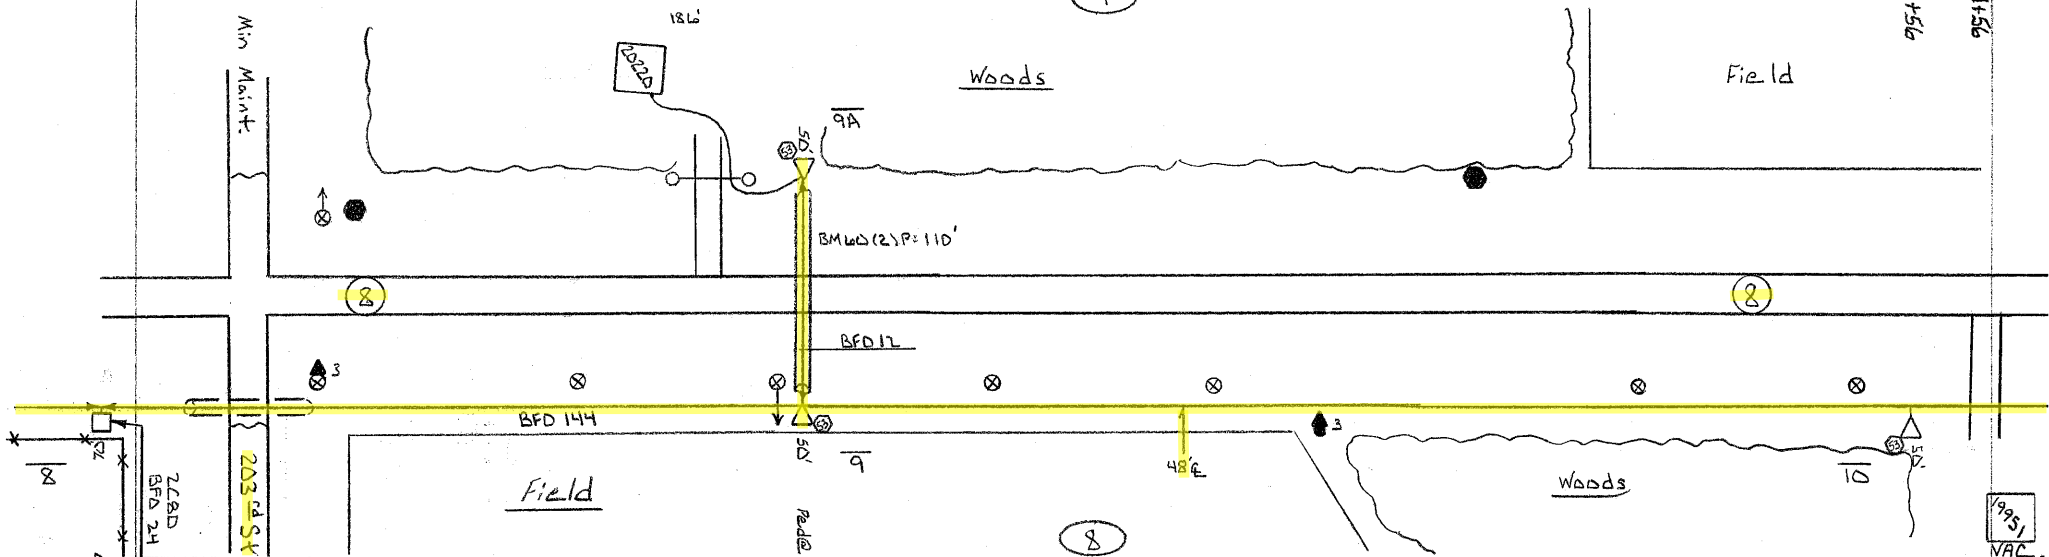

PED.	BA	BDO	BFD		SUB.	SEB	NID	BM			CONTRACT		
					NO.						H	XZ	XZ
80	4	5	24	144	4	2	2828	53	110		-1	BA	BD
9		1		800			1	1			2		1
9A	1		170		20220	186	1	1	118		1		
9B		1		1256			1	1				1	1
	1	2	170	2056		186	1	3	3	110	3	1	2

FORM CCI-103

DISTANCE FROM ROAD SEE NOTATION		BURIED PLANT STAKING SHEET & PLANT RECORD		SEC. $\frac{9}{8}$	SHEET 7 OF 28
STAKED BY ESB	DATE 3-8-10	COMPANY CTC	TWP. 41N	RANGE 28W	ROUTE 2C
REV.	REV.	PROJECT MN627-2011	CO MORRISON	MAP REFERENCE	
AS BUILT BY	DATE	EXCHANGE Sullivan			




Woods

9

Brush

25+82

Field

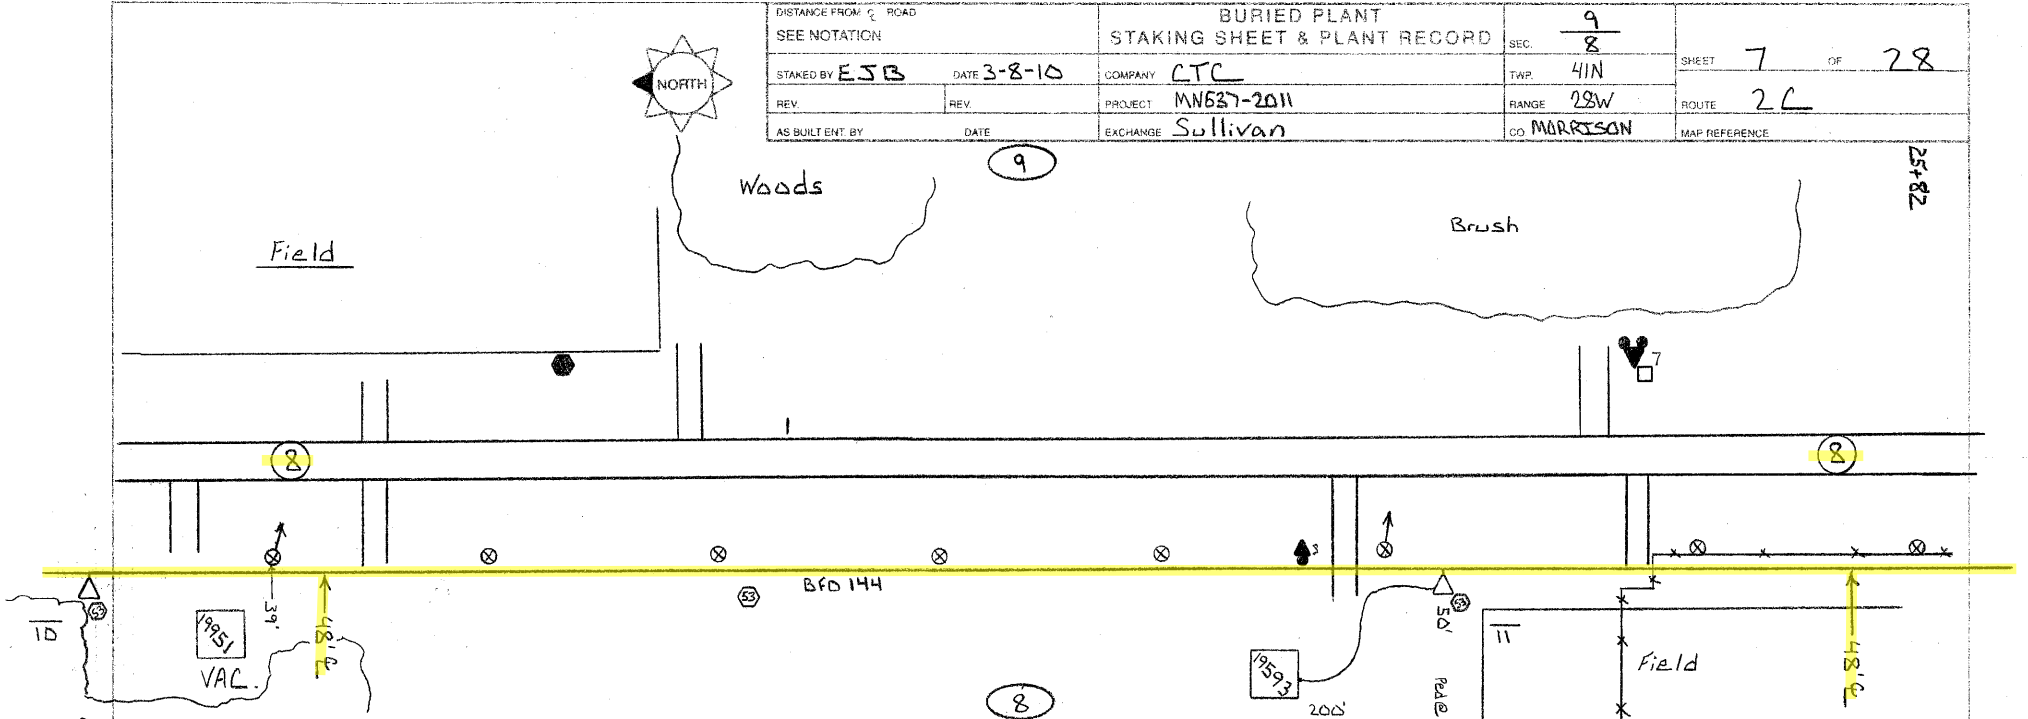


PED.	BA	BDO	BH	BFO	SUB.	SEB	NID	BM	W	XZ	HO	CONTRACT		
REF			F(30x48 x 3/16)T	144	NO.	4	2	2(1) 53	HBF D(17)	SA H	BDDT	-1	BA	BD
4		1		2674	19593	200	1	1 2				1	1	1
2B			1						1	2	1			
		1		2674		200	1	1 2	1	2	1	1	1	1

FORM CCI-103



DISTANCE FROM G ROAD SEE NOTATION		BURIED PLANT STAKING SHEET & PLANT RECORD		SEC 17	SHEET 8 OF 28
STAKED BY EJB	DATE 3-9-10	COMPANY CTC	TWP 41N	ROUTE 2C	
REV.	REV.	PROJECT MAJ537-2011	RANGE 28W	MAP REFERENCE	
AS BUILT BY	DATE	EXCHANGE Sullivan	CO. MORRISON		

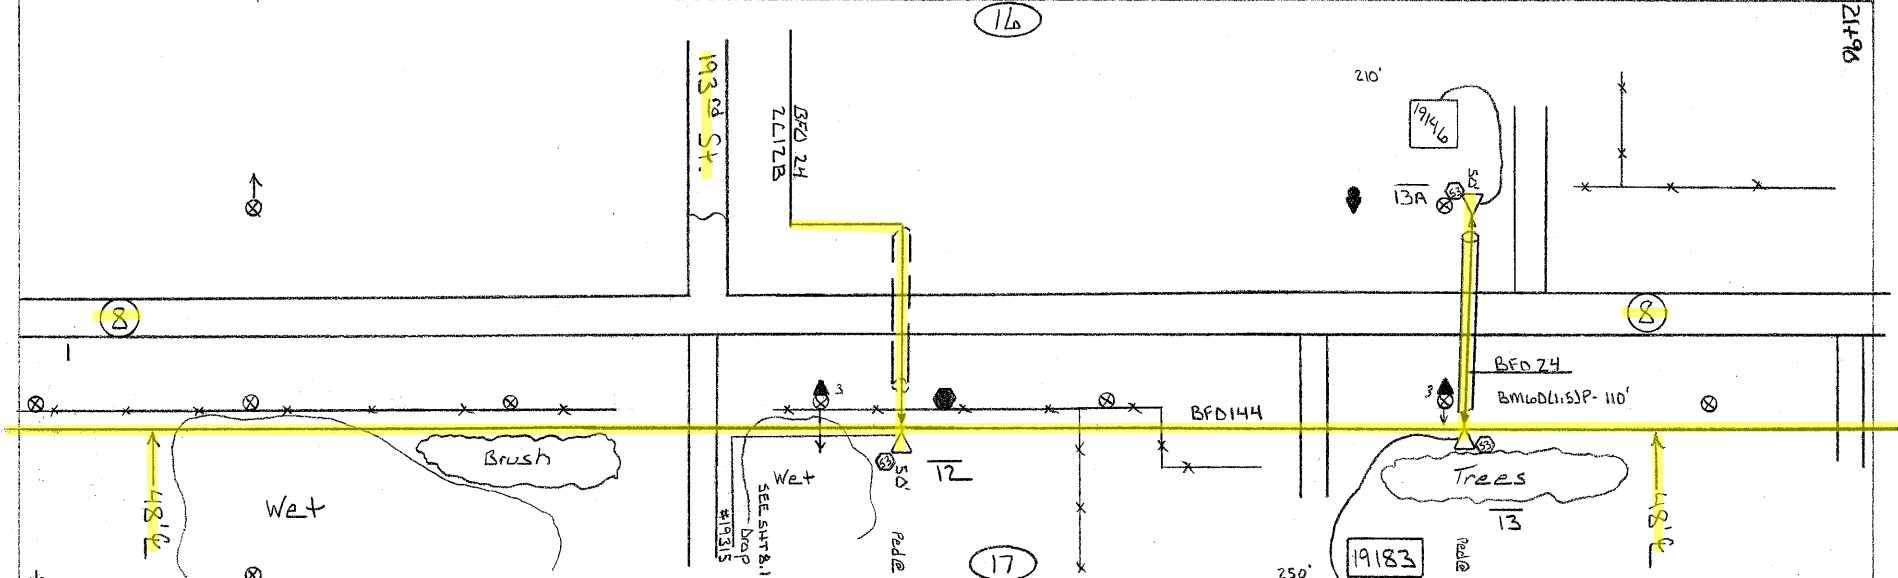

PED.	BA	BDO	BFO	SUB.	SEB	NIB	BM	H	CONTRACT
REF 11		4 5	24 144	NO. 4 2			218 153 110P	-1	BA BD
REF 12		1	1672	19315 1554	1		1 1	12	1
REF 13		1	762	19183 256	1		1 1	3	1
REF 13A	1		170	19146 210	1		1 1 110	1	1 1
	1 2		170 2434		2614 3		3 3 110	16	1 3


FORM CCI-103



DISTANCE FROM C ROAD SEE NOTATION		BURIED PLANT STAKING SHEET & PLANT RECORD		SEC. 17	SHEET 9 OF 28
STAKED BY EJB	DATE 3-9-10	COMPANY CTC	TWP 41N		
REV.	REV.	PROJECT MN537-2011	RANGE 28W	ROUTE 2C	
AS BUILT ENT. BY	DATE	EXCHANGE Sullivan	CO. MORRISON	MAP REFERENCE	

16

24790

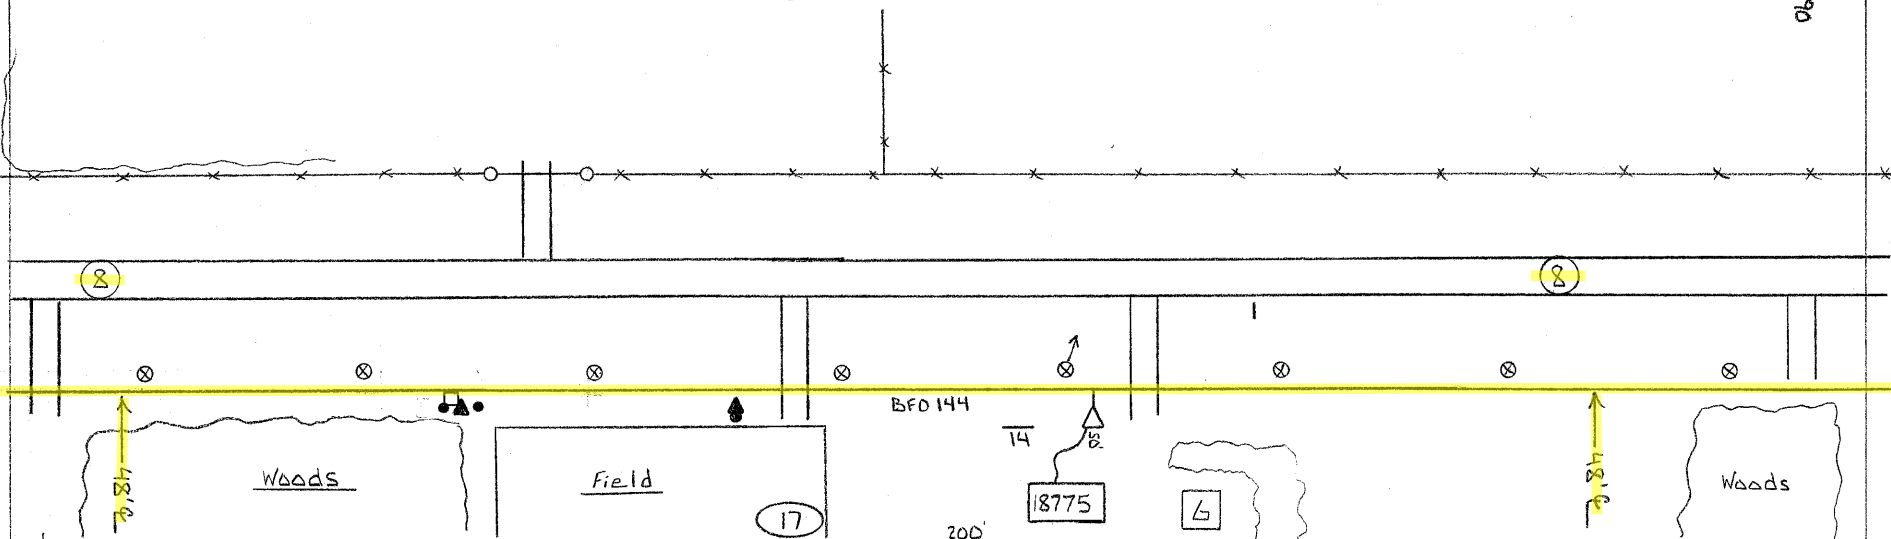


PED.	BA	BDO	BH	BFO	SUB.	SEB	ND	BM	W	XZ	H	XZ	XZ	CONTRACT
13		2	F(30x48) X36)T	144	NO.	4	2	2618 53	HESF D(12)	BA 4	BDO7	-1	BA	RD
14		1		2632	18775	200	1	1 2				1	1	1
2C										1	2	1		
		1		2632		200	1	1 2		1	2	1	1	1

FORM CCI-103



DISTANCE FROM G ROAD SEE NOTATION		BURIED PLANT STAKING SHEET & PLANT RECORD		SEC. 17	SHEET 10 OF 28
STAKED BY EJB	DATE 3-9-10	COMPANY CTC	TWP 41N	ROUTE 2C	
REV.	REV.	PROJECT MN537-2011	RANGE 28W	MAP REFERENCE	
AS BUILT ENT. BY	DATE	EXCHANGE Sullivan	CO MORRISON		

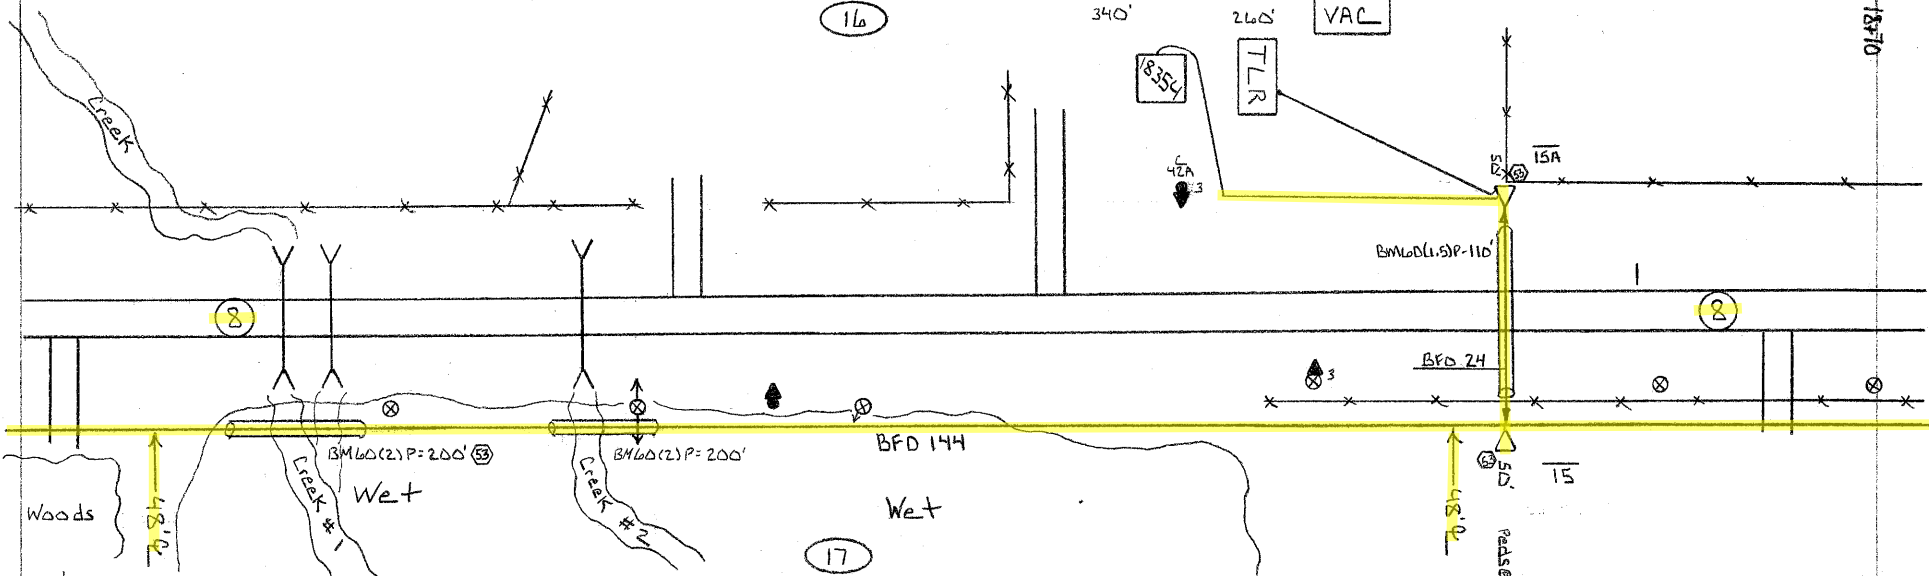


PED.	BA	BDO	BFO	UD	SUB.	SEB	NID	NIS	BM	CONTRACT	XZ					
14	2	1	24	144	(14-1)S	NO.	4	2	7	2(18) 53 (1/2)SP	-1	BA	BD			
15		1		2526						1	2	400	144	1	2	
15A	2	1		170		18354	340	1								
					20	TLR.	260		1		1	1	110	2	1	1
	2	1		170	2526	20	600	1	1		2	3	510	146	2	3

FORM CCI-103



DISTANCE FROM G ROAD SEE NOTATION		BURIED PLANT STAKING SHEET & PLANT RECORD			SEC. 20	SHEET 11 OF 28
STAKED BY EJB	DATE 3-9-10	COMPANY CTC	TWP 41N	RANGE 28W	ROUTE 2C	MAP REFERENCE
REV.	REV.	PROJECT MN537-2011	CO MORRISON			
AS BUILT ENT BY	DATE	EXCHANGE Sullivan				

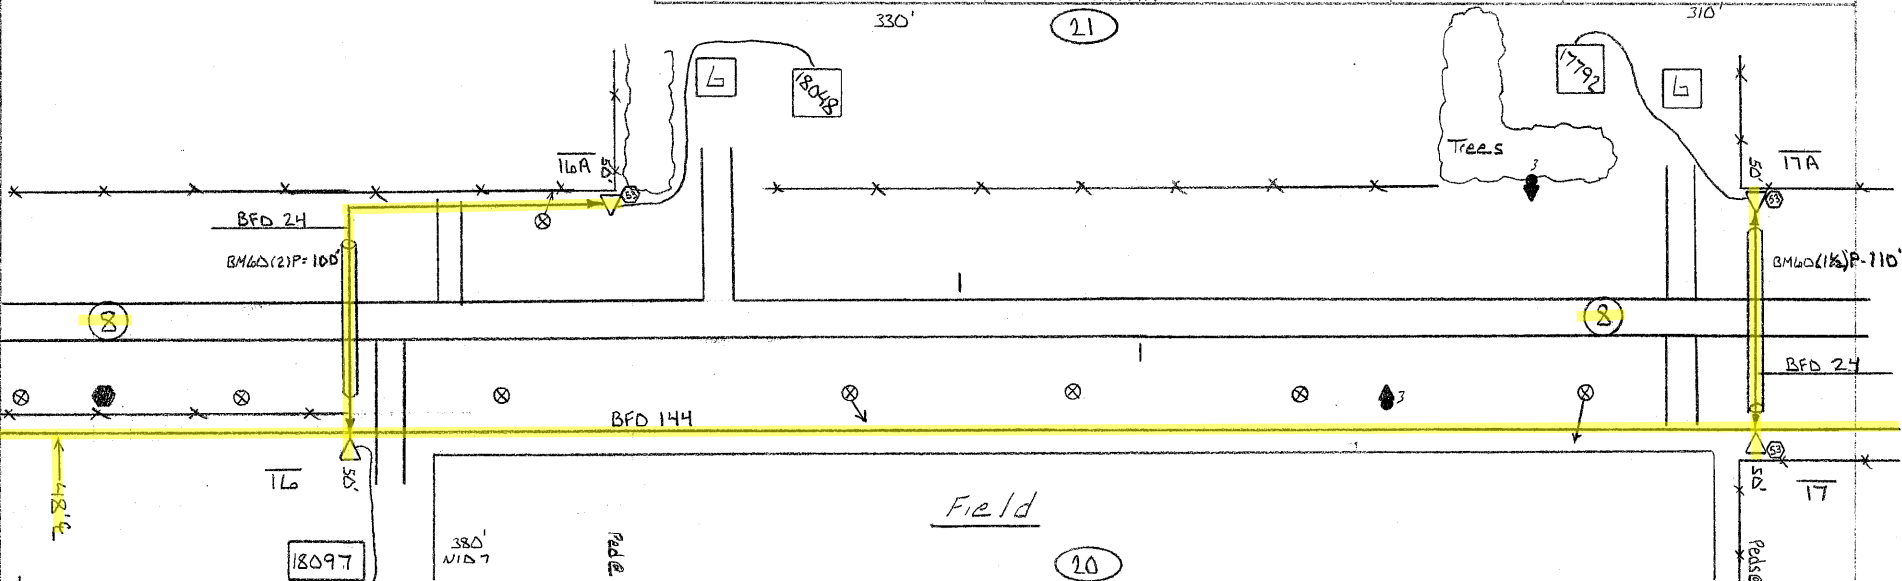


PED.	BA	BD	BFG	US	SUB.	SEB	NIP	NID	BM	CONTRACT					
15	2	4	5	24	144	(1x1)S	NO. 4	2	7	1	BA	BD			
16	2	1		1226	20	18097	380	1	1	1	3				
16A	1			378		18048	330	1	1	1	100	1			
17		1		1664					1	1		2	1	1	
17A	1			176		17792	310	1	1	1	110	1	1	1	
	2	2	2	548	2890	20	1020	2	1	4	4	210	7	2	2

FORM CCI-103




DISTANCE FROM Q ROAD SEE NOTATION		BURIED PLANT STAKING SHEET & PLANT RECORD		SEC. 20	SHEET 12 OF 28
STAKED BY EJB	DATE 3-9-10	COMPANY CTC	TWP. 41N	RANGE 28W	ROUTE 2C
REV.	REV.	PROJECT MN537-2011	CO. MORRISON	MAP REFERENCE	
AS BUILT BY	DATE	EXCHANGE Sullivan			

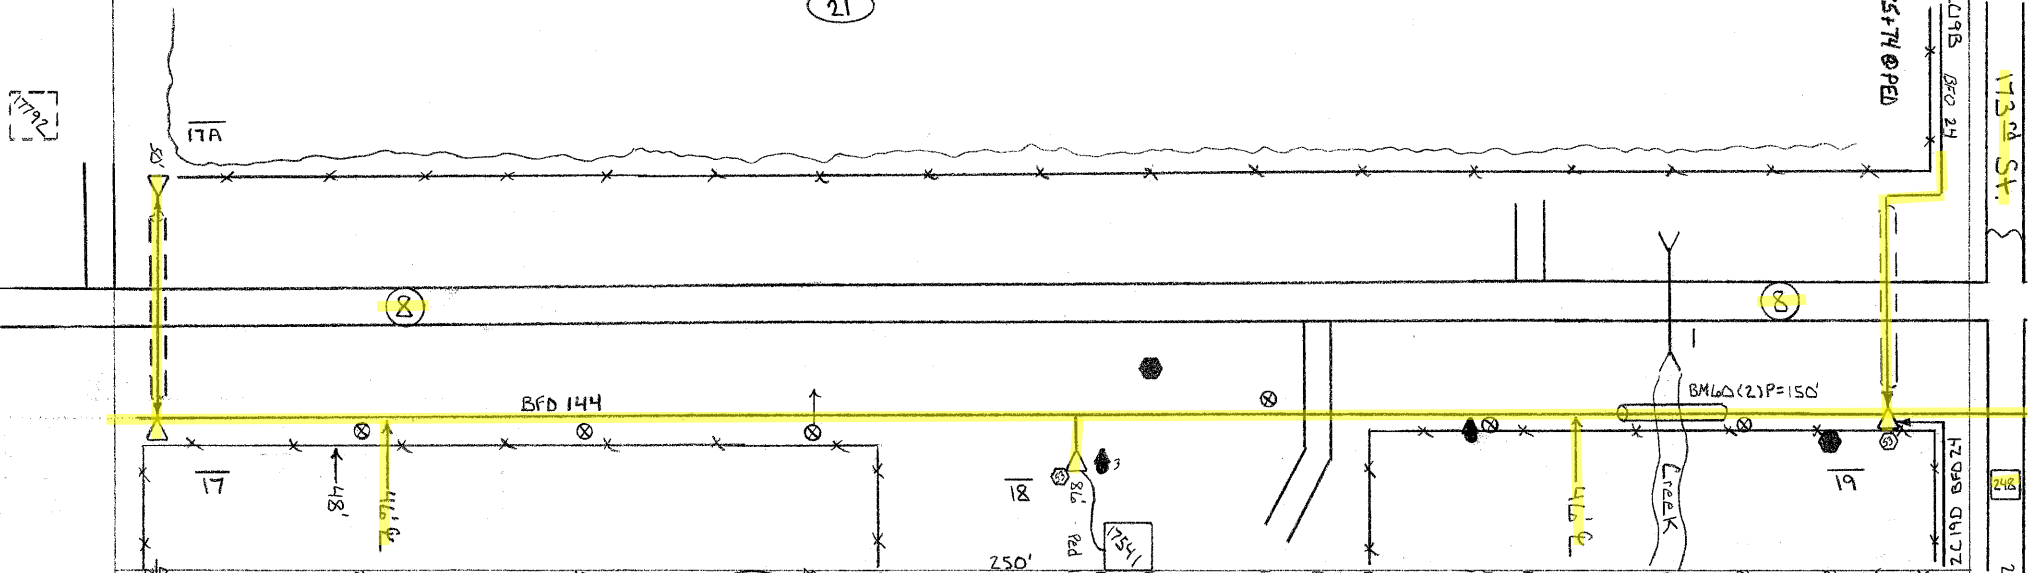

PED.	BA	BD	BFO	SUB.	SEB.	NID	BM	H3	XZ	XZ
REF 17		5	144	NO. 4	2		2(1/2) 53 (1/2) P	-1	BA	BD
18		1	1272	17641	250	1	1 1	1	1	1
19		1	1562				1 1 150	30	1	1
	2		2834		250	1	2 2 150	31	2	2


FORM CCI-103

DISTANCE FROM R ₂ ROAD SEE NOTATION		BURIED PLANT STAKING SHEET & PLANT RECORD		SEC. 29	SHEET 13 OF 28
STAKED BY EJB	DATE 3-9-10	COMPANY CTC	TWP. 41N	RANGE 28W	ROUTE 2C
REV.	REV.	PROJECT MNS37-2011	CO. MARTINSON	MAP REFERENCE	
AS BUILT ENT BY	DATE	EXCHANGE Sullivan			

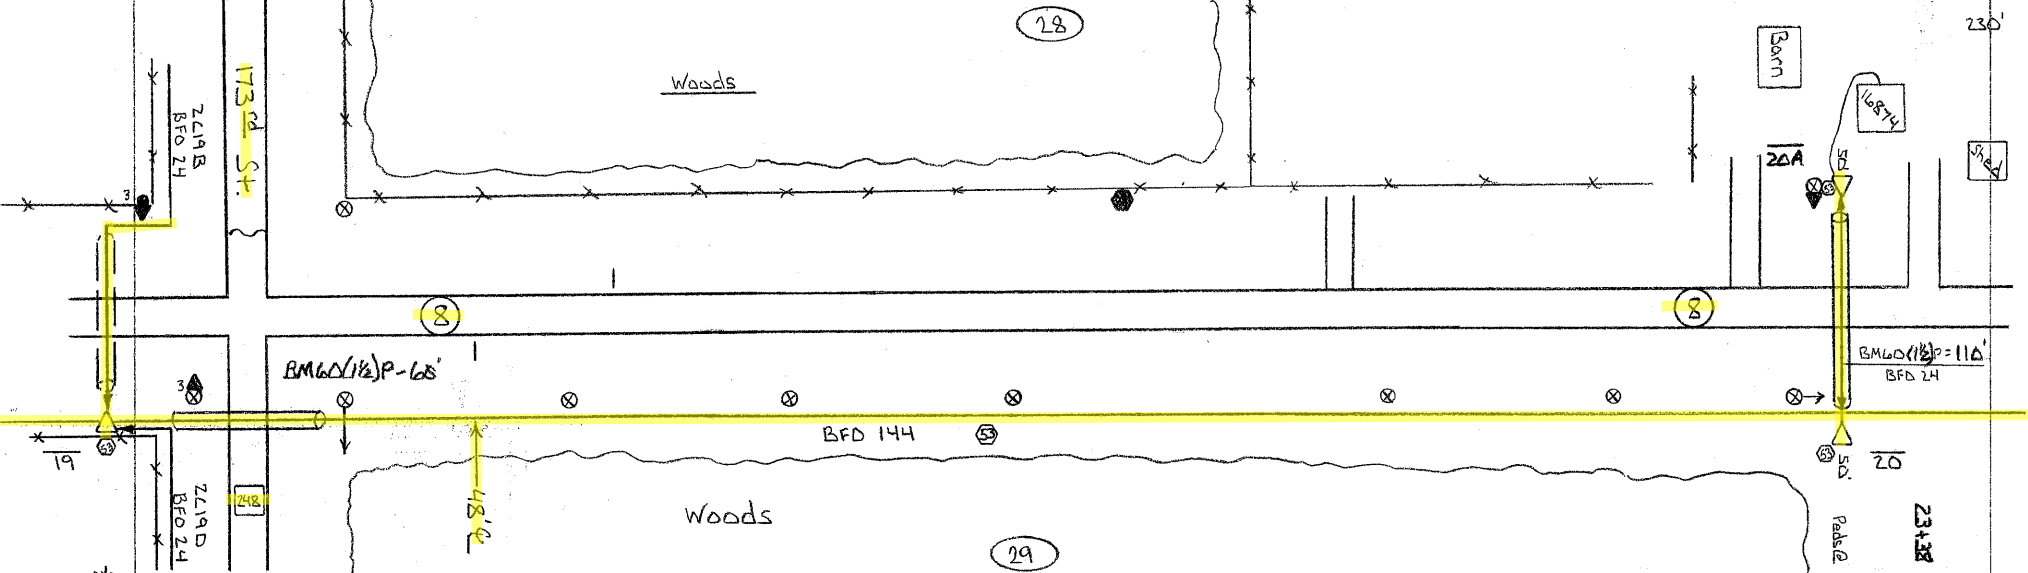


PED.	BA	BDA	BFO	SUB.	SEB	NLD	BM	HO	XZ	XZ
19	4	5	24 144	NO.	4	2	2219 B 53 11/2 P	-1	BA	BD
20		1	2340				1 2 60	2		1
26A	1		170	16874	230	1	1 1 110	1		1
	1	1	170 2340		230	1	2 3 176	3		2

FORM CCI-103

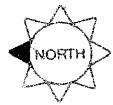


DISTANCE FROM \square ROAD		SEE NOTATION		BURIED PLANT STAKING SHEET & PLANT RECORD		SEC. 29	SHEET 14 OF 28
STAKED BY EJB	DATE 3-9-10	COMPANY CTC	TWP 41N	RANGE 28W	ROUTE 2C	MAP REFERENCE	
REV.	REV.	PROJECT MN537-2011	DO. MORRISON				
AS BUILT BY	DATE	EXCHANGE Sullivan					

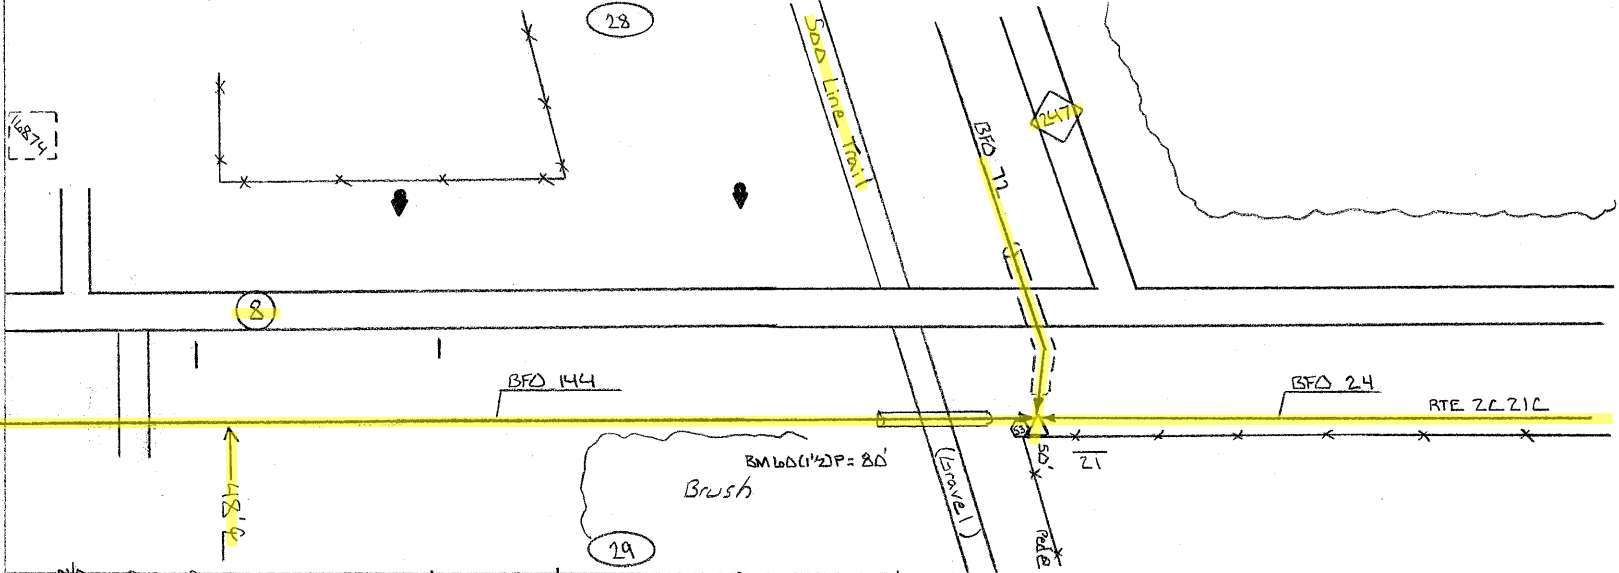

PED.	BA	BDO	BFO	SUB.	SEB	BM	HO	CONTRACT	
				NO.				X2	XZ
REF 20		5	144			2610 53	-1	BA	BD
21		1	854			80	84	2	2
		1	854			80	84	2	2




DISTANCE FROM G ROAD SEE NOTATION		BURIED PLANT STAKING SHEET & PLANT RECORD		SEC. 29	SHEET 1 OF 6
STAKED BY EJB	DATE 3-10-10	COMPANY CTL	TWP 41N		
REV.	REV.	PROJECT MN537-2011	RANGE 18W	ROUTE 2C21C	
AS BUILT BY	DATE	EXCHANGE Sullivan	CO. MORRISON	MAP REFERENCE	

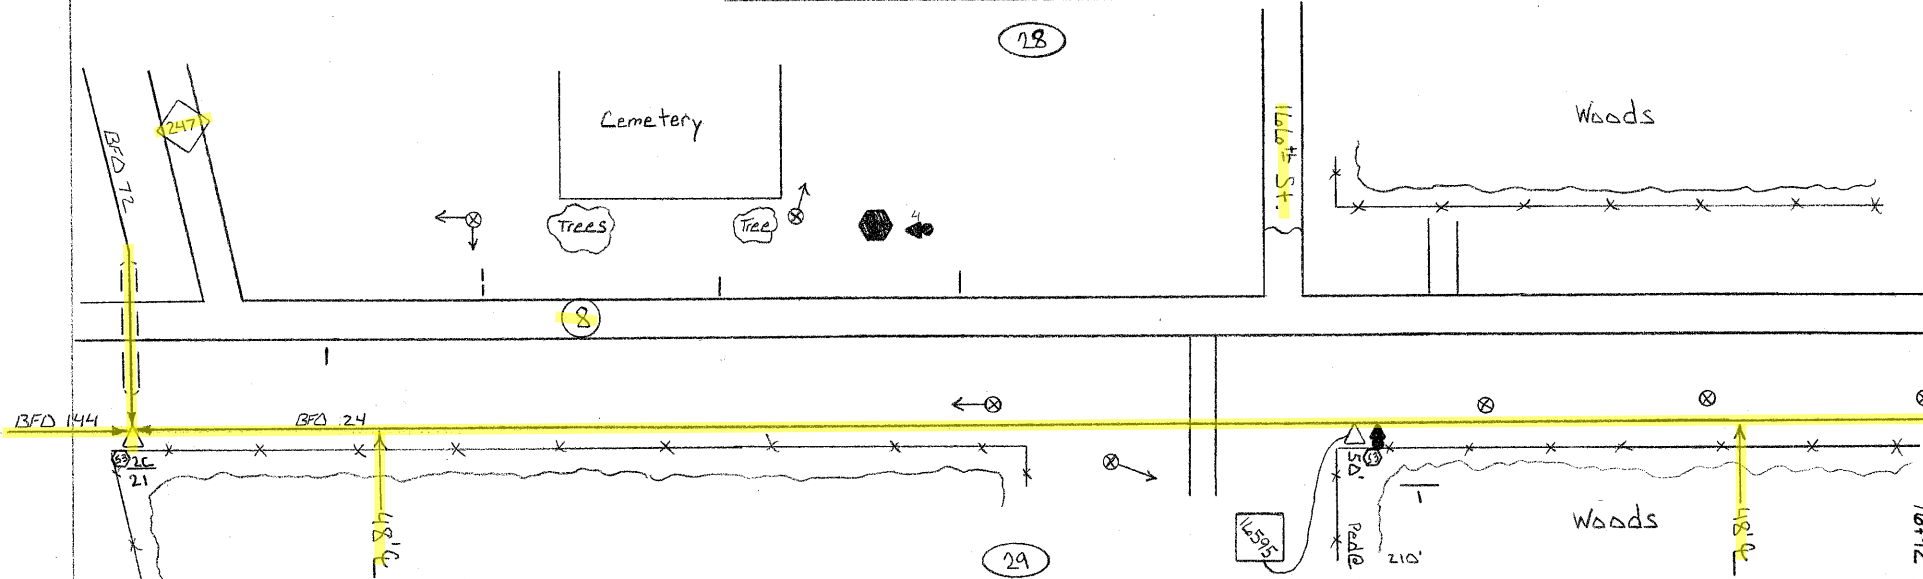

REF	PED.	BA	BD	BFO	SUB.	NO.	SEB	NID	BM	HOL	CONTRACT	
											BA	BD
			4	24		4	2		2/18	53	-1	
			1	1010	16595	210	1		1	1	1	2 2
			1	1010		210	1		1	1	1	2 2


DISTANCE FROM G ROAD		BURIED PLANT		28	33
SEE NOTATION		STAKING SHEET & PLANT RECORD		SEC. 29	32
STAKED BY EJB	DATE 3-10-10	COMPANY CTC	TWP 41N	SHEET 2 OF 6	
REV	REV	PROJECT MJ537-2011	RANGE 28W	ROUTE 2C21C	
AS BUILT ENT. BY	DATE	EXCHANGE Sullivan	CO. MORRISON	MAP REFERENCE	

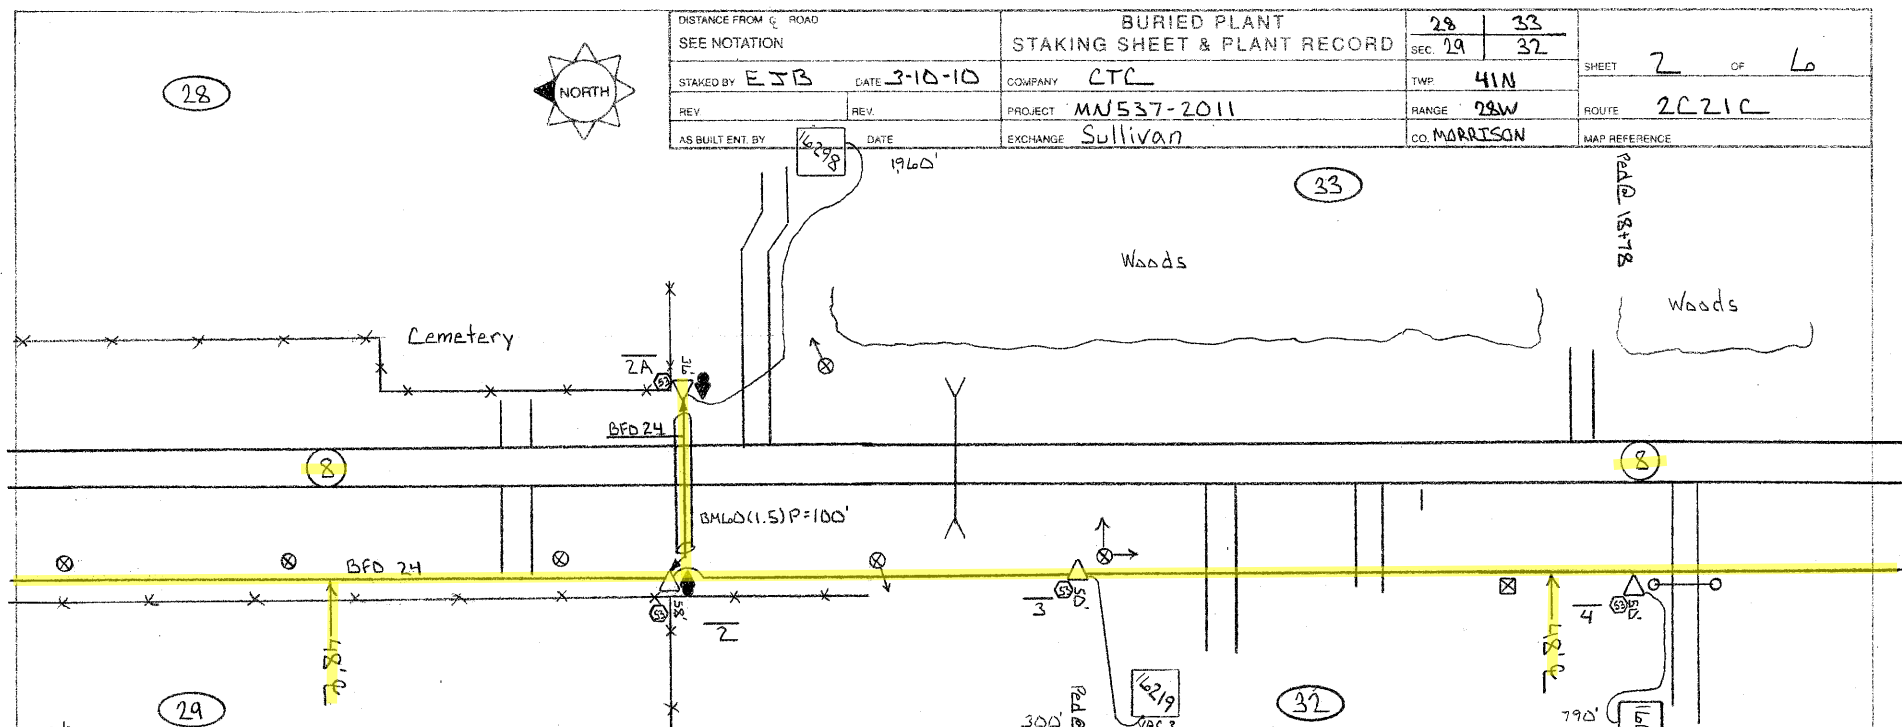

PED.	BA	BDD	BFO	SUB NO.	SEB	NID	BM	CONTRACT
REF 1		4	24	NO. 4	2		2858, 53, 1125 P	-1 BA BD
2		1	1476				1 1	2 1 1
2A		1	140	16298	1960	1	1 1 100	1 1 1
3		1	376	16219	300	1	1 1	1
4		1	948	16089	790	1	1 1	1
		4	2940		3050	3	4 4 100	5 2 2

FORM CCI-105

DISTANCE FROM G ROAD SEE NOTATION		BURIED PLANT STAKING SHEET & PLANT RECORD		SEC. 32	SHEET 3 OF 6
STAKED BY EJB	DATE 3-10-10	COMPANY LTC	TWP. 41N	ROUTE 2C21C	
REV.	REV.	PROJECT MN 537-2011	RANGE 28W	MAP REFERENCE	
AS BUILT ENT. BY	DATE	EXCHANGE Sullivan	CO. MORRISON		

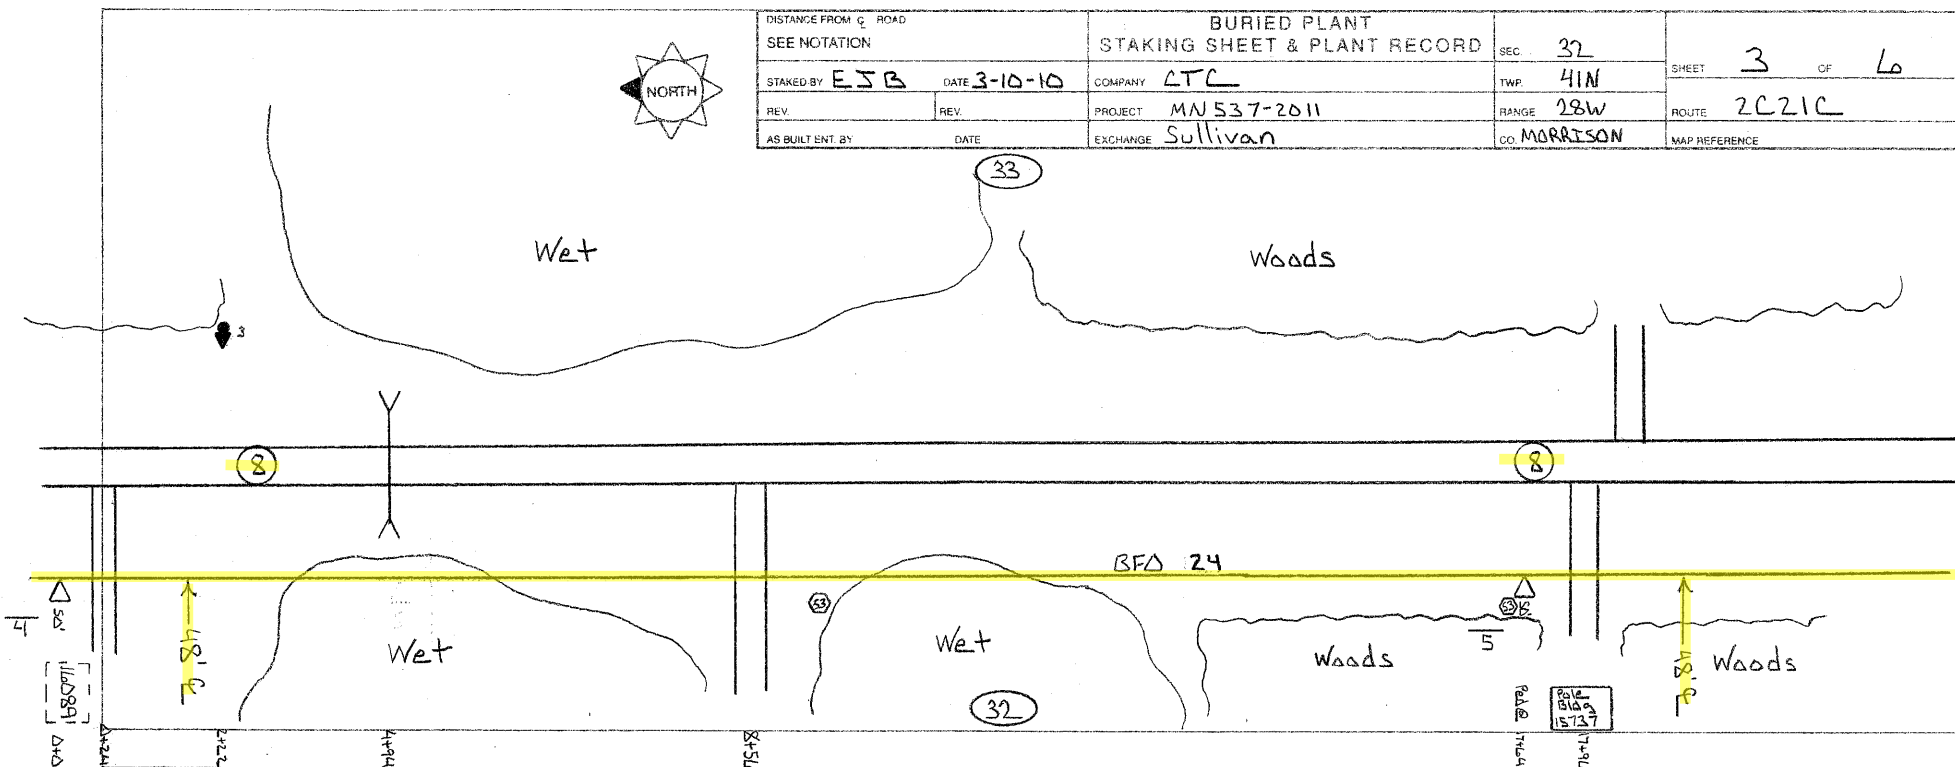


PED.	BA	BDD	BFO	SUB	SEB	BM	HQ
4		4	24	NO.		2(1) 53	-1
5		1	1824			1 2	LOOP
		1	1824			1 2	

FORM CCI-103



DISTANCE FROM C ROAD SEE NOTATION		BURIED PLANT STAKING SHEET & PLANT RECORD		SEC. 32	SHEET 4 OF 6
STAKED BY EJB	DATE 3-11-10	COMPANY LTC	TWP. 41N	ROUTE 2C21C	
REV.	REV.	PROJECT MNS37-2011	RANGE 25W	MAP REFERENCE	
AS BUILT ENT. BY	DATE	EXCHANGE Sullivan	CO MORRISON		

(33)

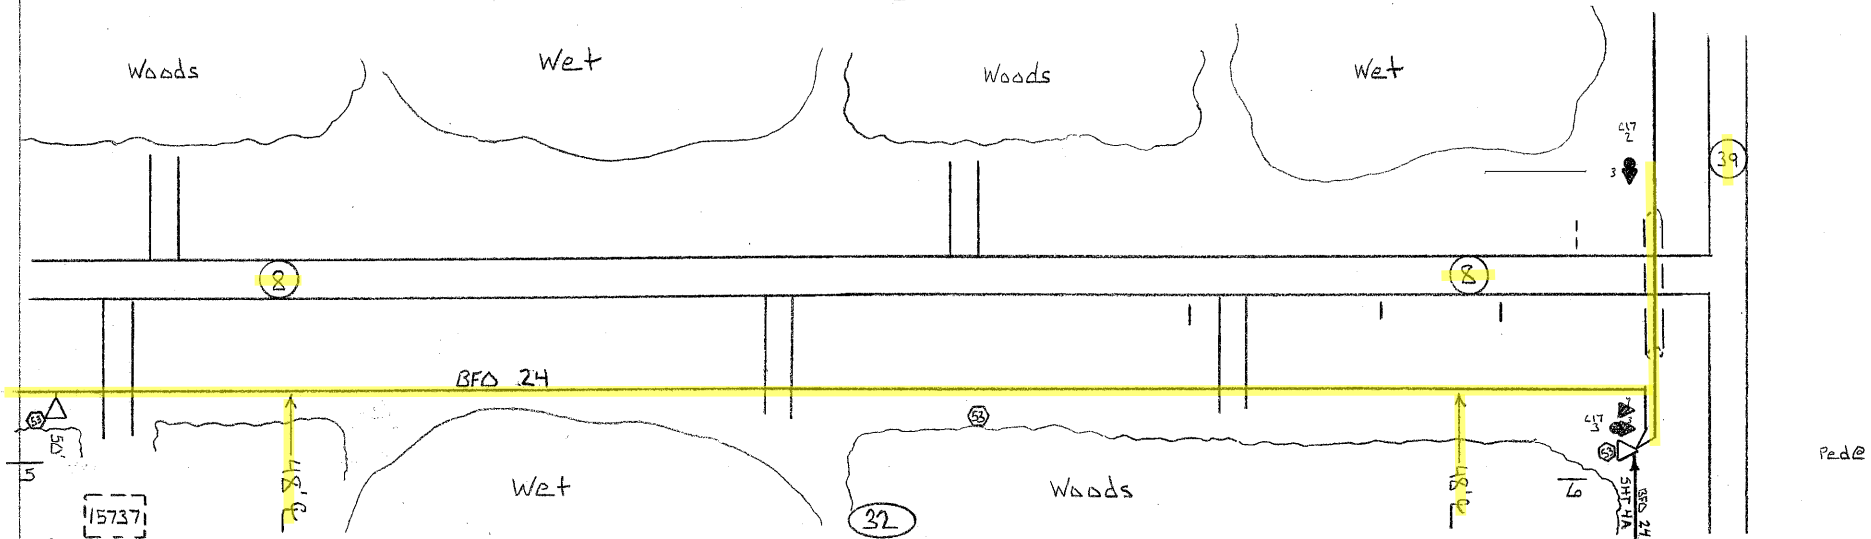

PED.	BA	BOD	BFO	SUB.	SEB	BM	HO	XZ	XZ
5		4	24	NO.		2(18) 53	-1	BA	BA
6			2306			1 2	3	1	2
		1	2306			1 2	3	1	2

FORM CCI-103

Soo Line Recreational Trail Morrison County T 41 N – R28 W – Sec – 29, 28



Proposed Route Highlighted in Yellow

Utility owner would be Consolidated
Telecommunications Company
New Fiber Optic Cable

