


ECE WO#
2010034474

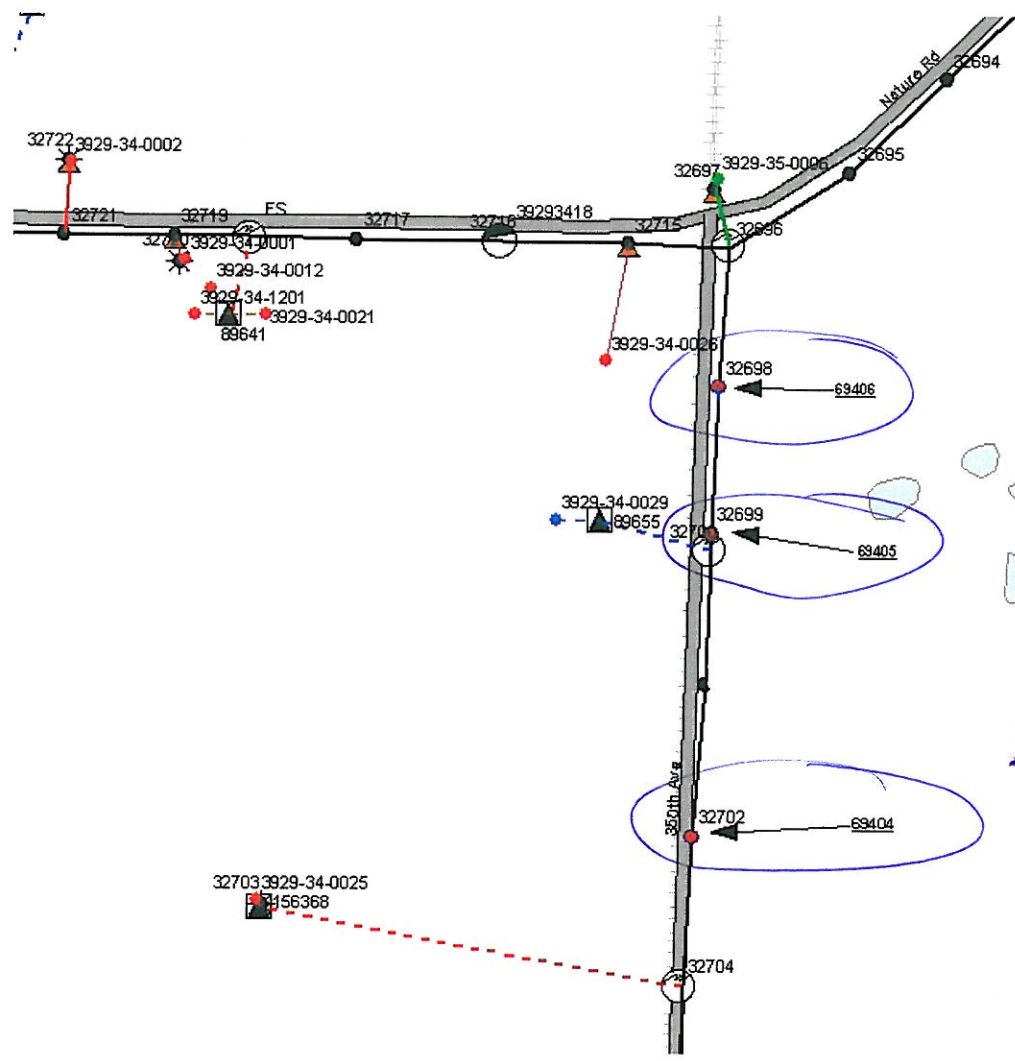

Change
3
poles

S- 35
T- 39 N
R- 29 W