

OOS

Qwest

BSW SKETCH FORM

RG41 - 0087

Revised 6/1/09

NPA / NNX (Wire Center): 320-632

Area Code 320
FAX TO : 1-877-410-2631

MO1100297


NECTAS # TIM

Date Submitted: 3-8-11

Install <input checked="" type="radio"/> Repair <input type="radio"/> Preprovisioning (Please Circle One of the Above) Job ID _____ TN <u>320-632-3140</u> 1. Held For BSW <input type="checkbox"/> 2. Held - cannot locate ENCAP <input type="checkbox"/> 3. OOS - Can not lay temp <input checked="" type="checkbox"/> 4. Held for F1-F2, also need BSW <input type="checkbox"/> 5. Temp Placed - (See Sketch Below) <input type="checkbox"/> 6. Found Temp - Same Job <input type="checkbox"/> - Other Location <input type="checkbox"/> 7. Add Line <input type="checkbox"/>	Customer Name: <u>James Houdek</u> Address: <u>10451 140th St</u> City: <u>Little Falls</u> 911 Address: _____ Phone: <u>320-632-3140</u> CBR: <u>320-632-3140</u> Hudson / King (circle one) _____ Year _____ County <u>Morrison</u> Section <u>27</u> Range <u>30W</u> Township <u>T125N</u> Quarter Section (Circle one) <u>NW</u> NE - SW - SE Submitted By _____ Name: <u>N. Jensen</u> EC: <u>310</u> Pgr/Cell: <u>320-333-3496</u> Supervisor: <u>Howard</u> Office #: <u>320-255-8575</u> Pager: <u>320255-8575</u> Customer was contacted: <input checked="" type="checkbox"/> I N <input checked="" type="checkbox"/> Verbal <input type="checkbox"/> Card
---	---

Terminal Address: 1064 CA 9437-27 PR 122 BP 7
 Cross Street: 100th Ave Total BSW Footage: 1500ft Type of Wire: 3pr (3pr/6pr)

L-INFO:	<u>L</u>	<u>F</u>	<u>S</u>	<u>7</u>	<u>C</u>	<u>A</u>	<u>3</u>	<u>5</u>	<u>P</u>	<u>c</u>
	LE	F,R,S	N,E,S,W	1-2-3-4-5-6-7	W,S,P,O,C	G,A,M,N	3/6	S,N	P,N	C

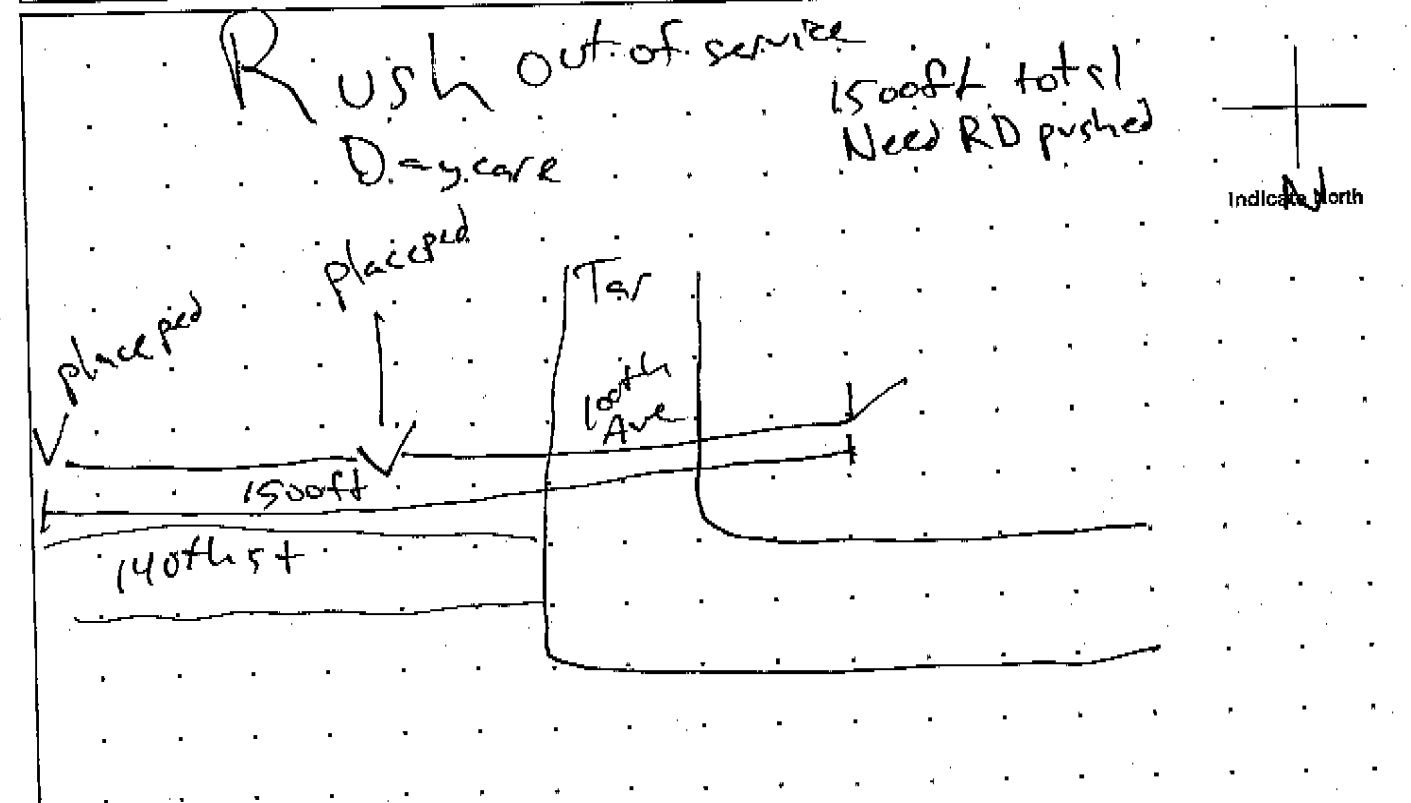

Any work in Right-of-Way requires a permit, fill out below

Distance of terminal to centerline 60ft Distance to nearest intersection 1500ft
 Distance of bury in Right-of-Way 1500ft Mile marker if State permit needed _____

Road Push Permit Required Hand Dig (Note: Hand Dig Must be 12")