


GENERAL LOCATION ONLY. DO NOT USE TO LOCATE FOR EXCAVATION. CALL 1-800-252-1166 FOR ONSITE LOCATIONS AND STAKING.

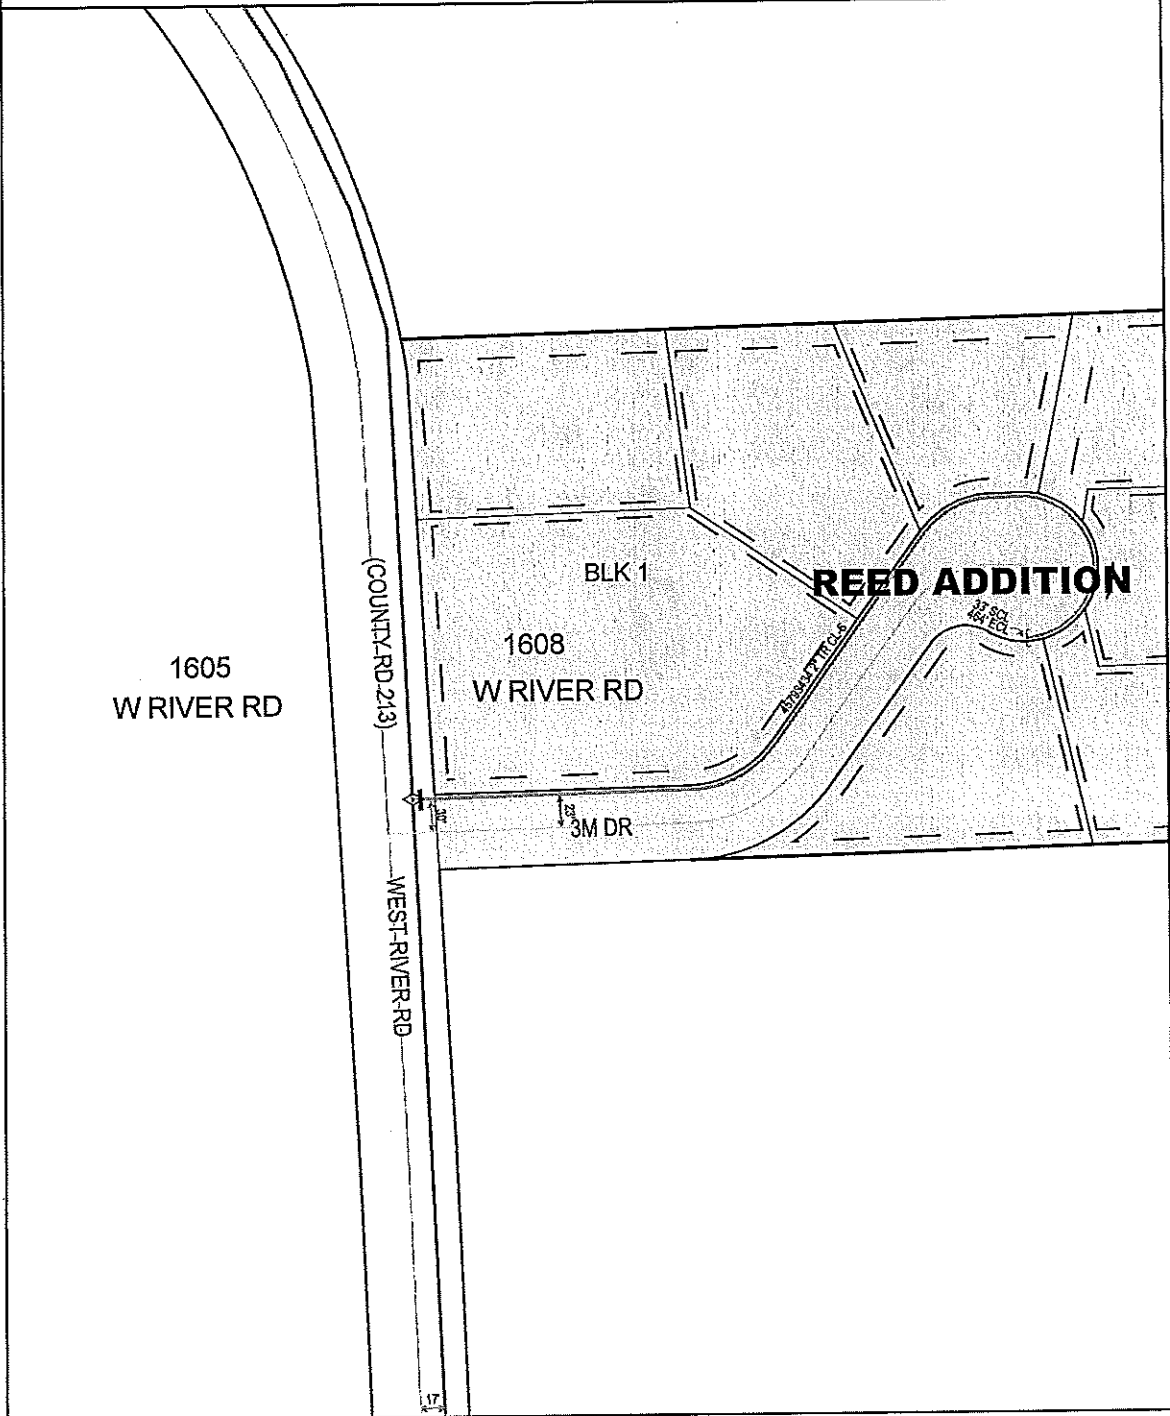

Plotted by: i216248  
Plot Date: 2/8/2010

1605 & 1608 WEST RIVER RD, LITTLE FALLS  
CENTERPOINT ENERGY

Scale: 1" : 100'  
North

1605 W Rvr Rd # 53114158  
1608 W Rvr Rd # 53114371